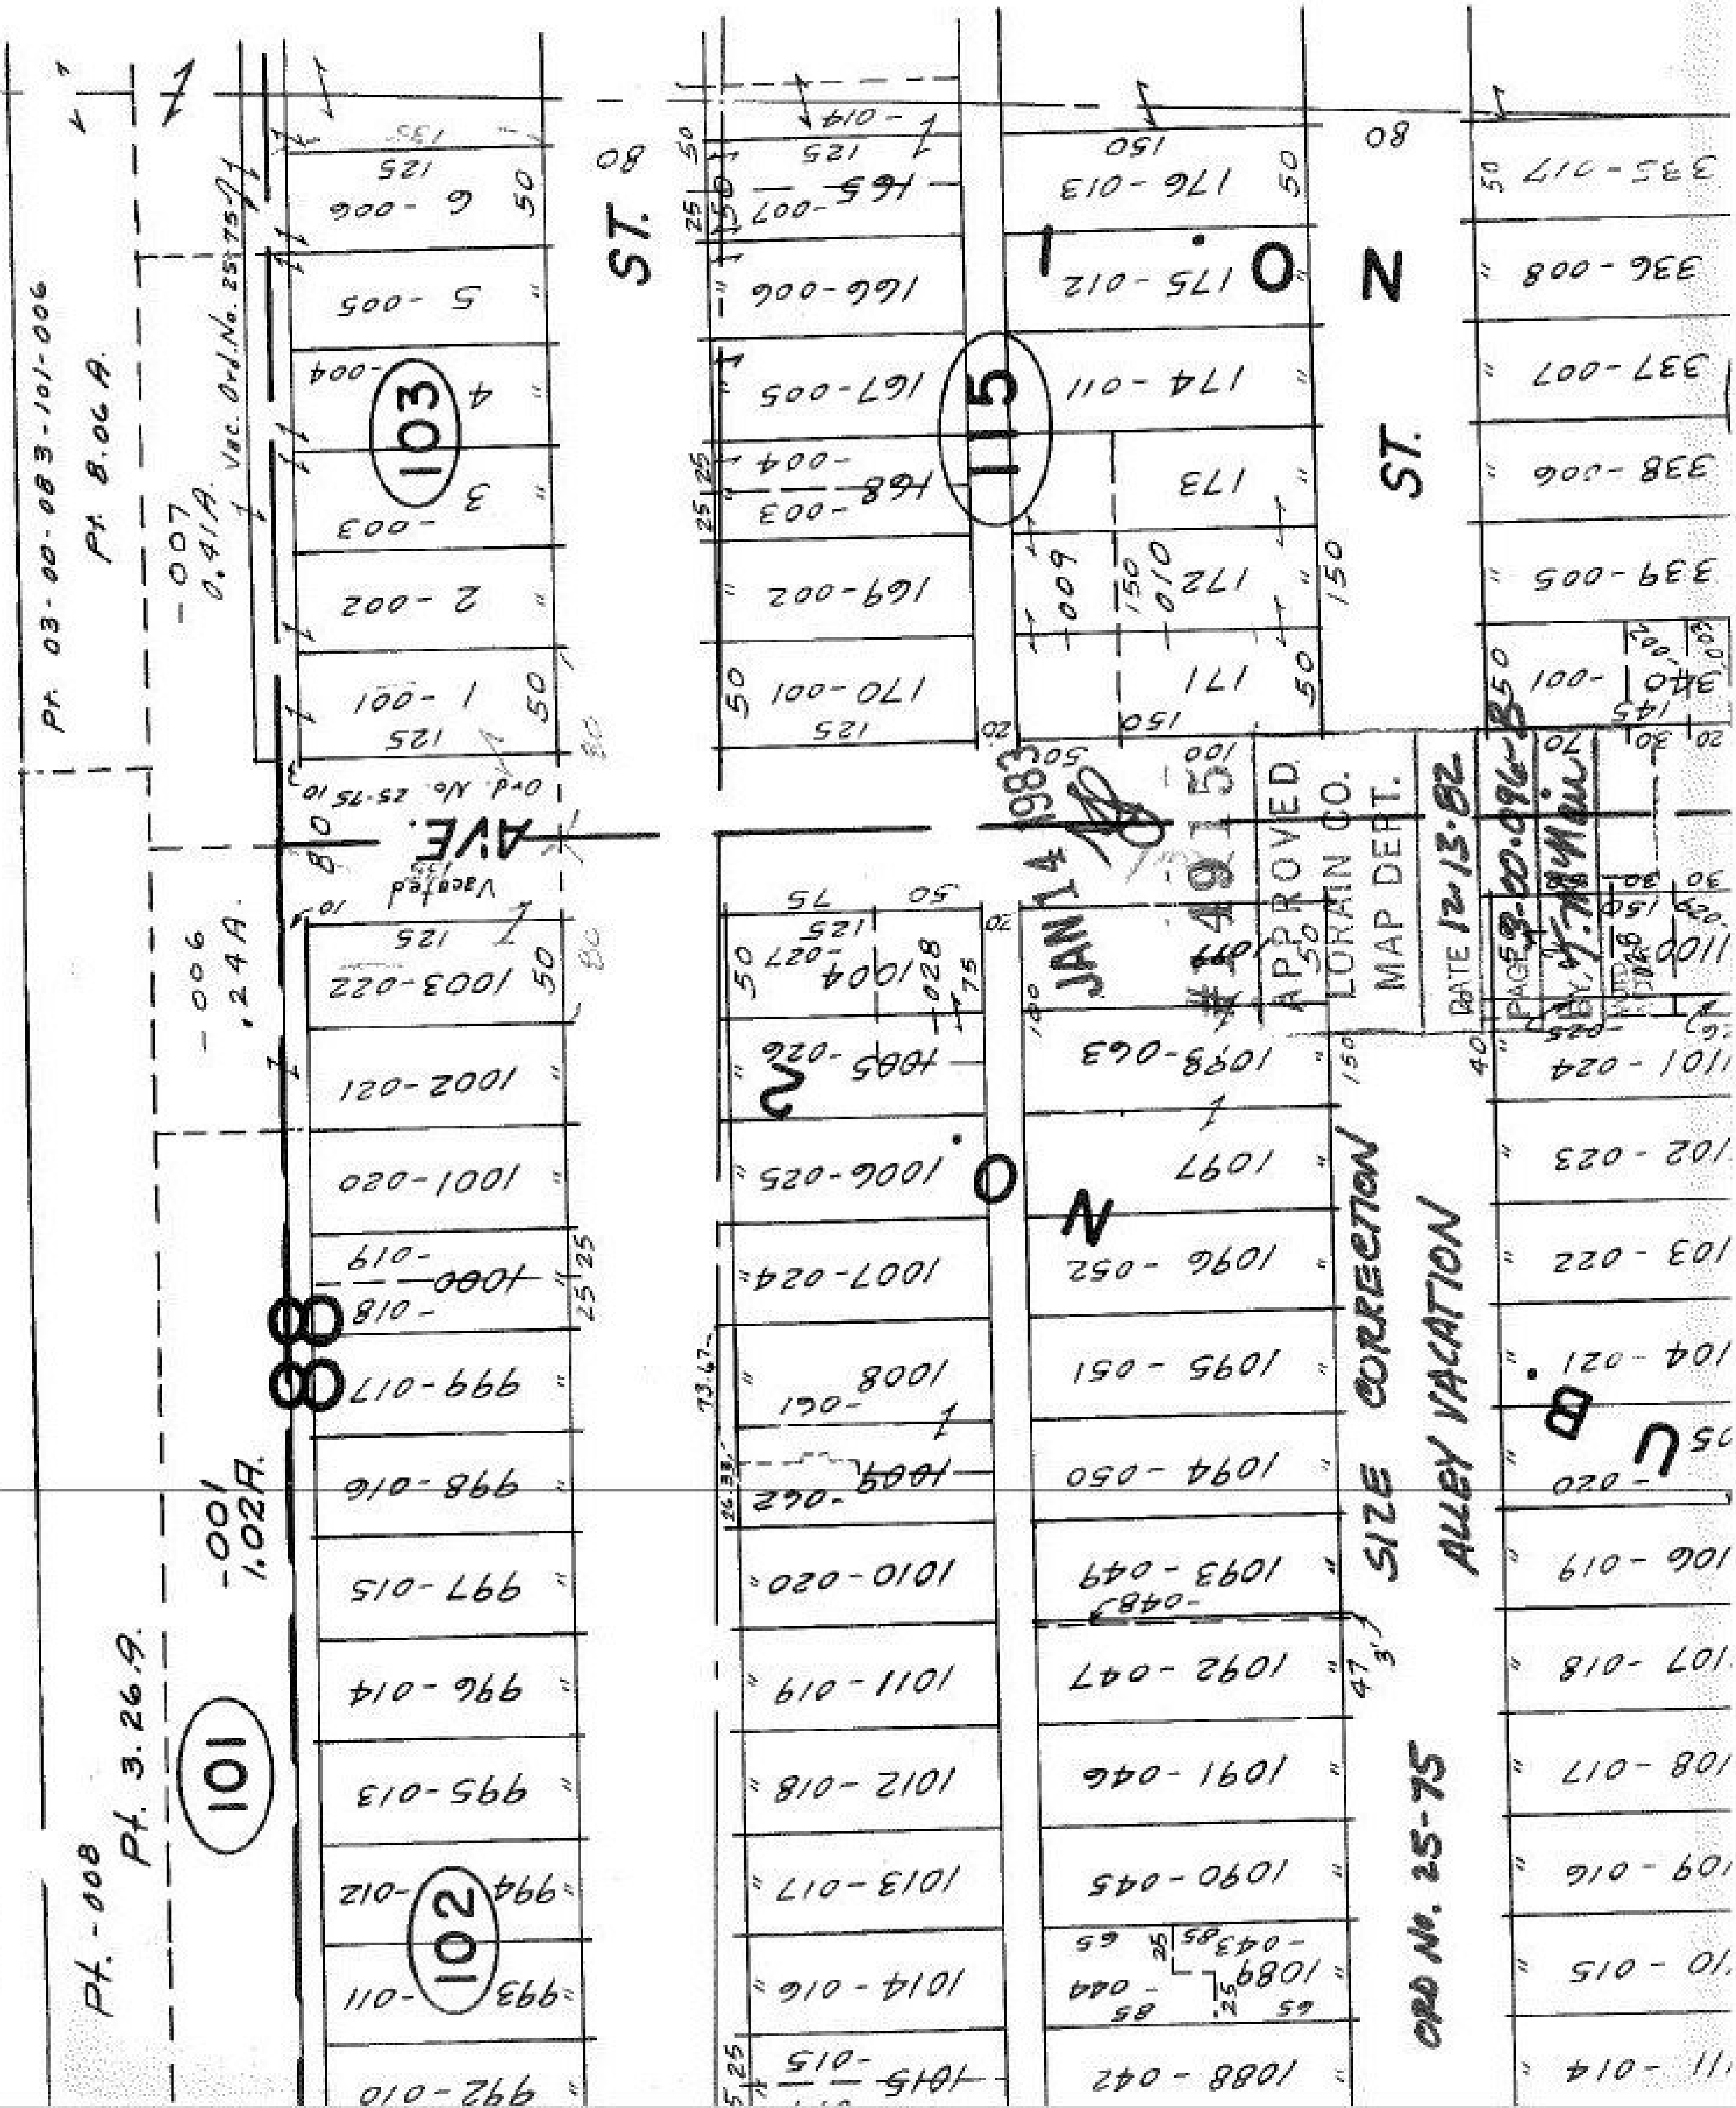
APPROVED
LORAIN CO.
MAP DEPT.
DATE 12-13-82
JAN 14 1983
SIZE CORRECTION
ALLEY VACATION
ORD No. 25-75
Vac. Ord. No. 25-75
Ord. No. 25-75
Vacated
ST.
AVE.
N ST.
Pt. 03-00-083-101-006
Pt. 8.06 A.
-007 0.41 A.
-006 .24 A.
-001 1.02 A.
Pt. 3.26 A.
Pt. -008
101
102
103
115
88
1 -001
2 -002
3 -003
4 -004
5 -005
6 -006
170-001
169-002
168-003
-004
167-005
166-006
165-007
-014
176-013
175-012
174-011
173
172
171
-009
-010
335-017
336-008
337-007
338-006
339-005
340-001
1003-022
1002-021
1001-020
1000
-019
-018
999-017
998-016
997-015
996-014
995-013
994-012
993-011
992-010
1004
-027
-028
1005-026
1006-025
1007-024
1008
-061
1009
-062
1010-020
1011-019
1012-018
1013-017
1014-016
1015
-015
1098-063
1097
1096-052
1095-051
1094-050
1093-049
-048
1092-047
1091-046
1090-045
1089
-043
-044
1088-042
1100
1101-024
102-023
103-022
104-021
-020
106-019
107-018
108-017
109-016
10-015
11-014