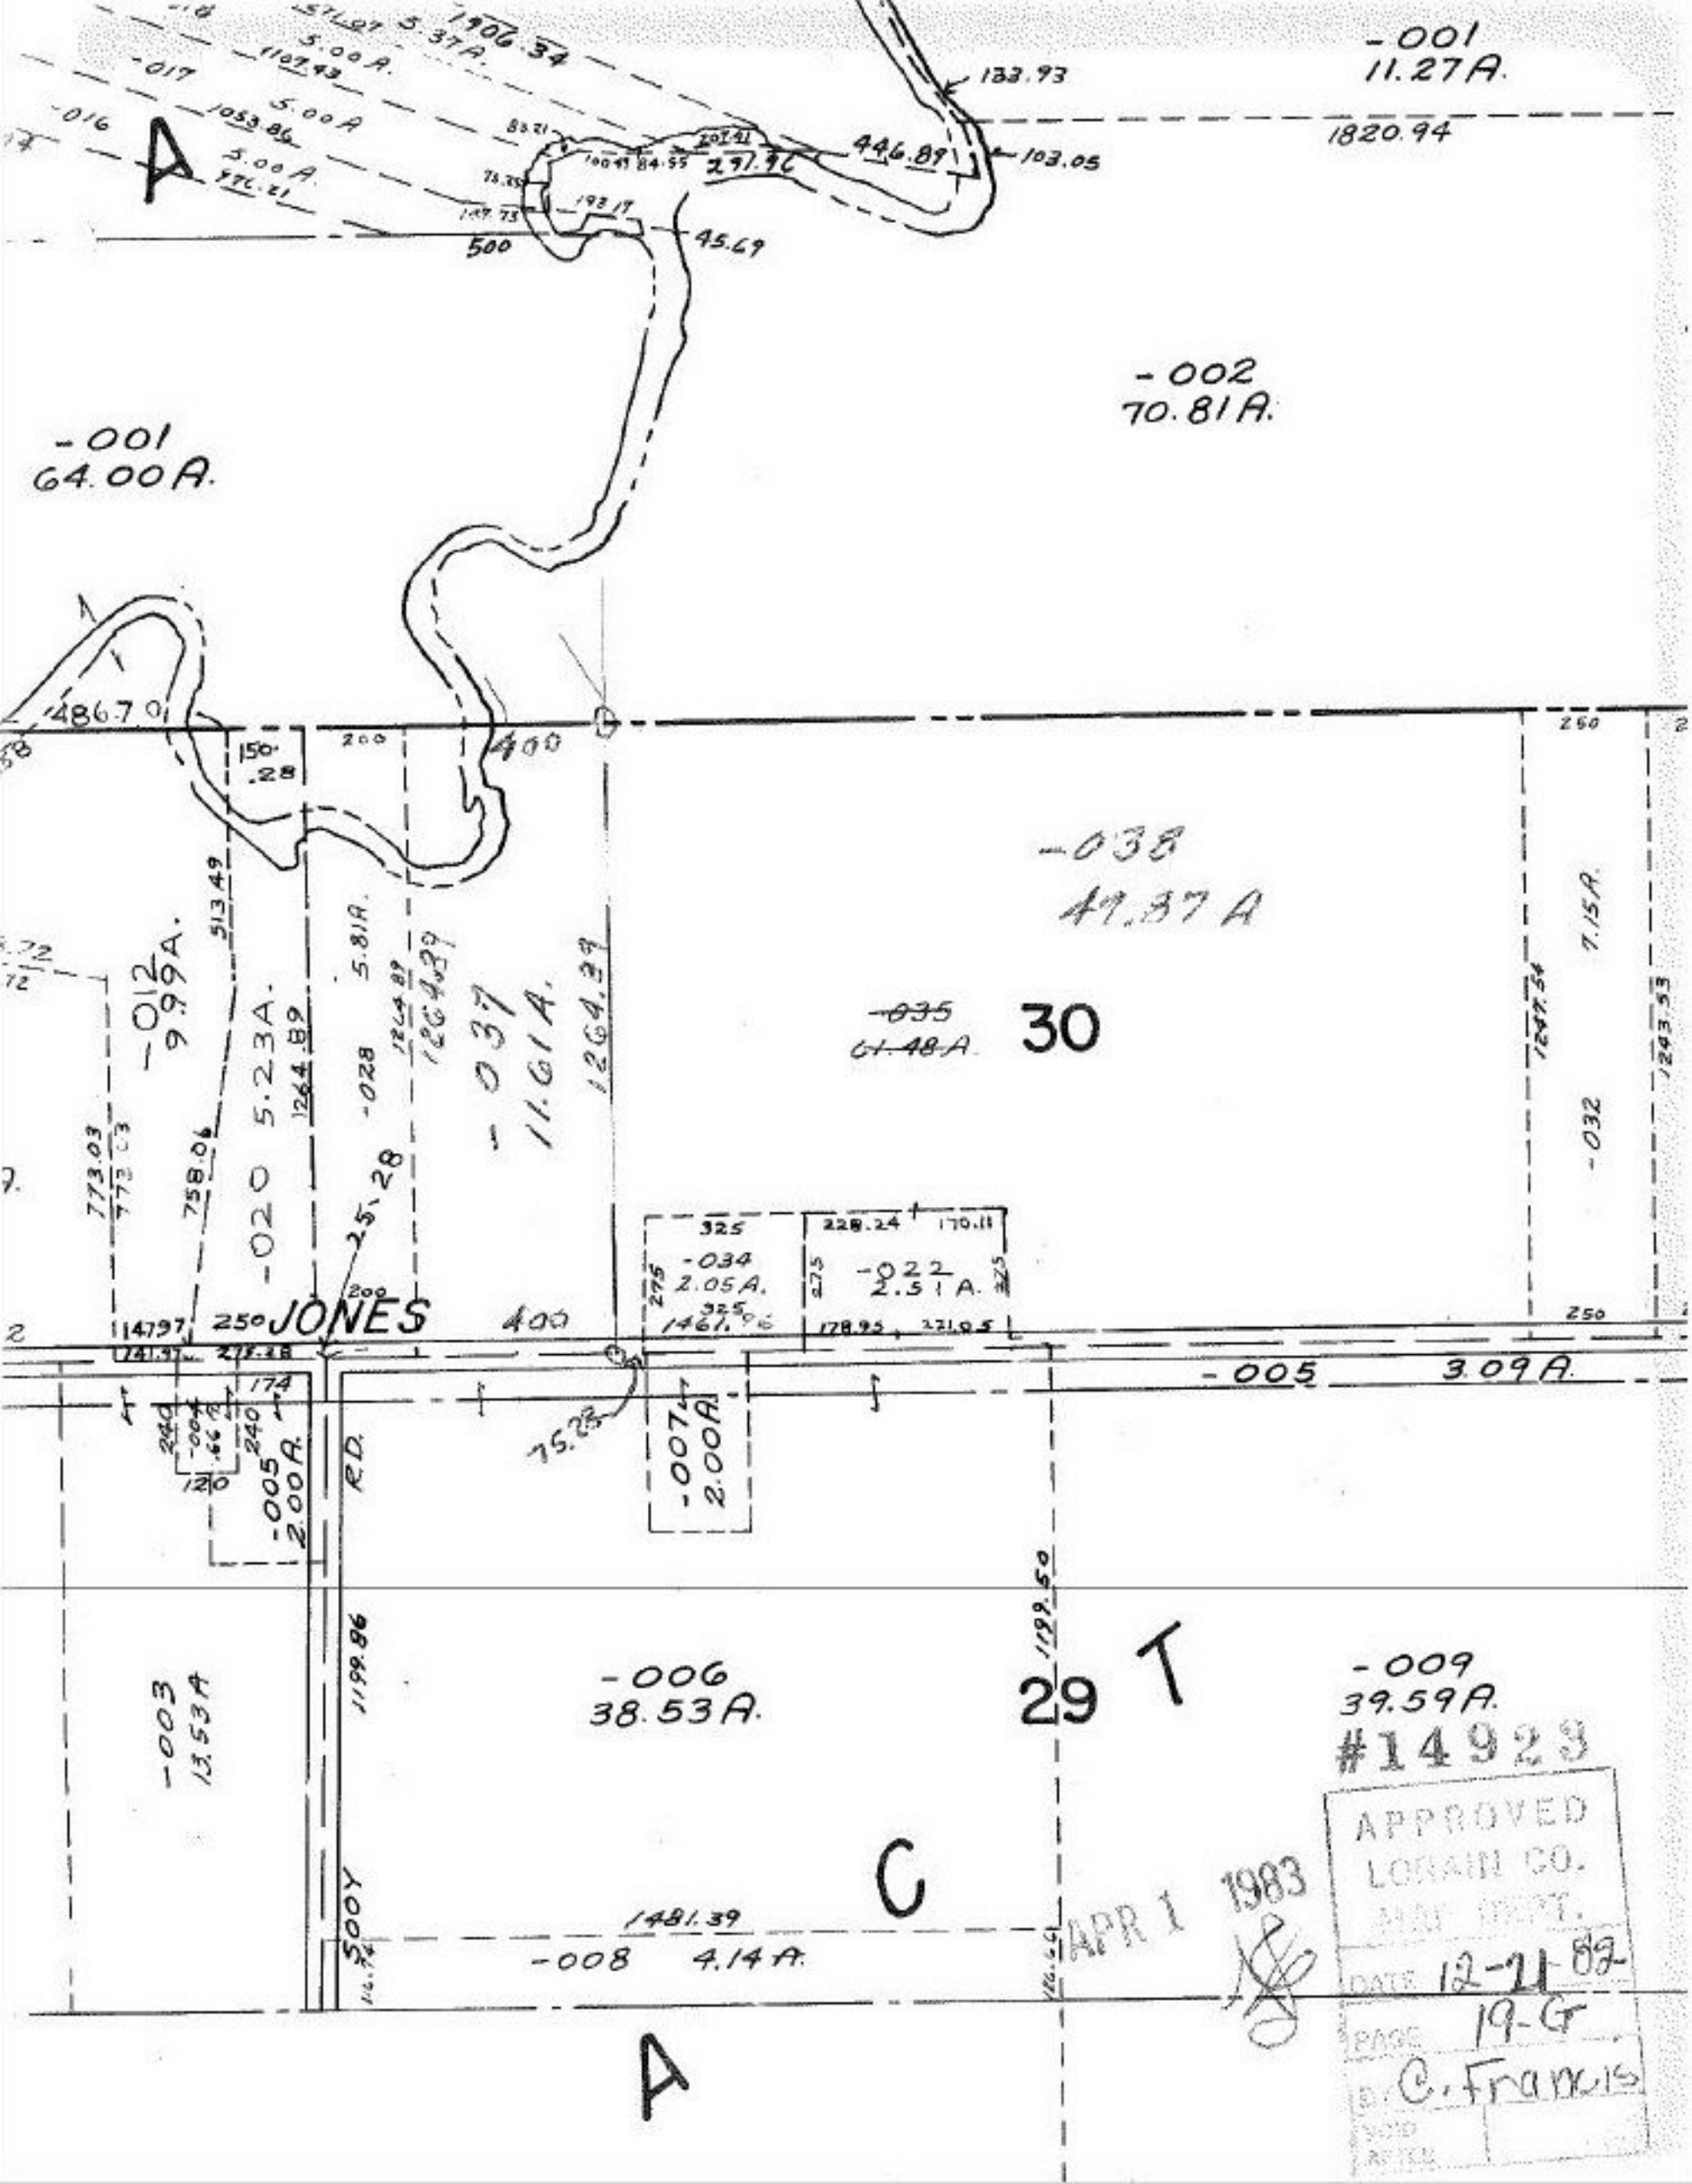

#14923
APPROVED
LORAIN CO.
MAP DEPT.
DATE 12-21-82
PAGE 19-G
BY C. Francis
APR 1 1983