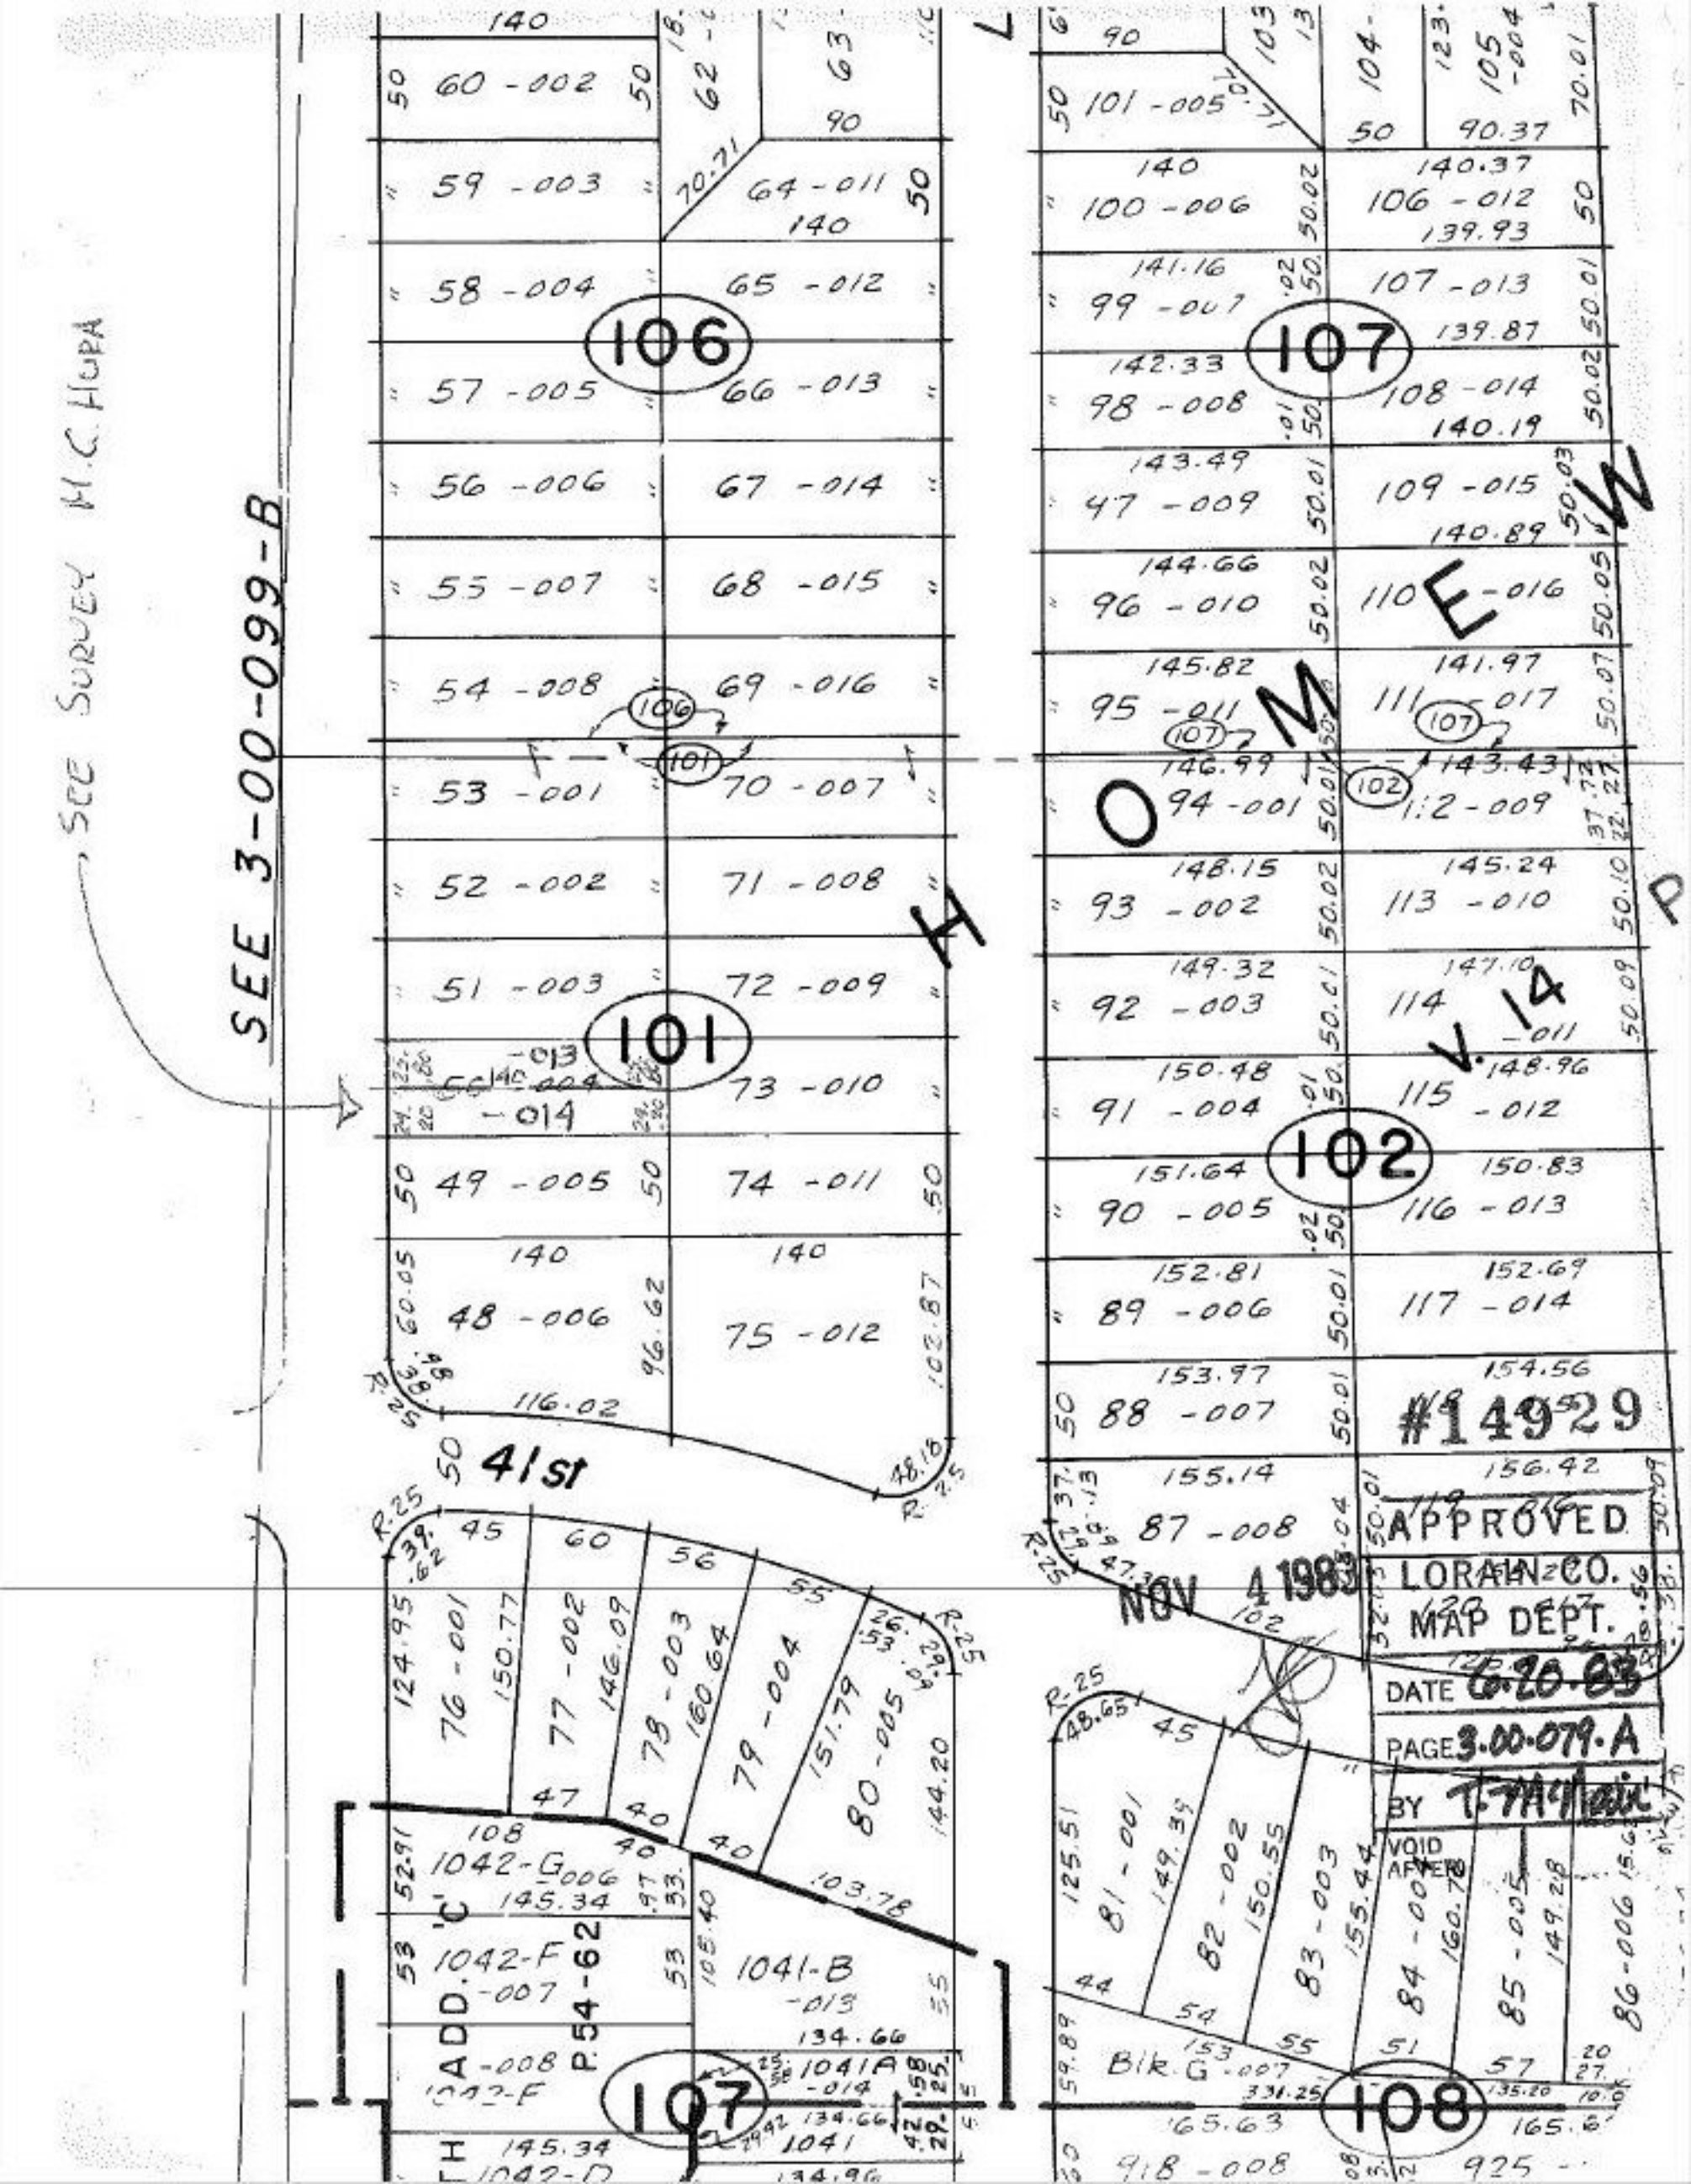

SEE SURVEY M.C. HURA
SEE 3-00-099-B
106
107
101
102
108
41st
HOMEW
V. 14
P
#14929
APPROVED
LORAIN CO.
MAP DEPT.
NOV 4 1983
DATE 6.20.83
PAGE 3.00.079.A
BY T. McNair
VOID AFTER
1042-G
1042-F
1041-B
1041A
1041
ADD. 'C'
P.54-62
Blk. G