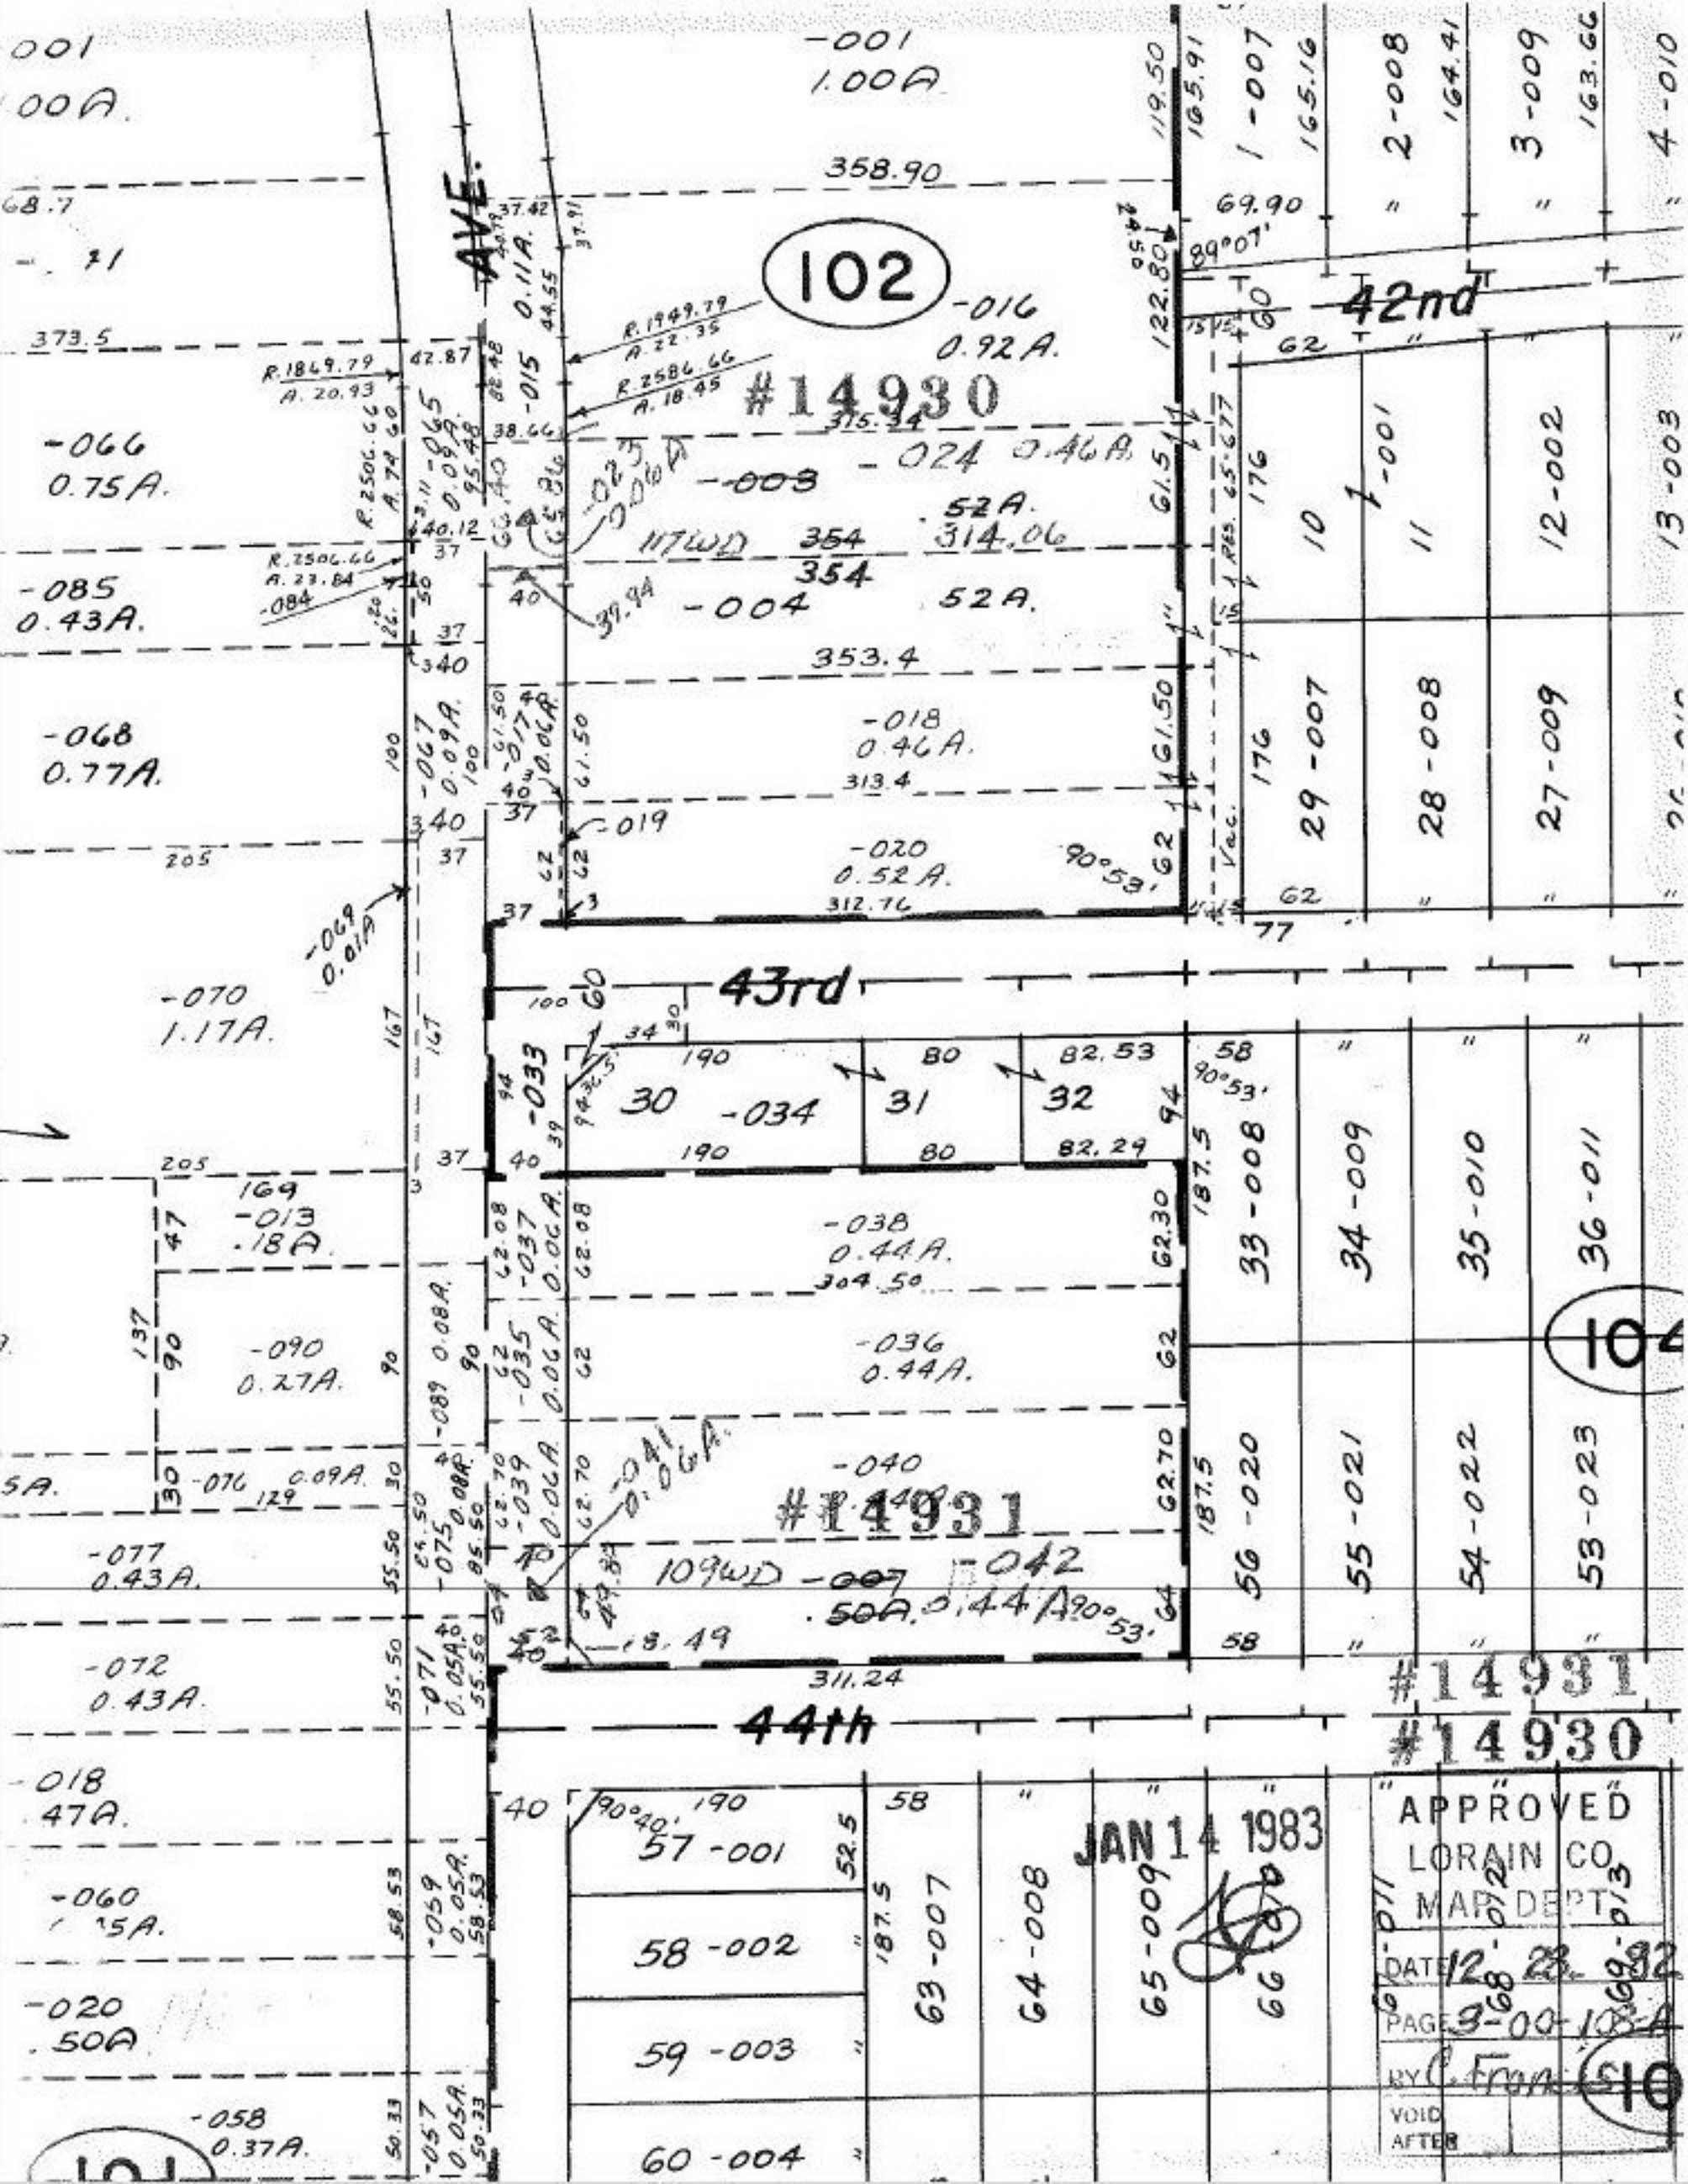

102
#14930
42nd
43rd
44th
AVE.
#14931
#14930
JAN 14 1983
APPROVED
LORAIN CO.
MAP DEPT.
DATE 12-28-82
PAGE 3-00-108-A
BY C. Francis
VOID AFTER