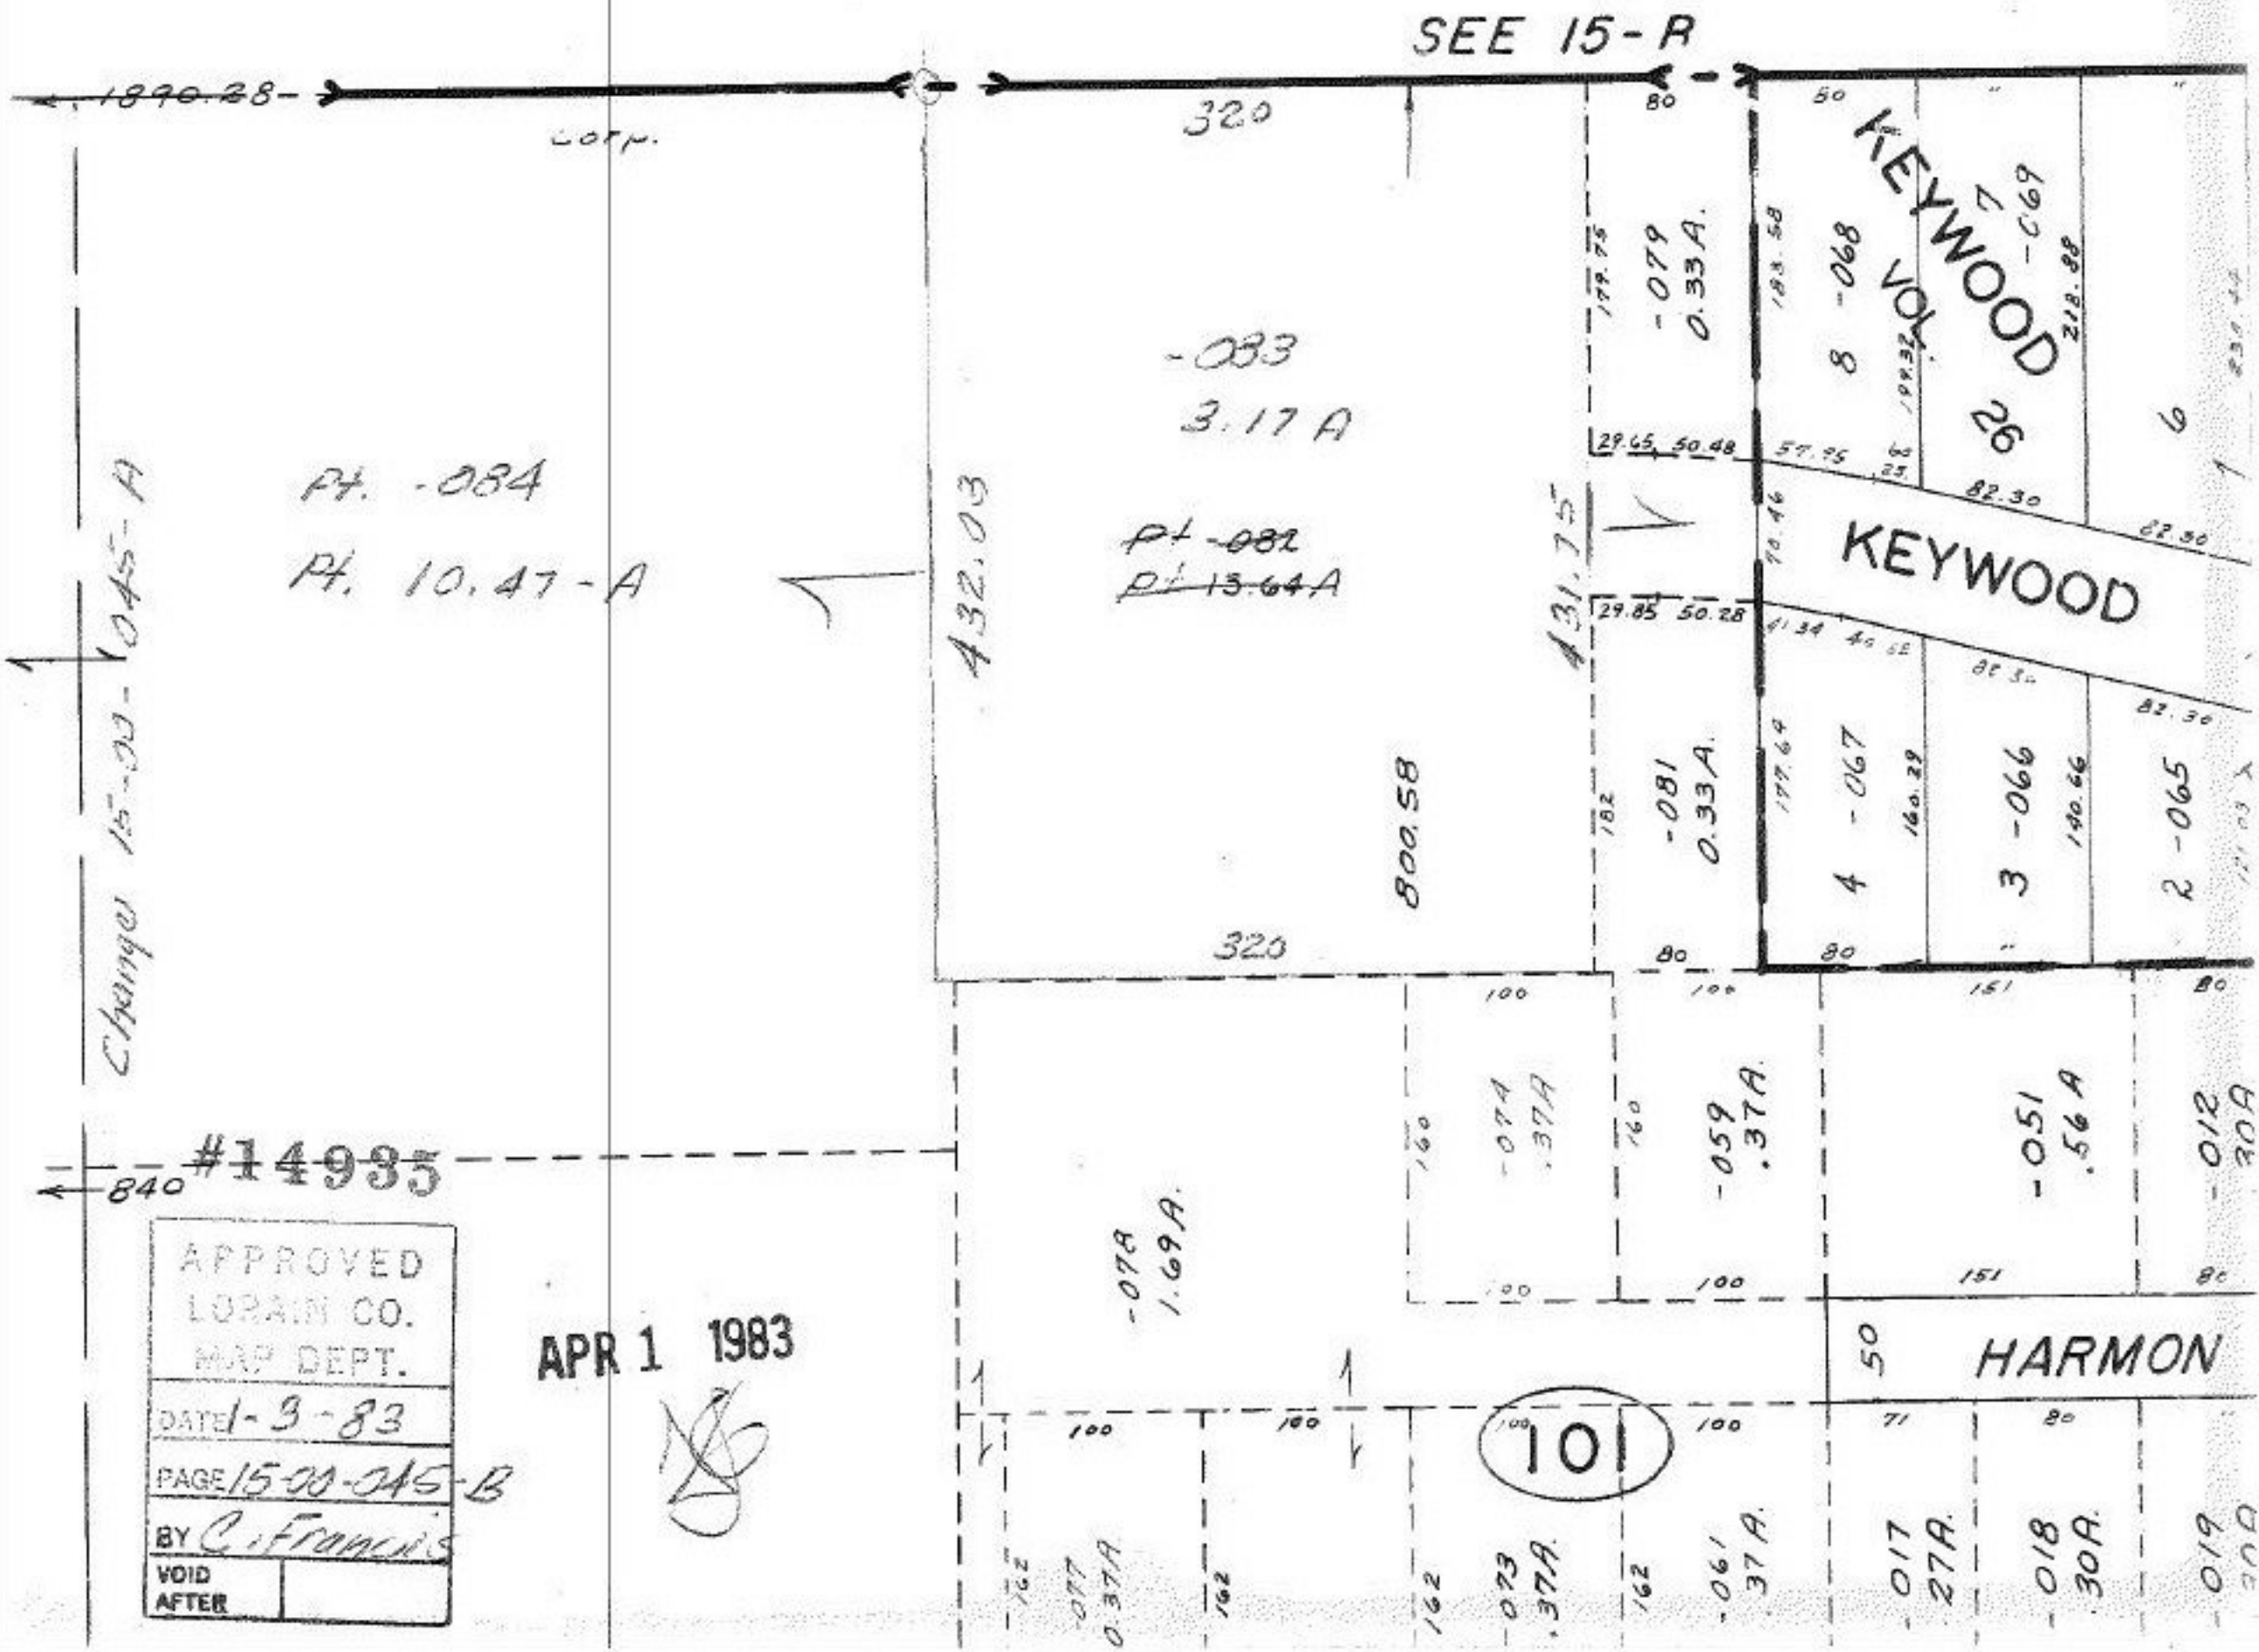

APPROVED
LORAIN CO.
MAP DEPT.
DATE 1-3-83
PAGE 15-00-045-B
BY C. Francis
VOID AFTER

APR 1 1983