WHEN DOING THIS SPLIT SHOW THE ORIGINAL SUBDIVISION DISTANCE OF 56.40 ALONG R/W OF TOWER BLVD. IN ADDITION TO SPLIT DIMENSIONS ON POINT PARCEL.

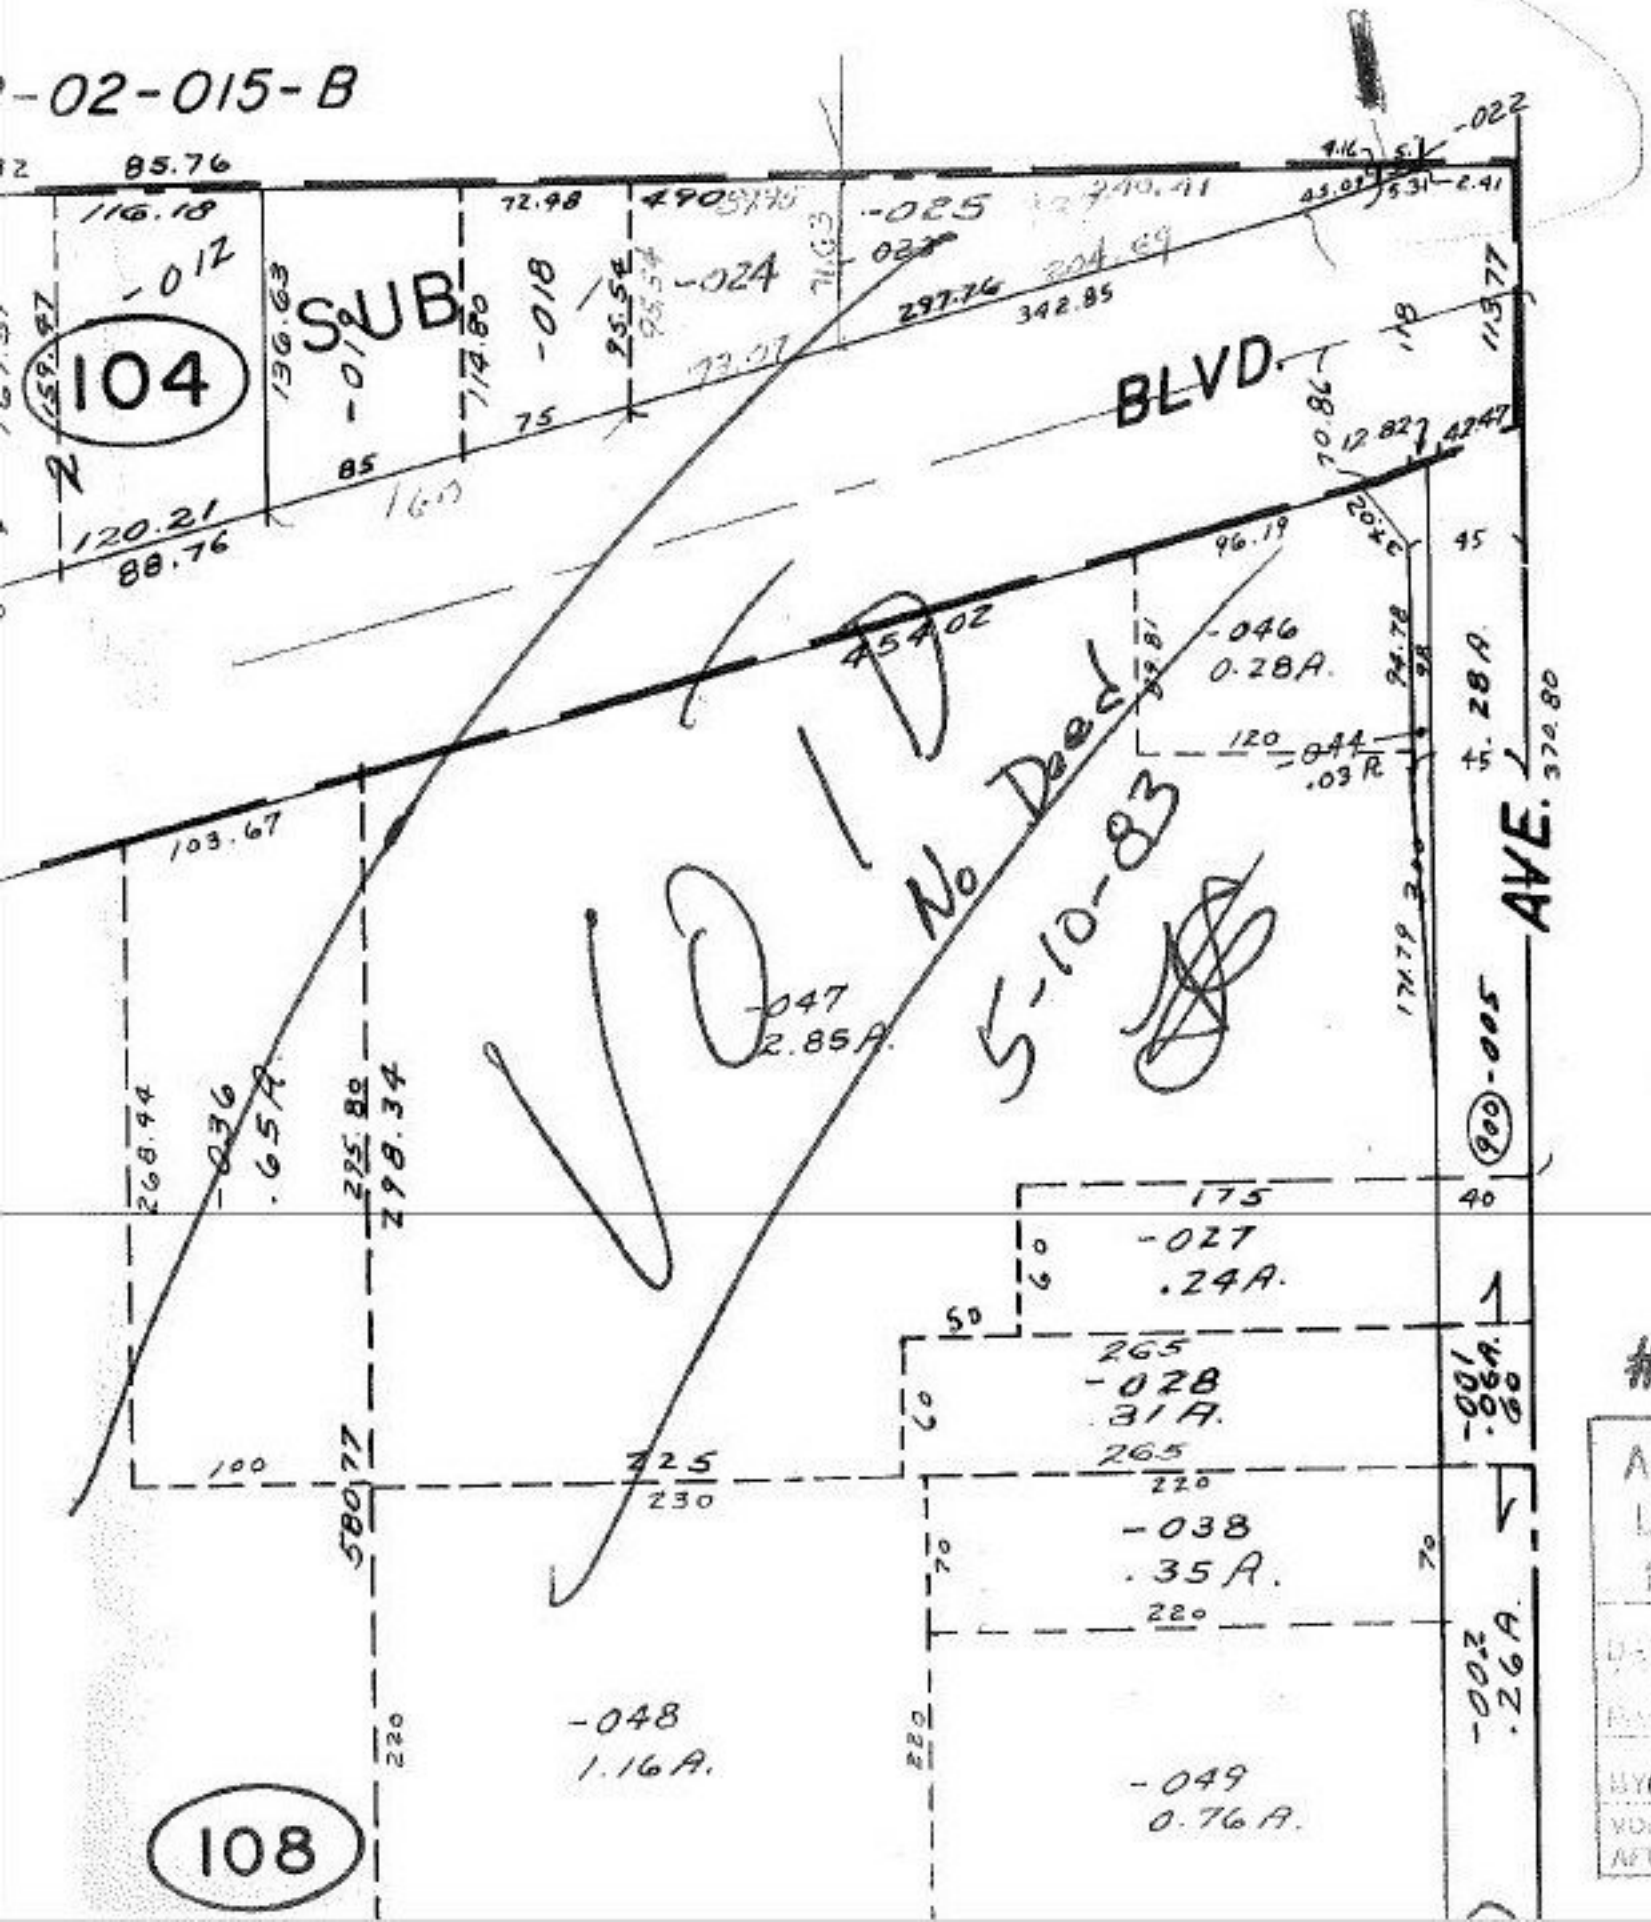

#14937

APPROVED
LORAIN CO.
MAP DEPT.
DATE 1-11-83
PAGE 02-02-006-B
BY C. Francis
VOID AFTER