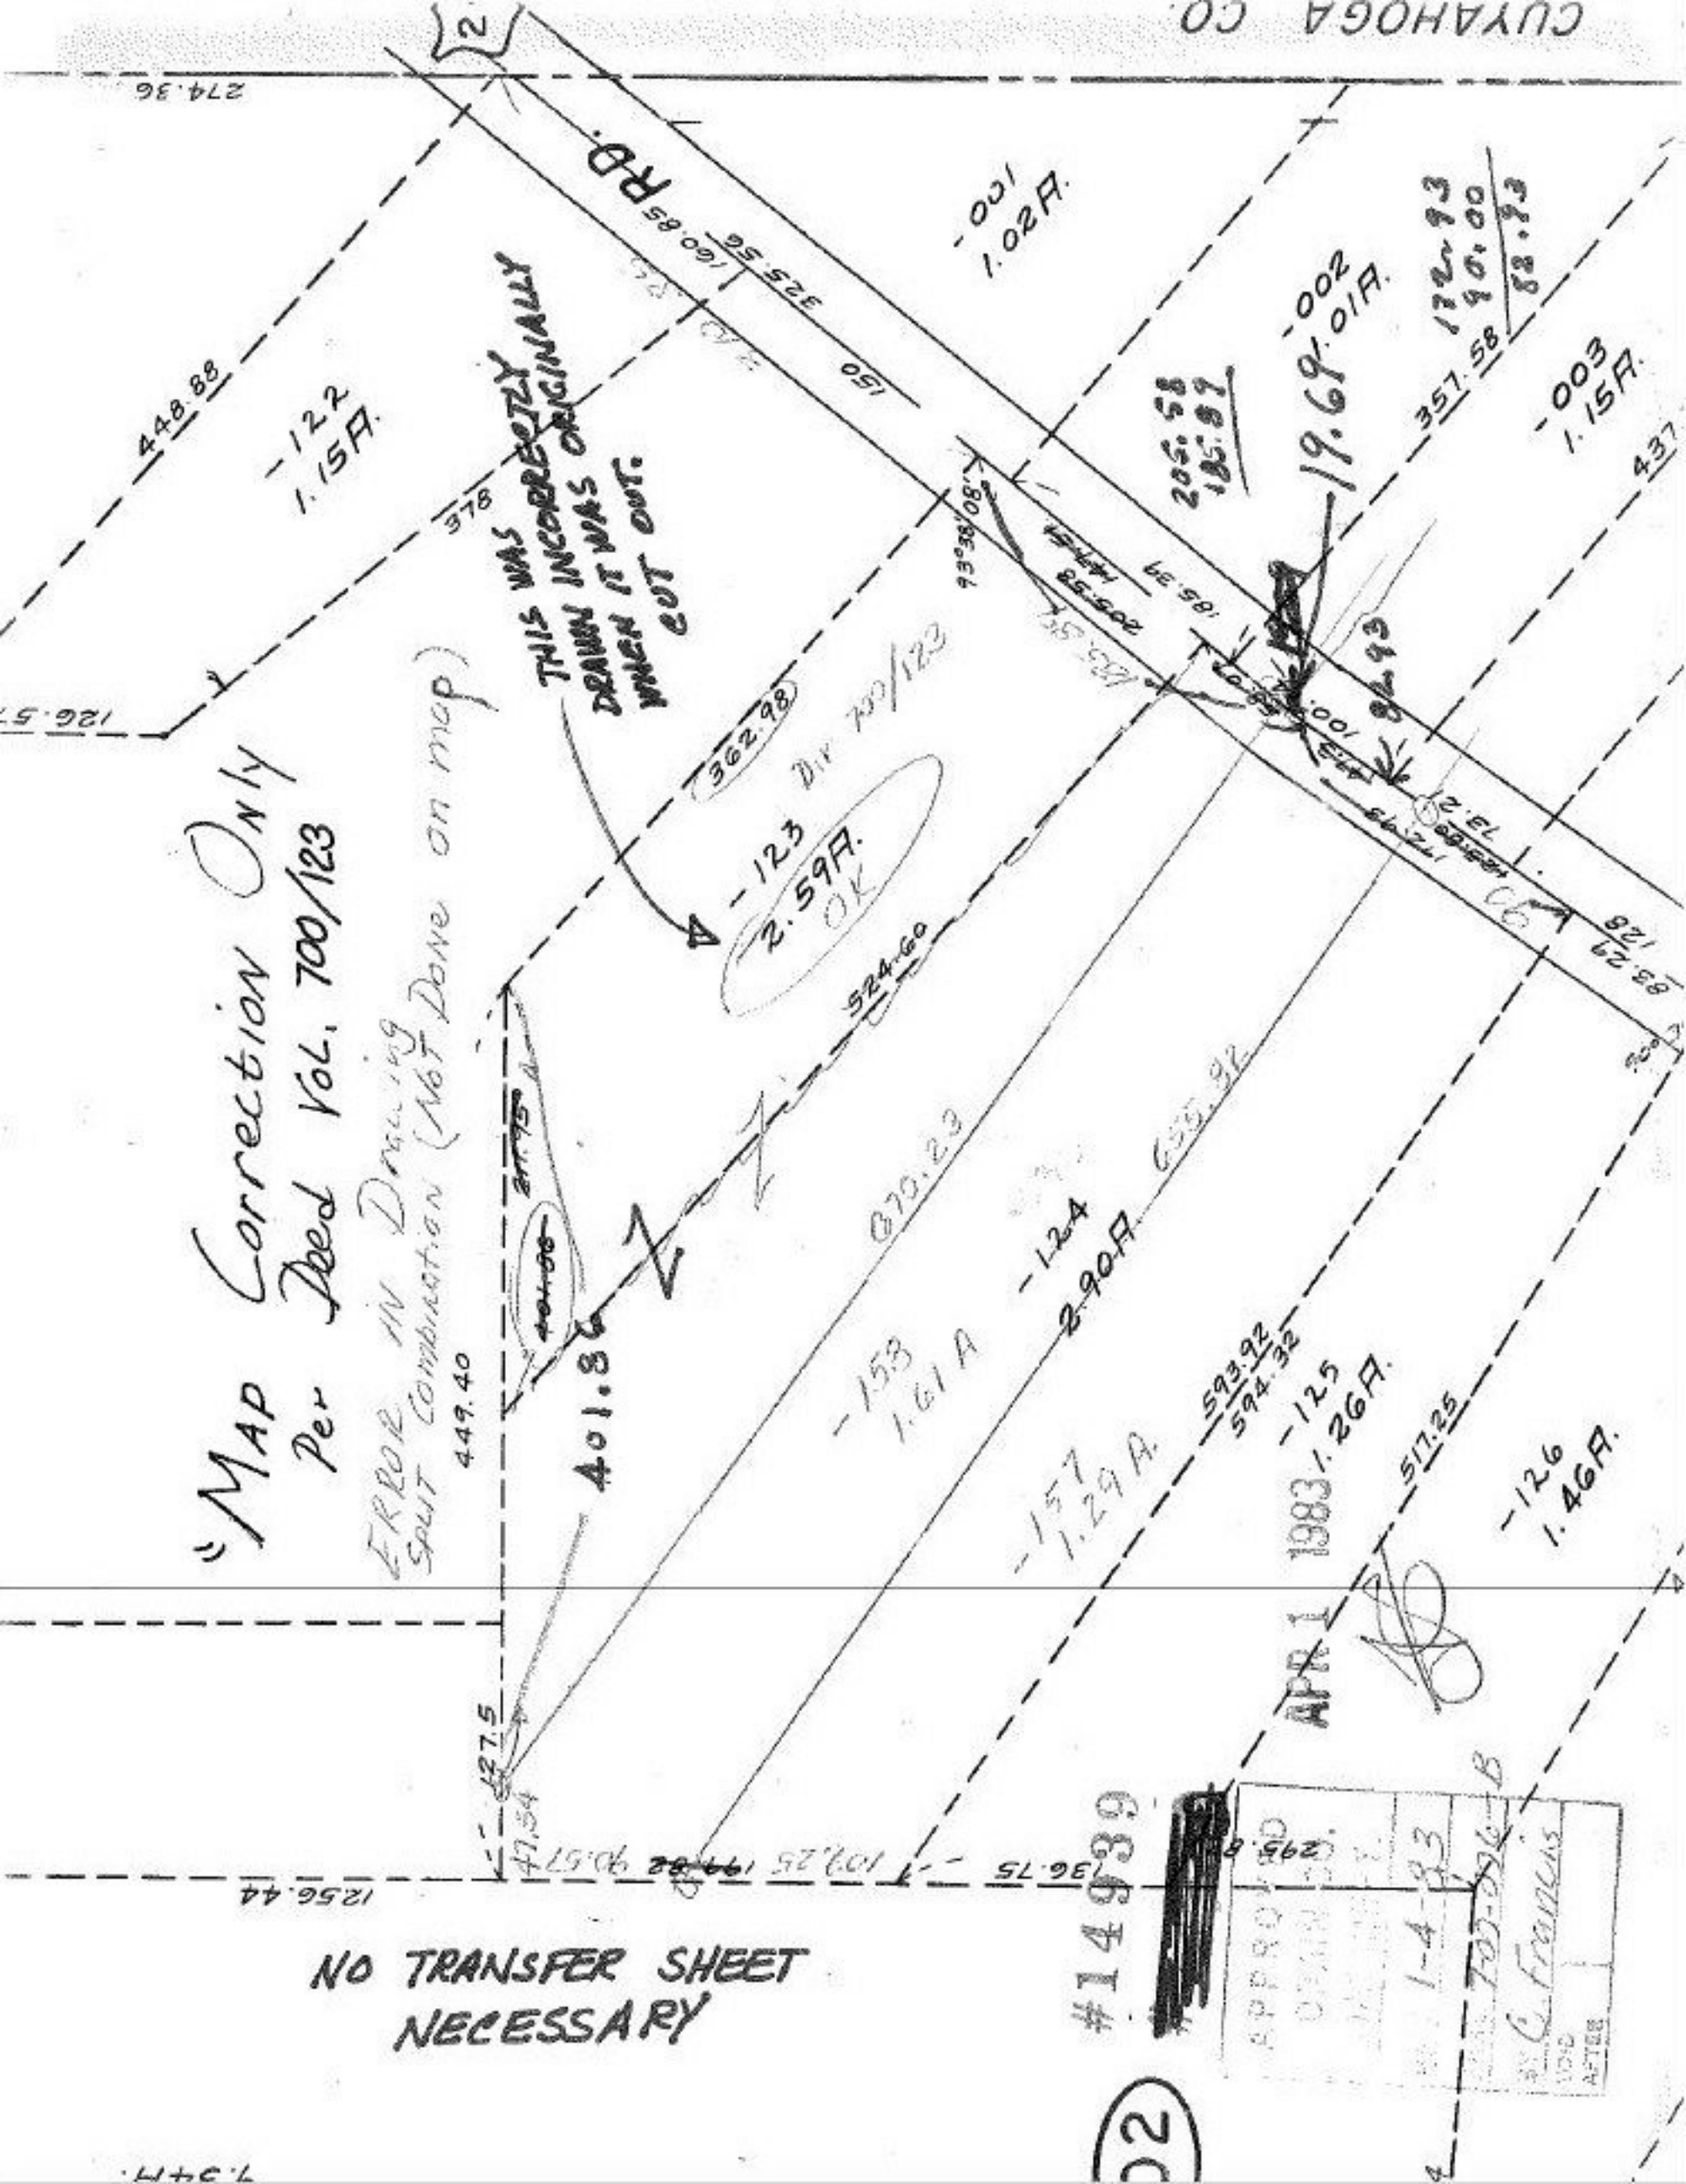
CUYAHOGA CO.
RD.
THIS WAS DRAWN INCORRECTLY WHEN IT WAS ORIGINALLY CUT OUT.
"MAP Correction Only
Per Deed Vol. 700/123
ERROR IN Drawing
SPLIT Combination (Not Done on map)
-001 1.02A.
-002 1.01A.
-003 1.15A.
-122 1.15A.
-123 2.59A. OK
-124 2.90A.
-125 1.26A.
-126 1.46A.
-153 1.61A
-157 1.29A.
19.69
82.93
401.86
Dir 700/123
APR 1 1983
#14939
NO TRANSFER SHEET NECESSARY
C. Francis