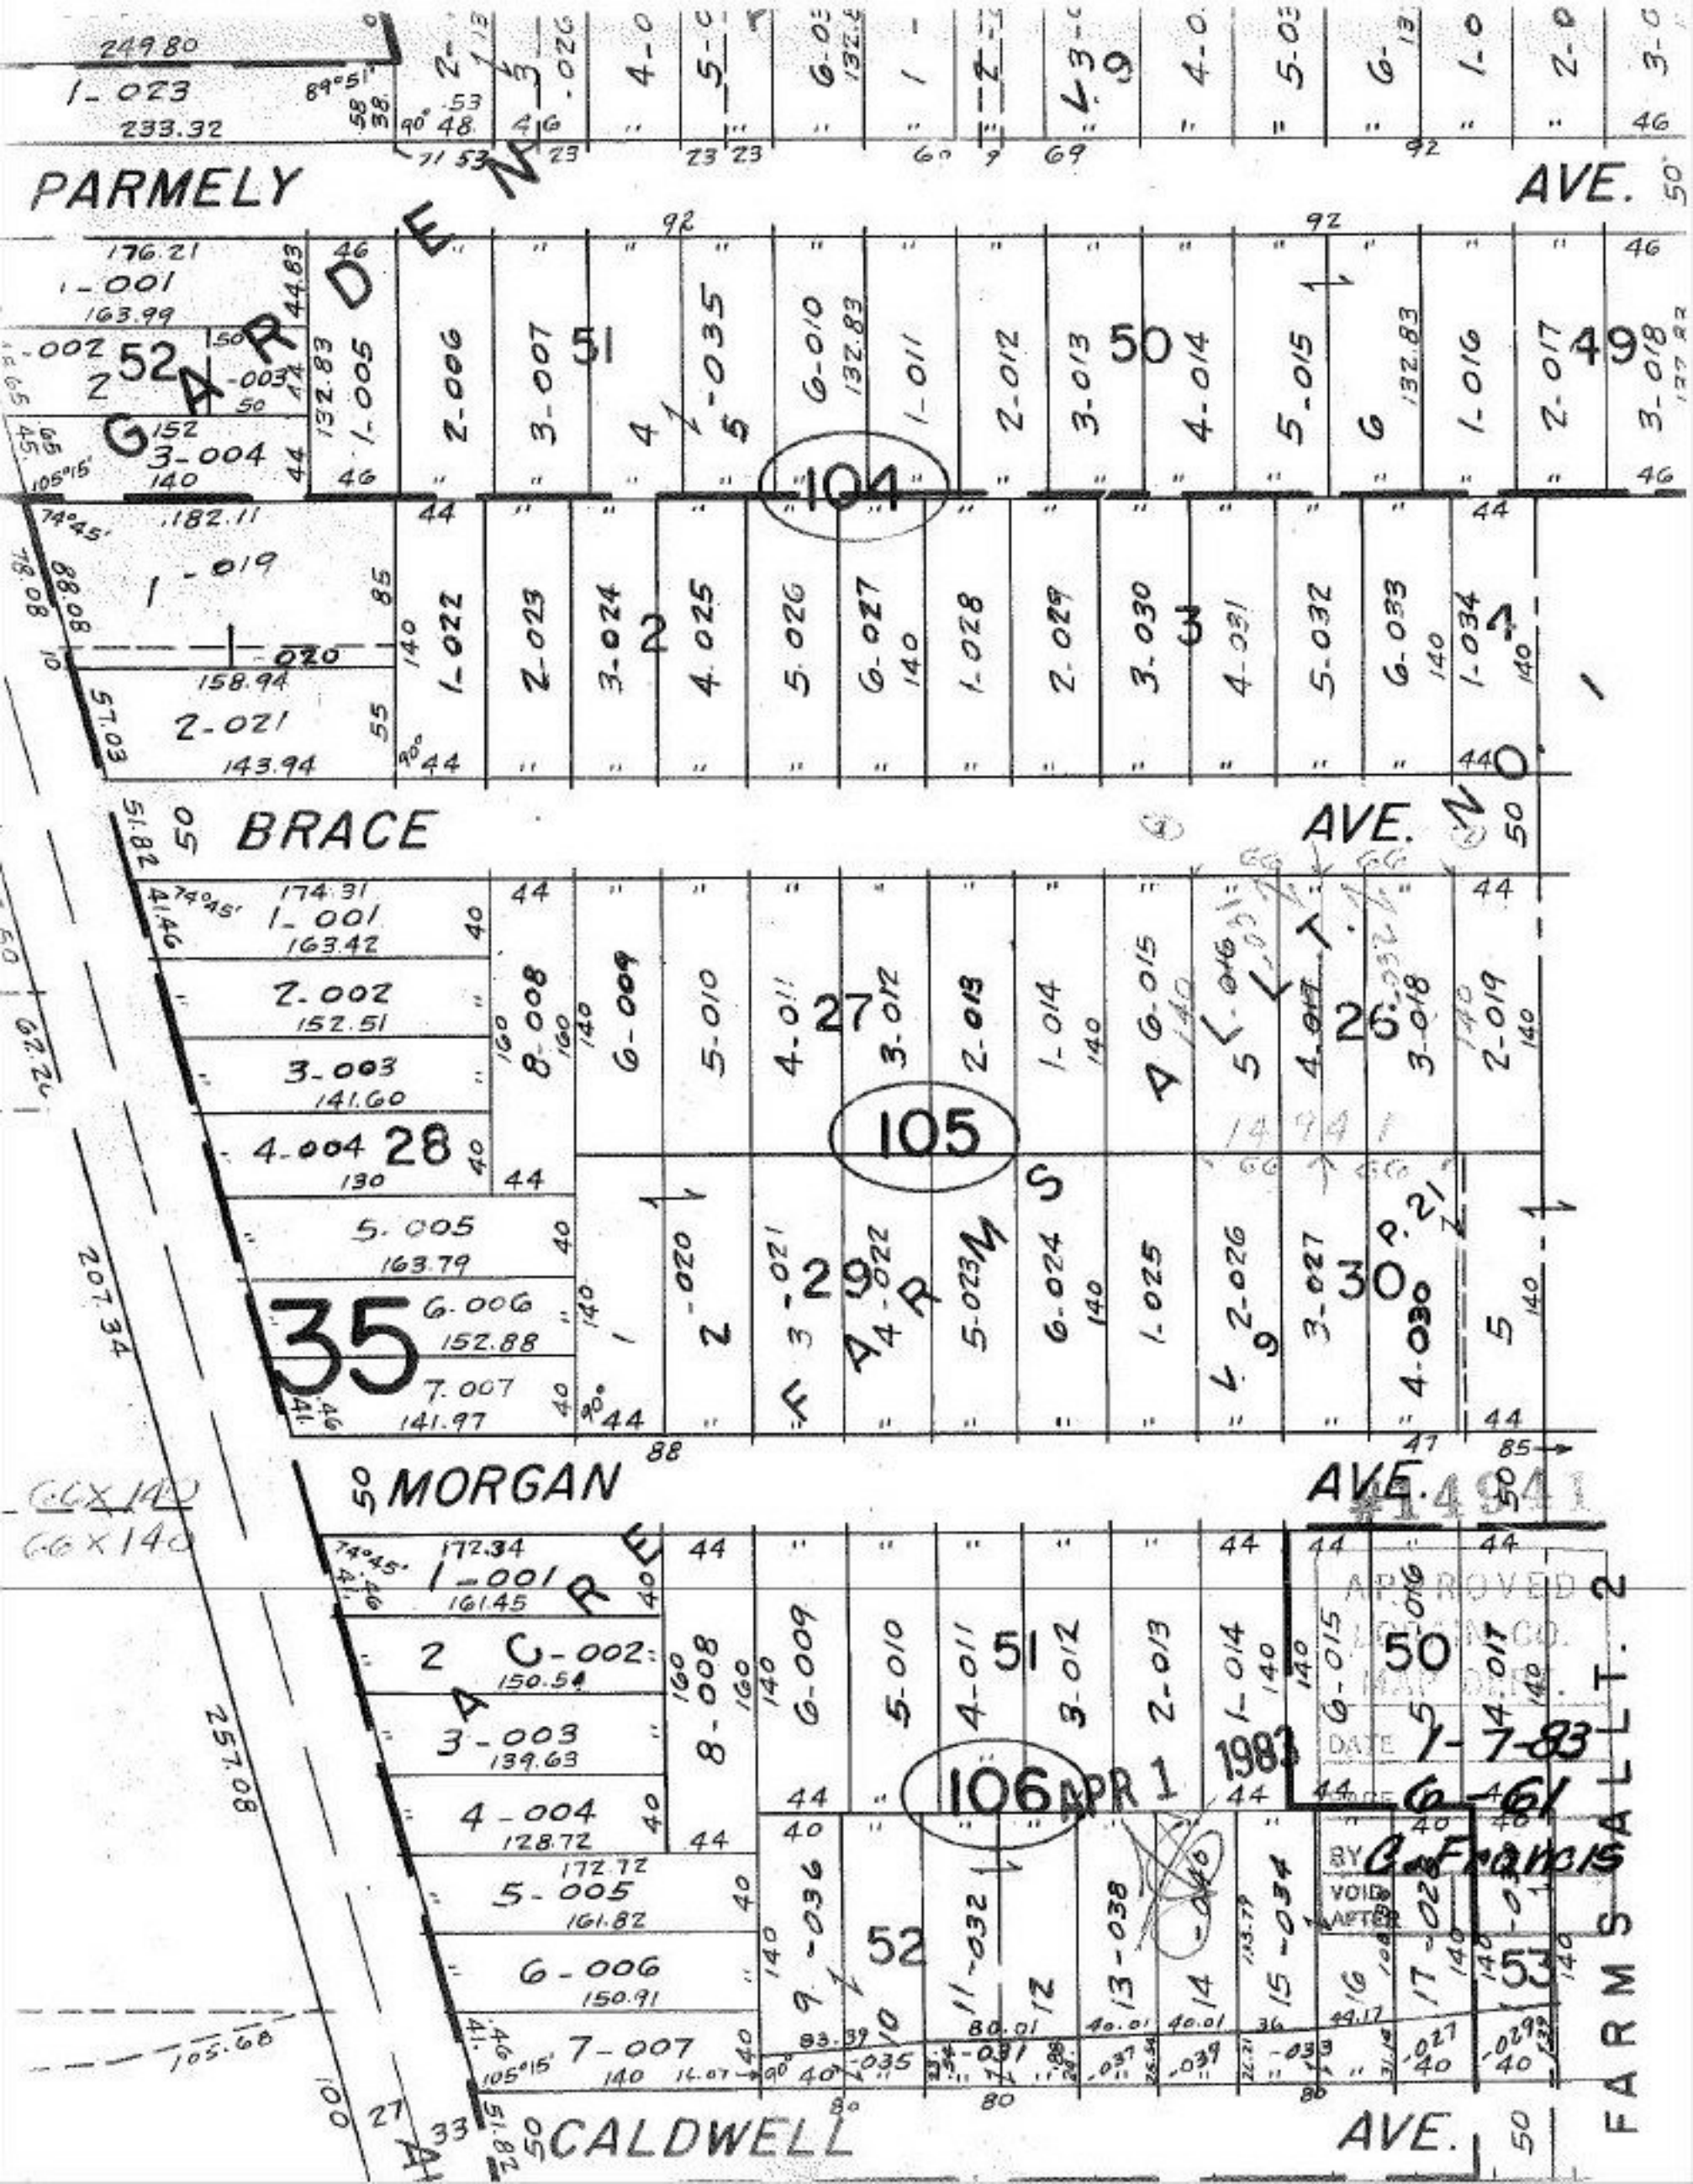
PARMELY AVE.
GARDEN
BRACE AVE.
MORGAN AVE.
CALDWELL AVE.
FARMS ALLT. 2
FARMS ALLT. NO. 1
104
105
106
35
#14941
APPROVED
DATE 1-7-83
PAGE 6-61
BY C. Francis
VOID AFTER
APR 1 1983