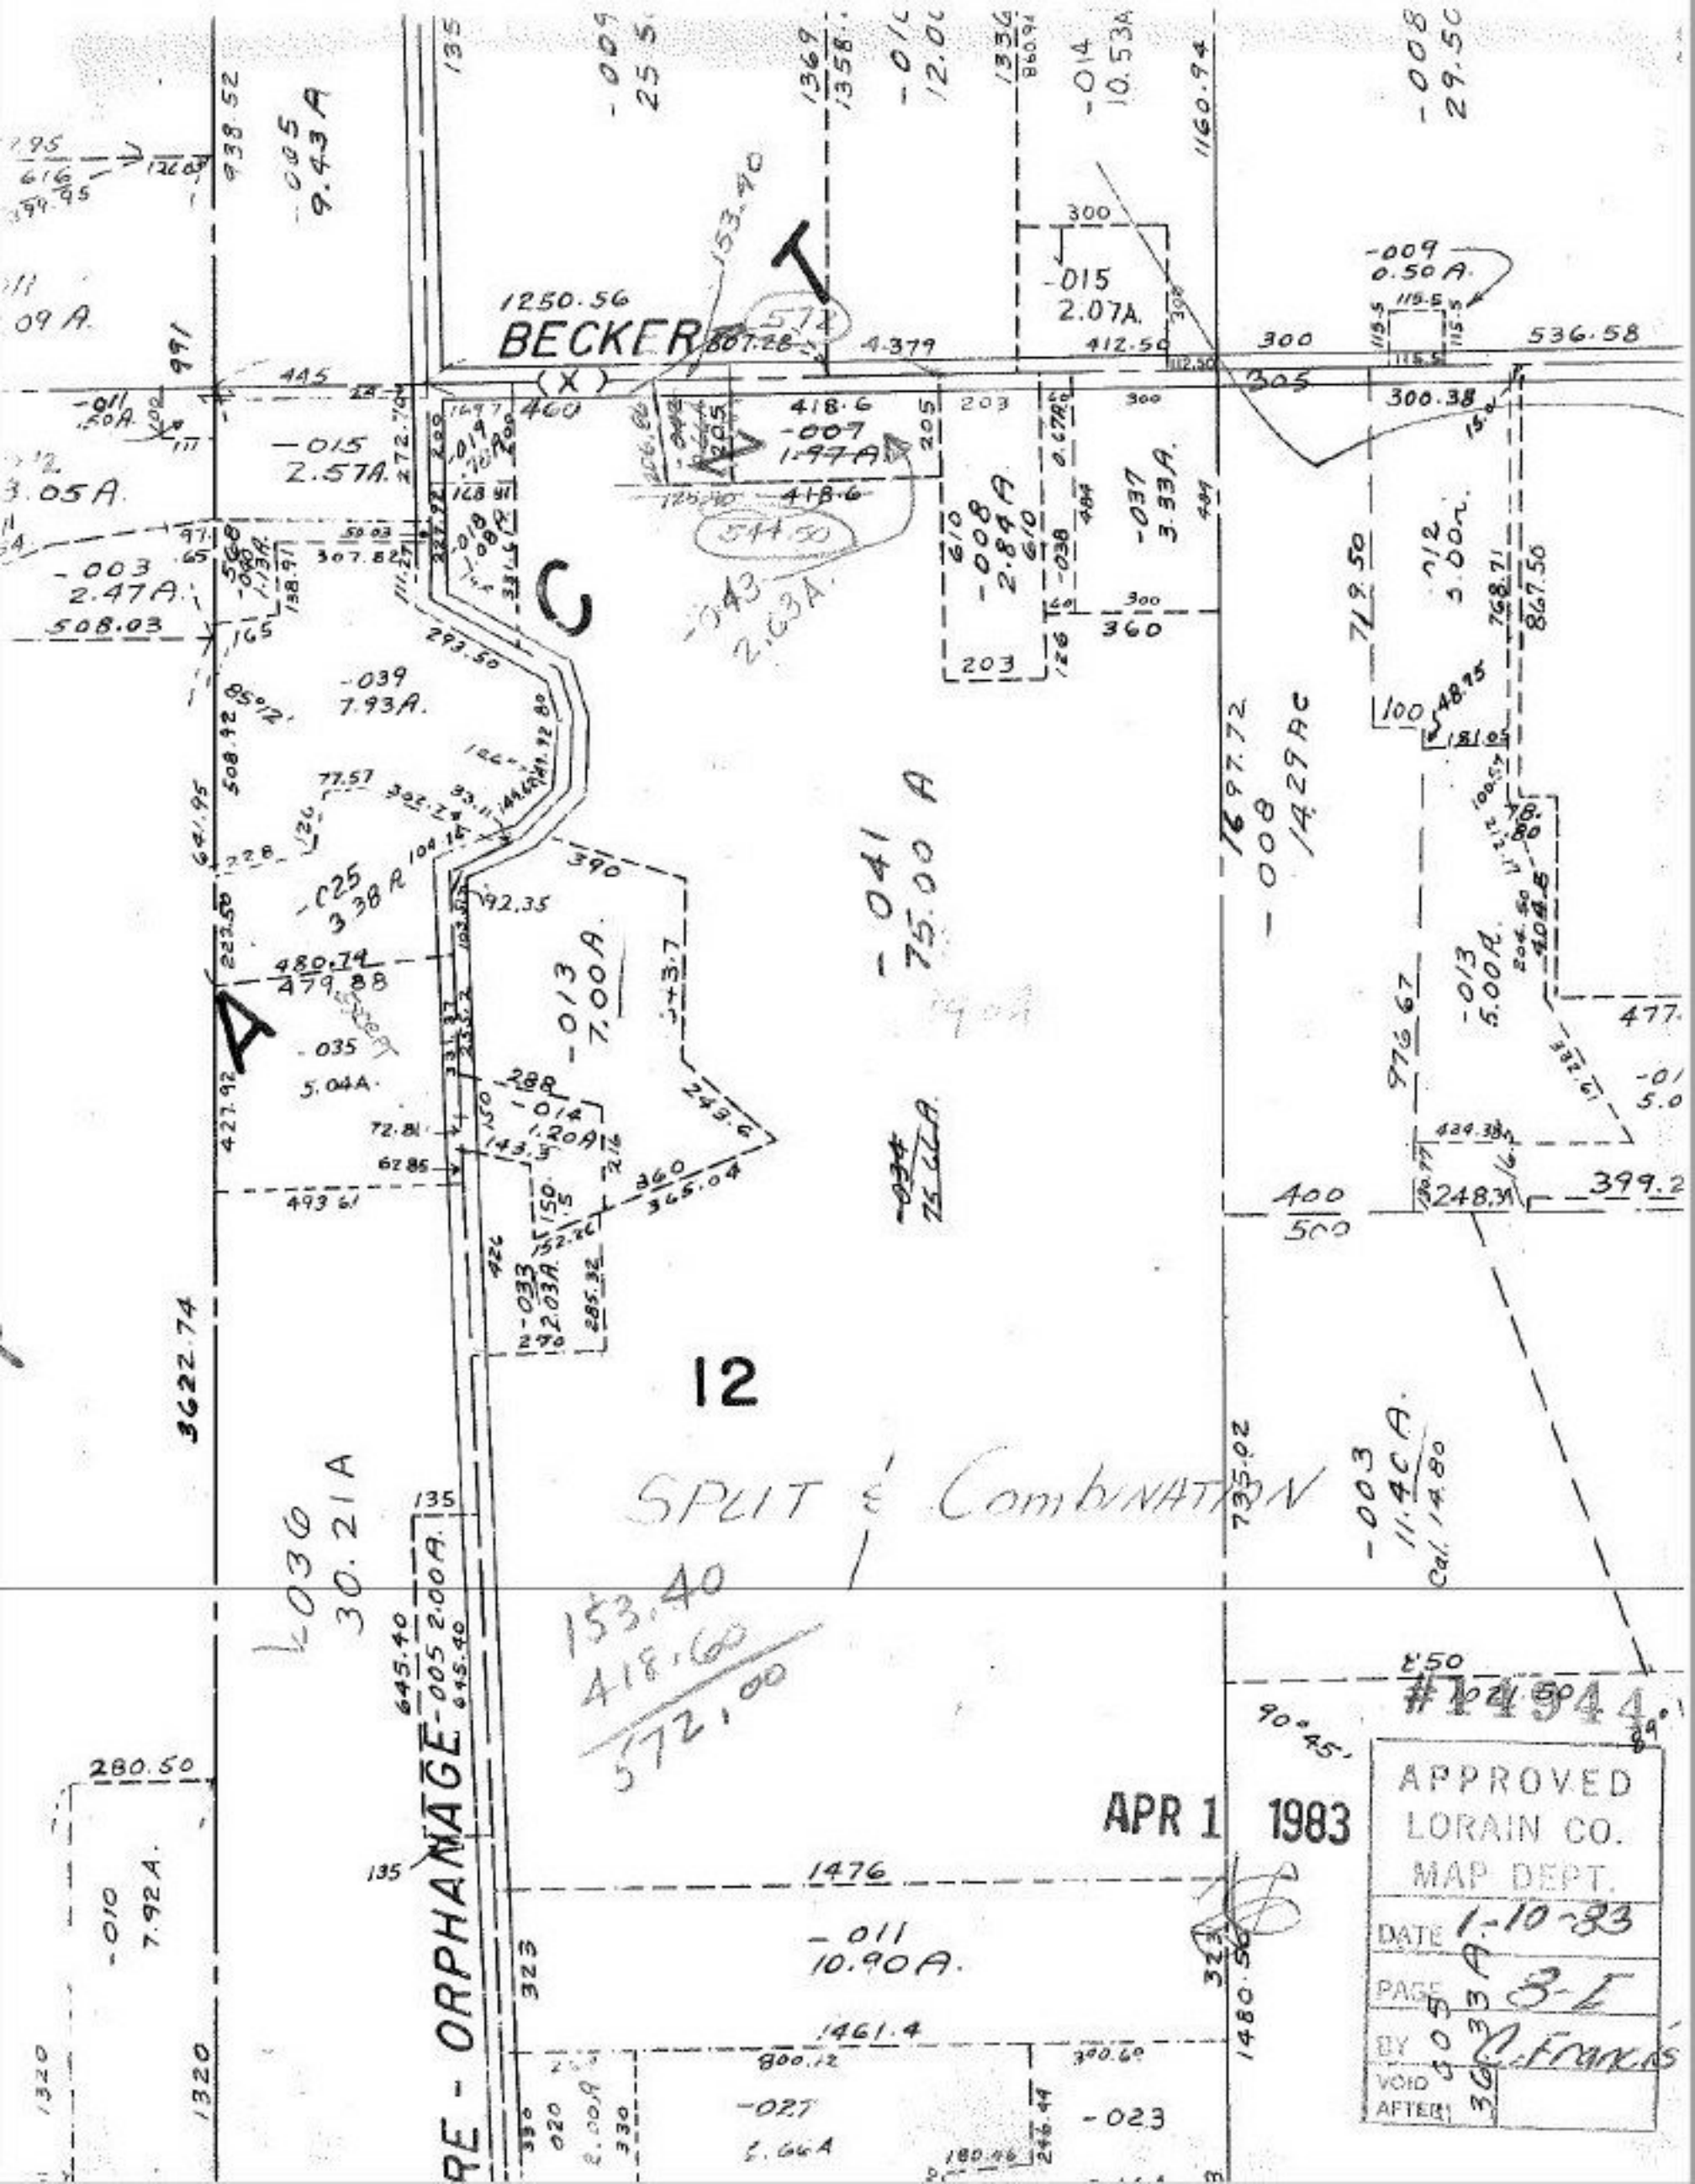
BECKER
12
SPLIT & COMBINATION
153.40
418.60
572.00
APR 1 1983
APPROVED
LORAIN CO.
MAP DEPT.
DATE 1-10-83
PAGE 3-E
BY C. Francis
VOID AFTER
#14944