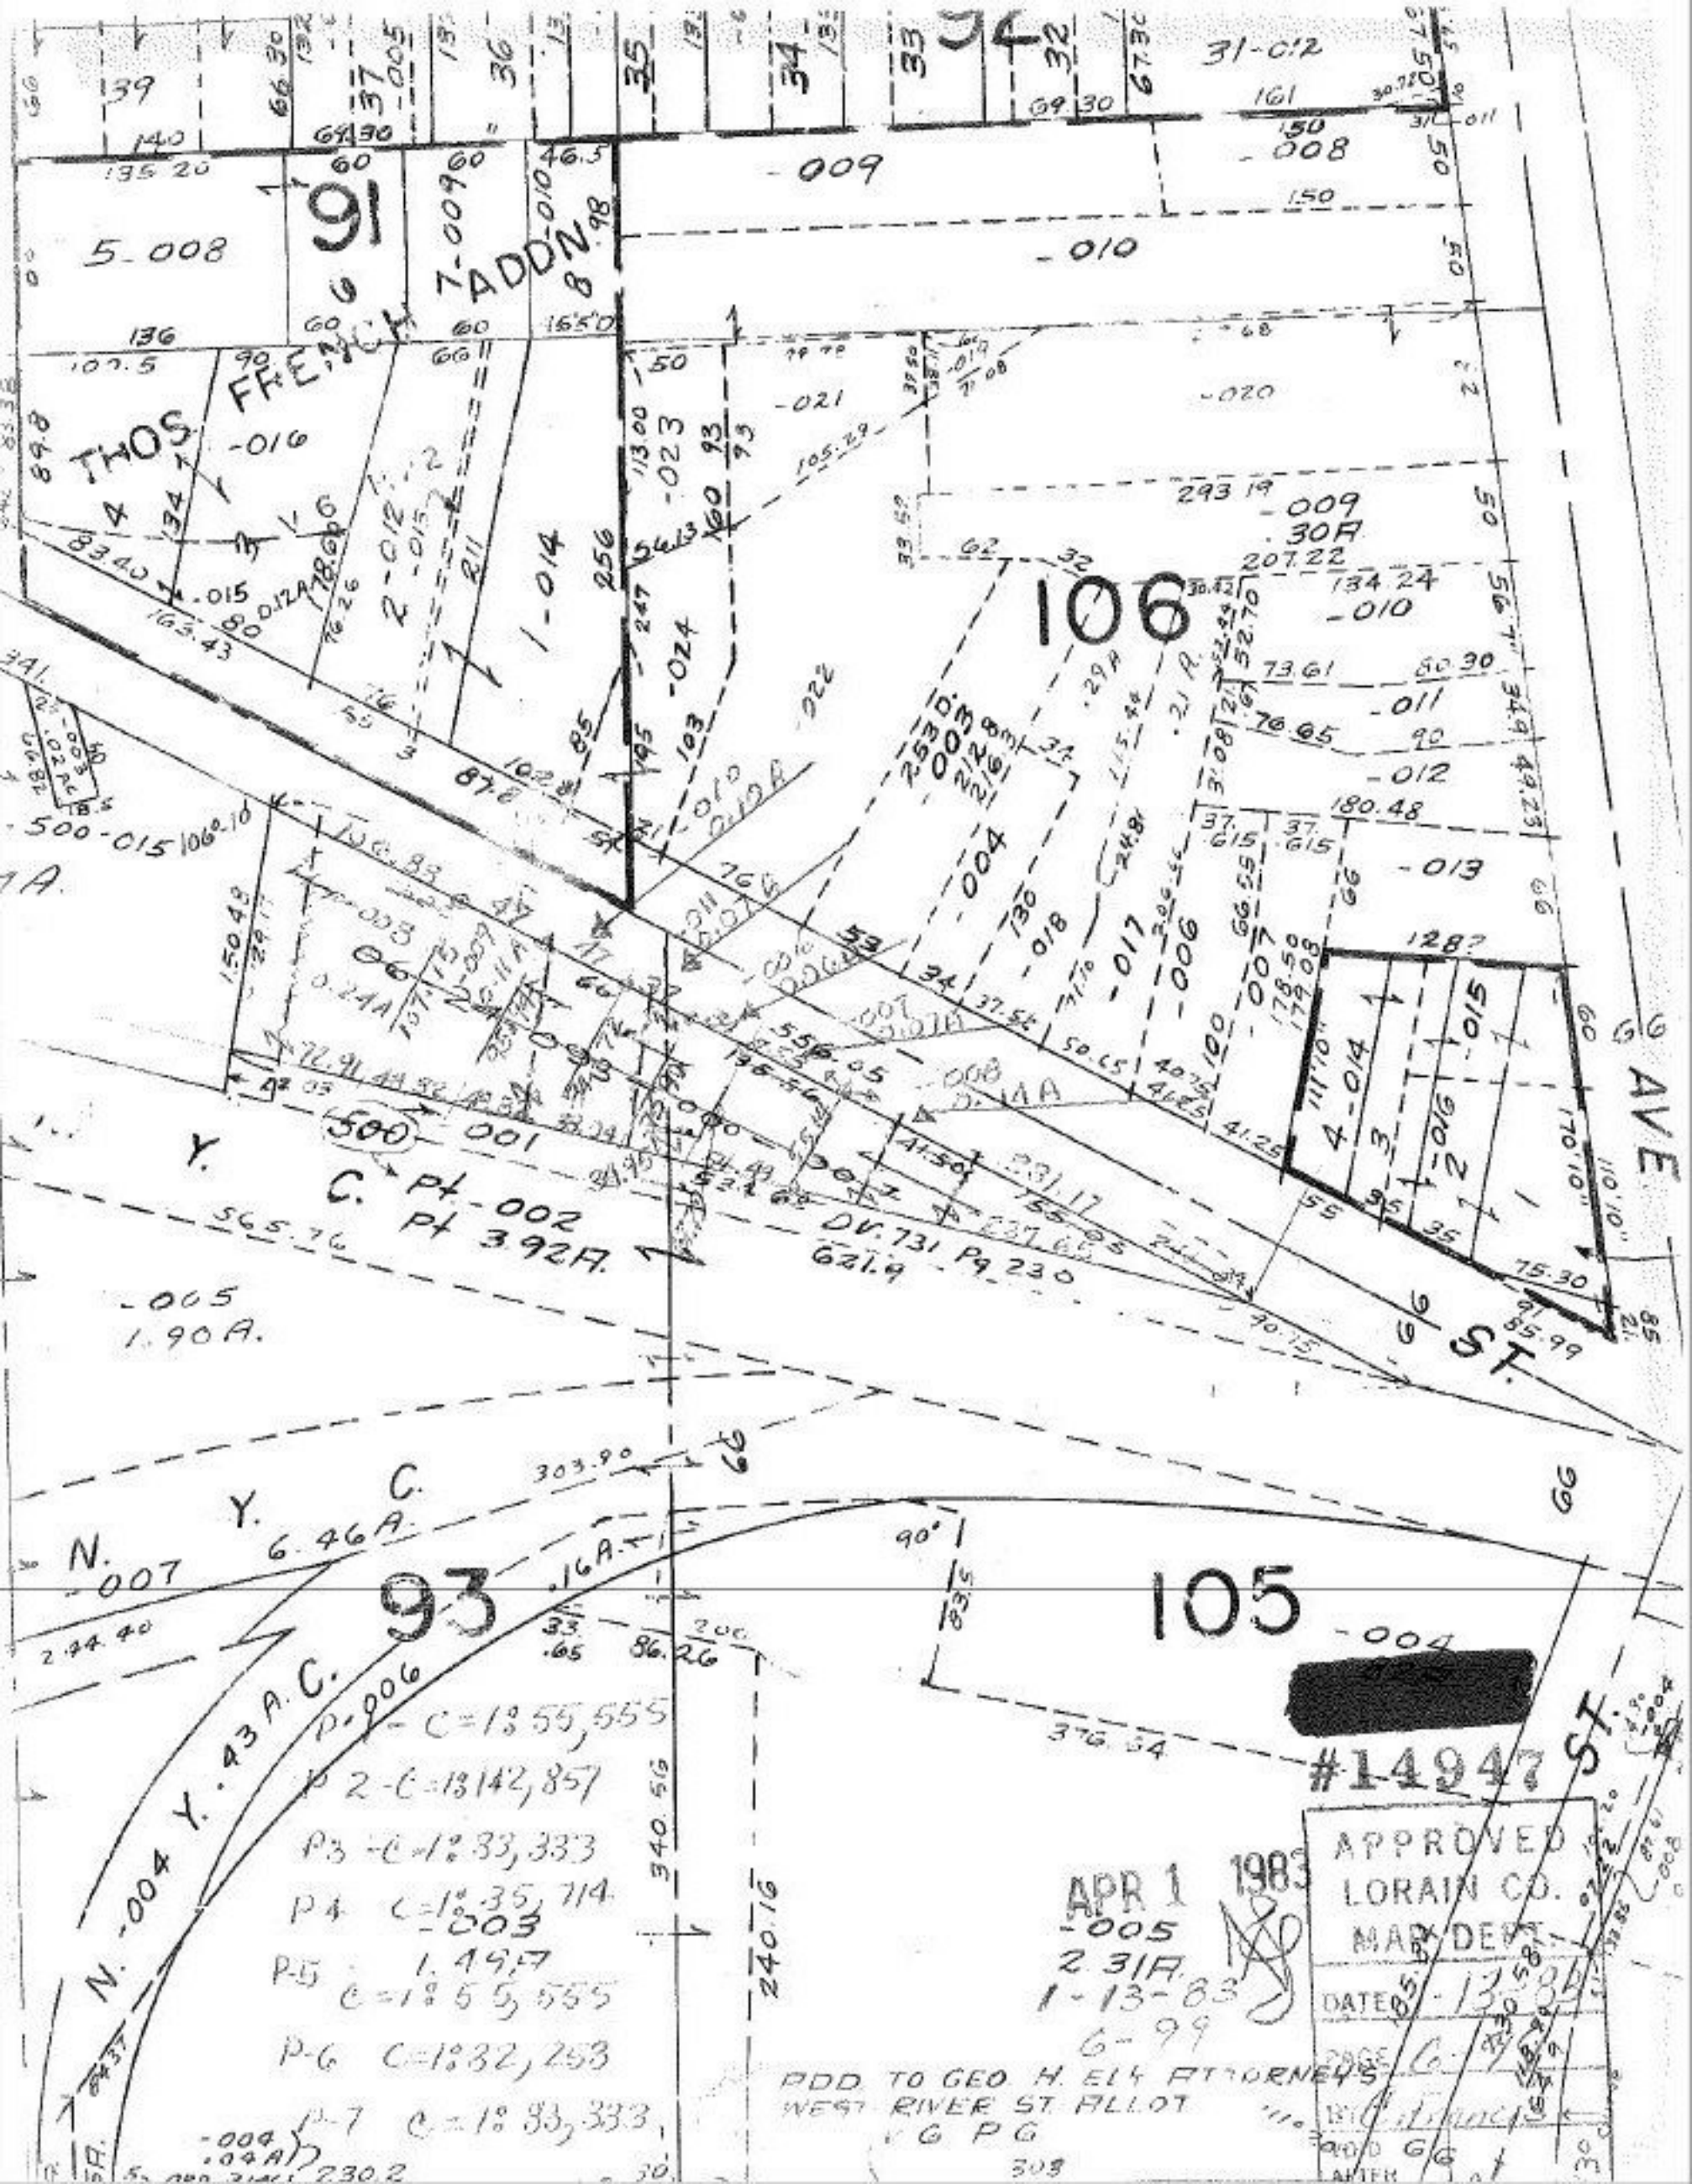
39
37
36
35
34
33
32
31-012
-009
-010
-008
5-008
9
7-00960
ADD N
8
FFELL
THOS
-016
-014
-023
-021
-020
-024
106
-009
.30A
207.22
134.24
-010
-011
-012
180.48
-013
-015
-017
-006
-007
-018
-004
-003
-002
-001
-005
1.90A.
C. Pt-002
Pt 3.92A.
Y.
N.
-007
6.46A.
93
.16A.
105
-004
#14947 ST.
ST.
AVE
APPROVED
LORAIN CO.
MAP DEPT.
DATE 4-13-83
APR 1 1983
-005
2.31A.
1-13-83
6-99
PDD TO GEO H. ELY ATTORNEYS
WEST RIVER ST. ALLOT
V G P G
DV. 731 Pg. 230
621.9
N. .004 Y. .43A. C.
P-006
P-1 C=1:55,555
P-2 C=1:142,857
P-3 C=1:33,333
P-4 C=1:35,714
P-5 C=1:55,555
P-6 C=1:32,253
P-7 C=1:33,333