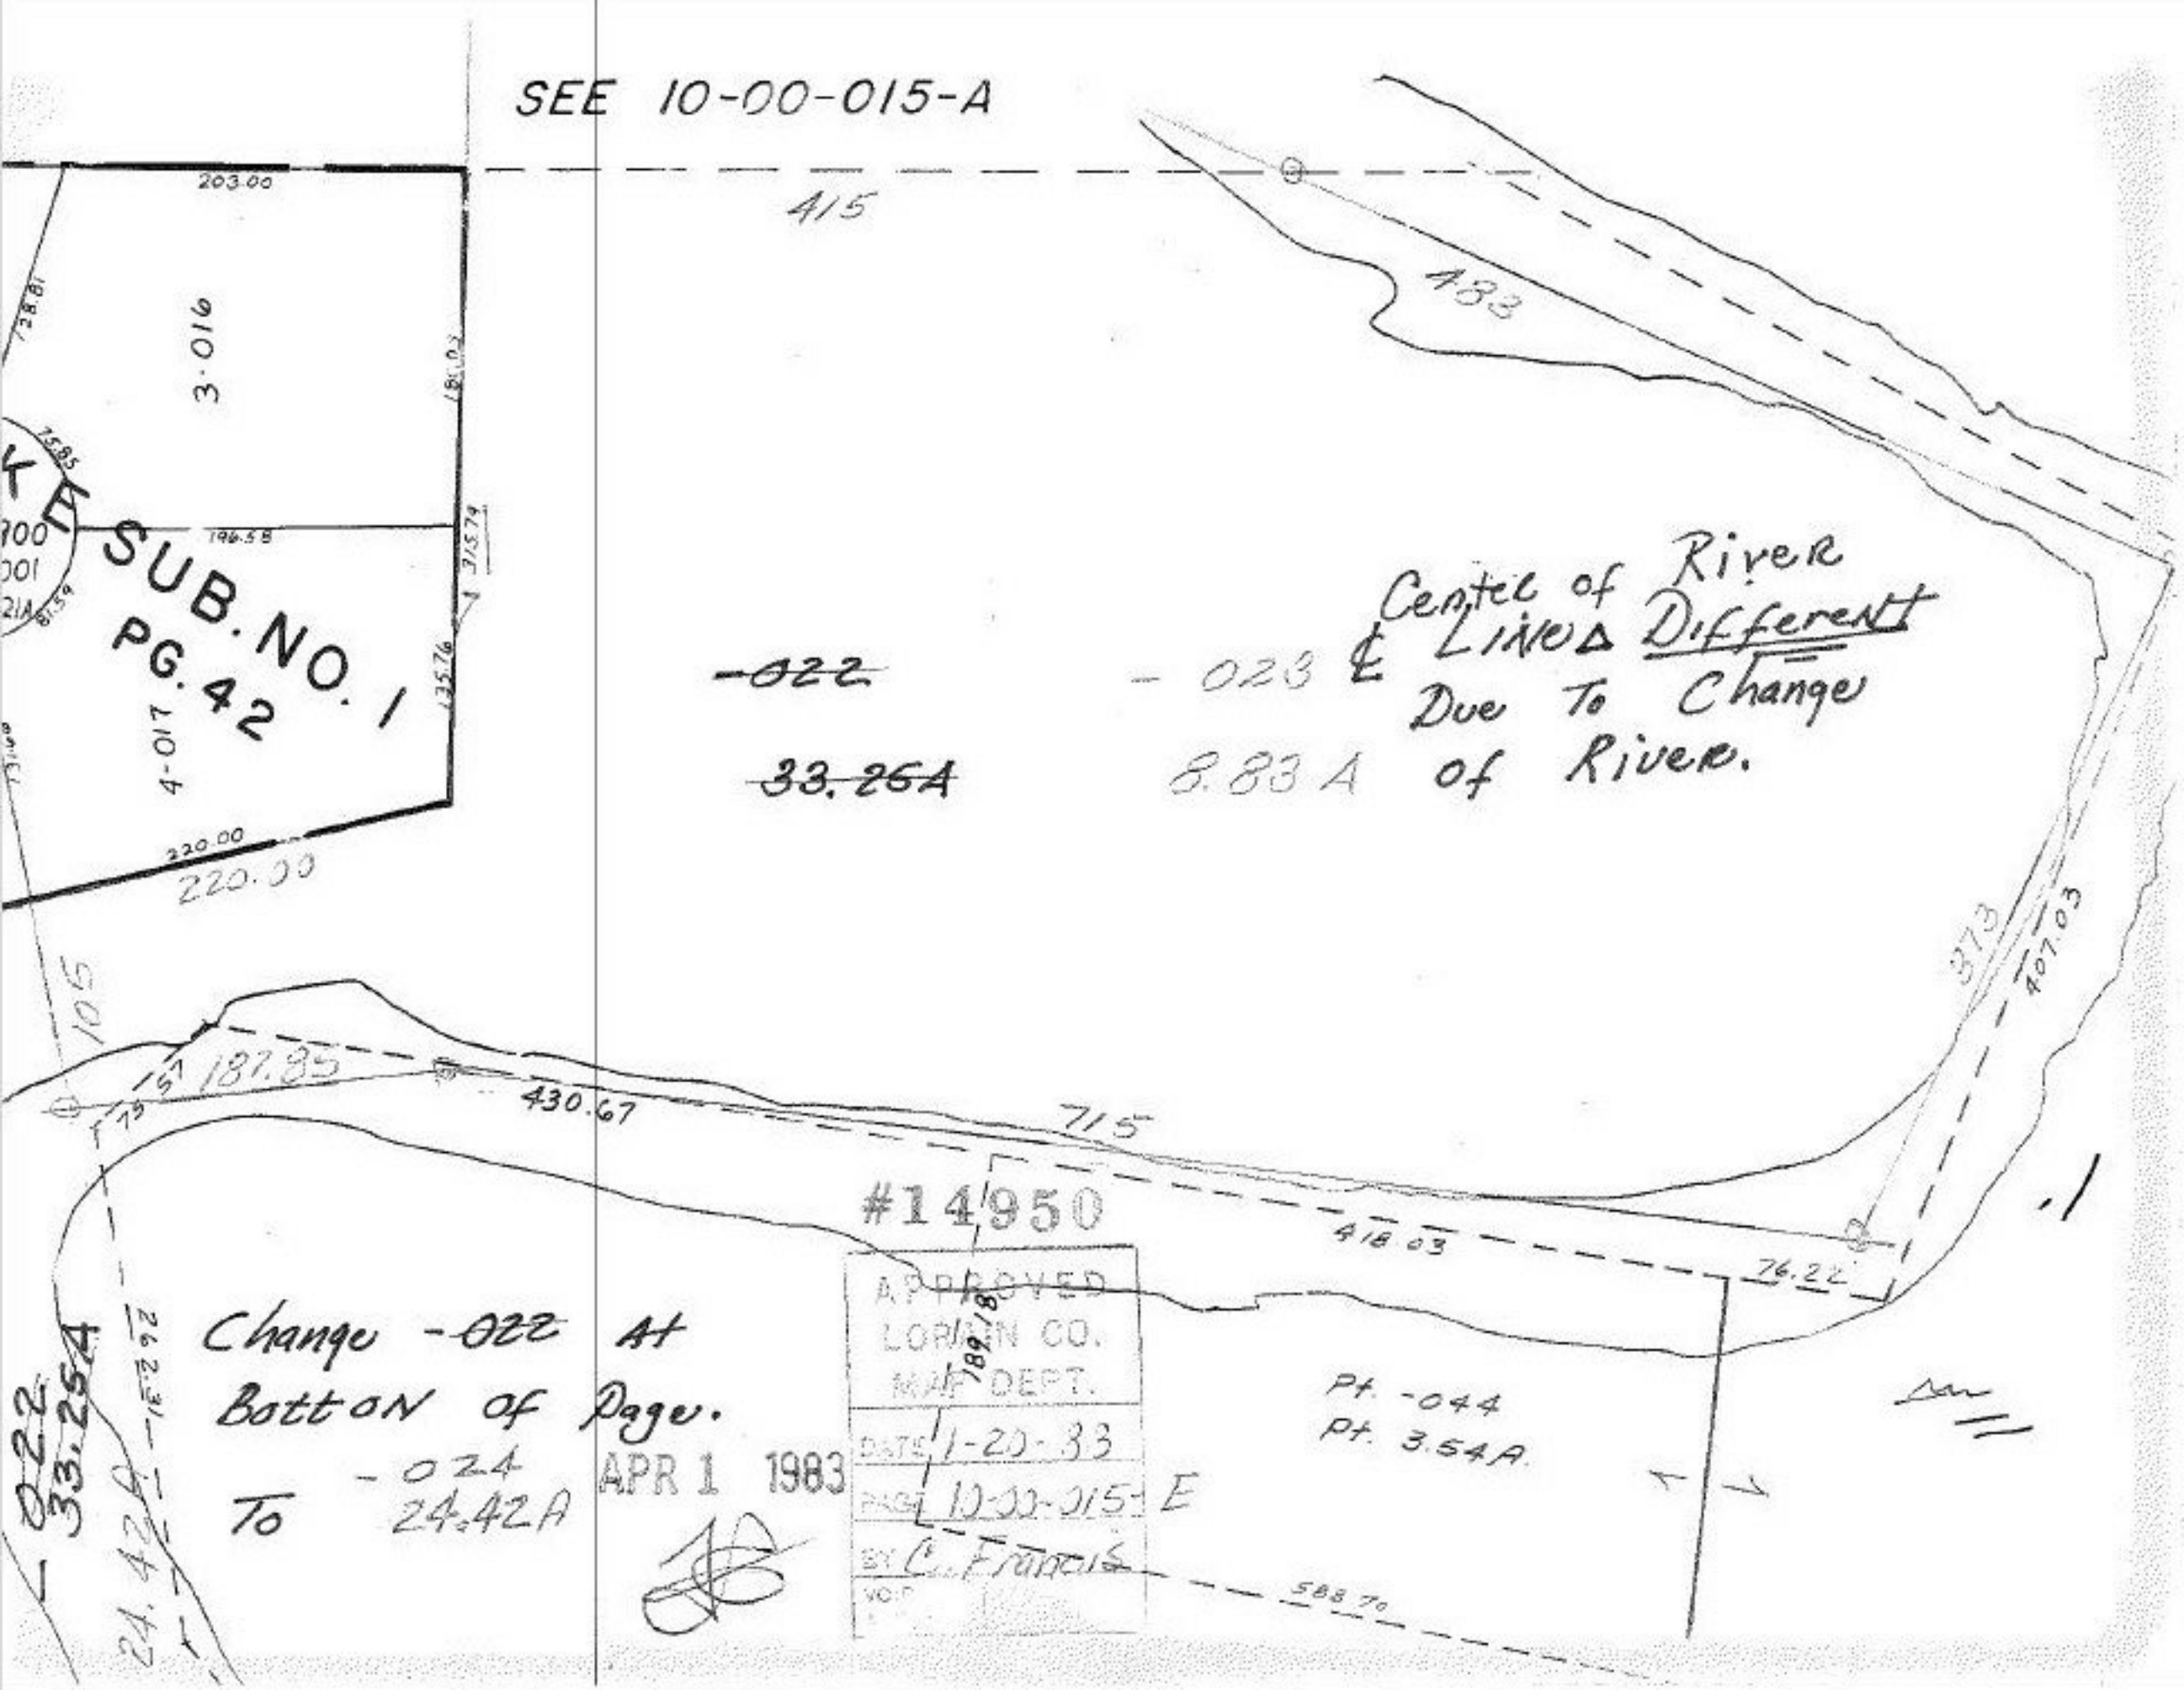
SEE 10-00-015-A
415
483
203.00
3.016
196.58
4-017
220.00
220.00
SUB. NO. 1
PG. 42
~~-022~~
~~33.26A~~
-023 ℄ Line Δ Different
Due To Change
8.83 A of River.
Center of River
373
407.03
105
187.85
430.67
715
418.03
76.22
#14950
APPROVED
LORAIN CO.
MAP DEPT.
DATE 1-20-83
PAGE 10-00-015-E
BY C. Francis
Pt. -044
Pt. 3.54A.
588.70
Change ~~-022~~ At
Bottom of Page.
To -024
24.42A
APR 1 1983
-022
33.25A
24.42A