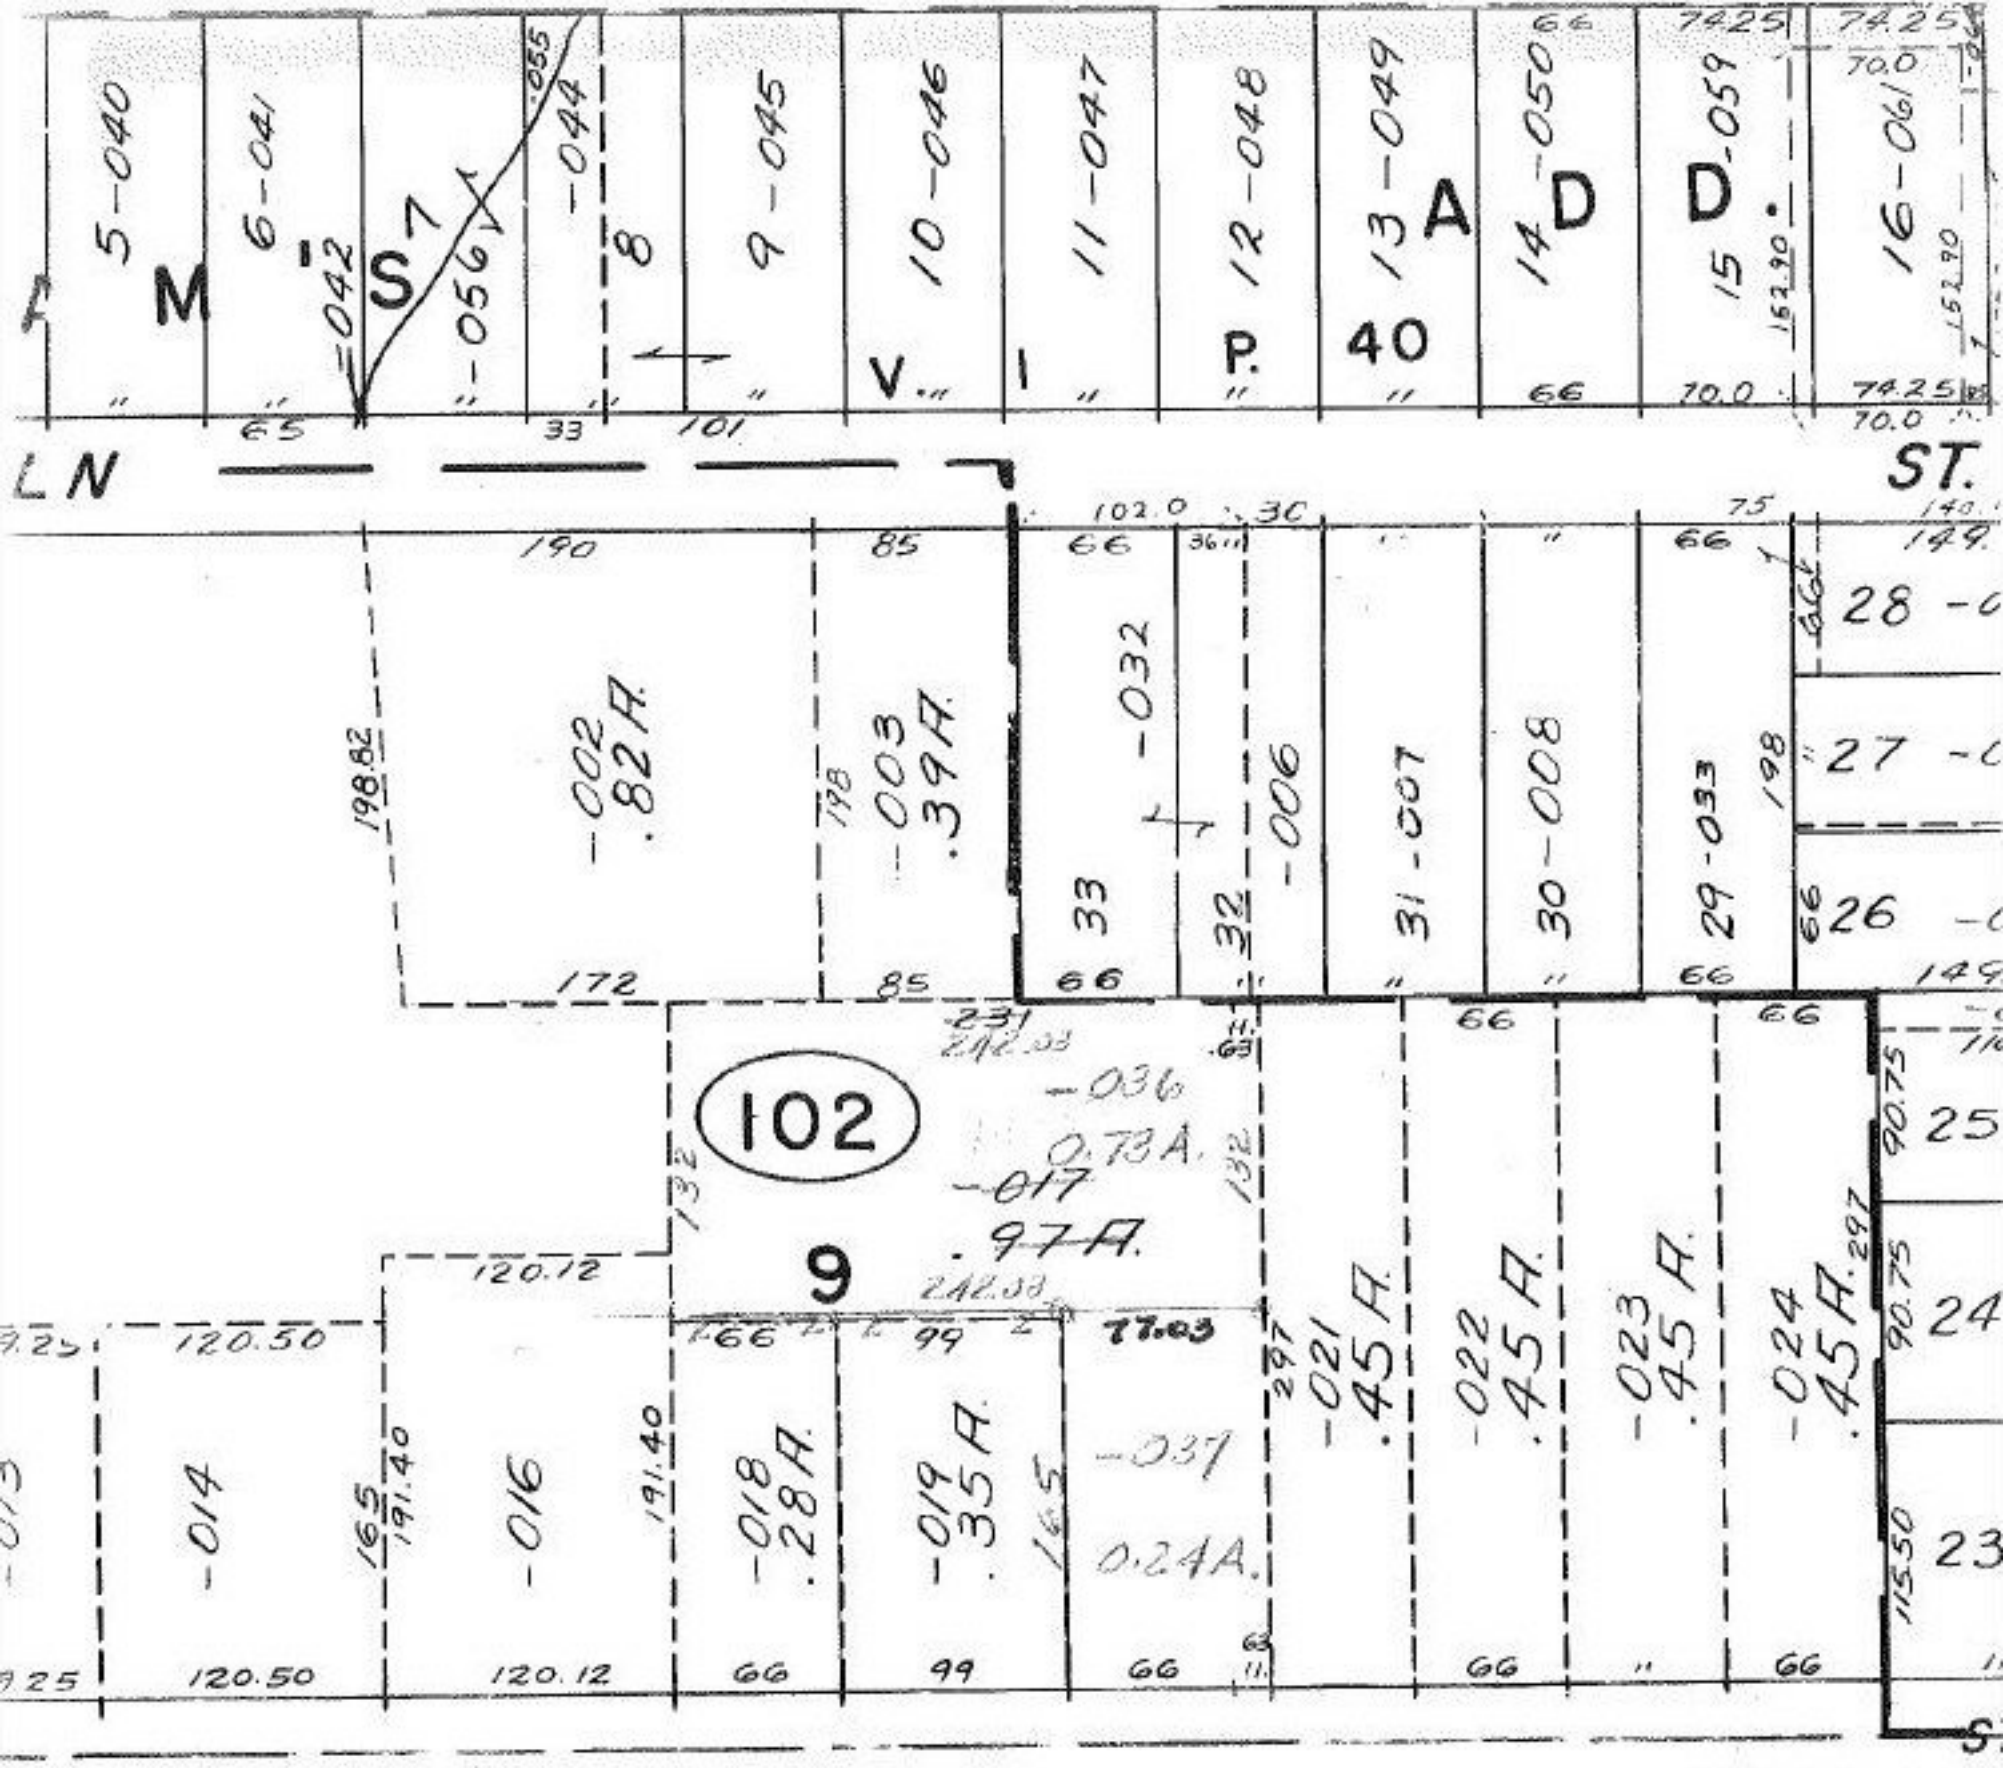

SEE 18-00-021-C

#14968

MAP Description

APR 1 1983

2-24-83

APPROVED
LORAIN CO.
MAP DEPT.
DATE 2-7-83
PAGE 18-00-021-A
BY C. Francis
VOID AFTER
TW

WELLINGTON

SCALE: 1" = 100'