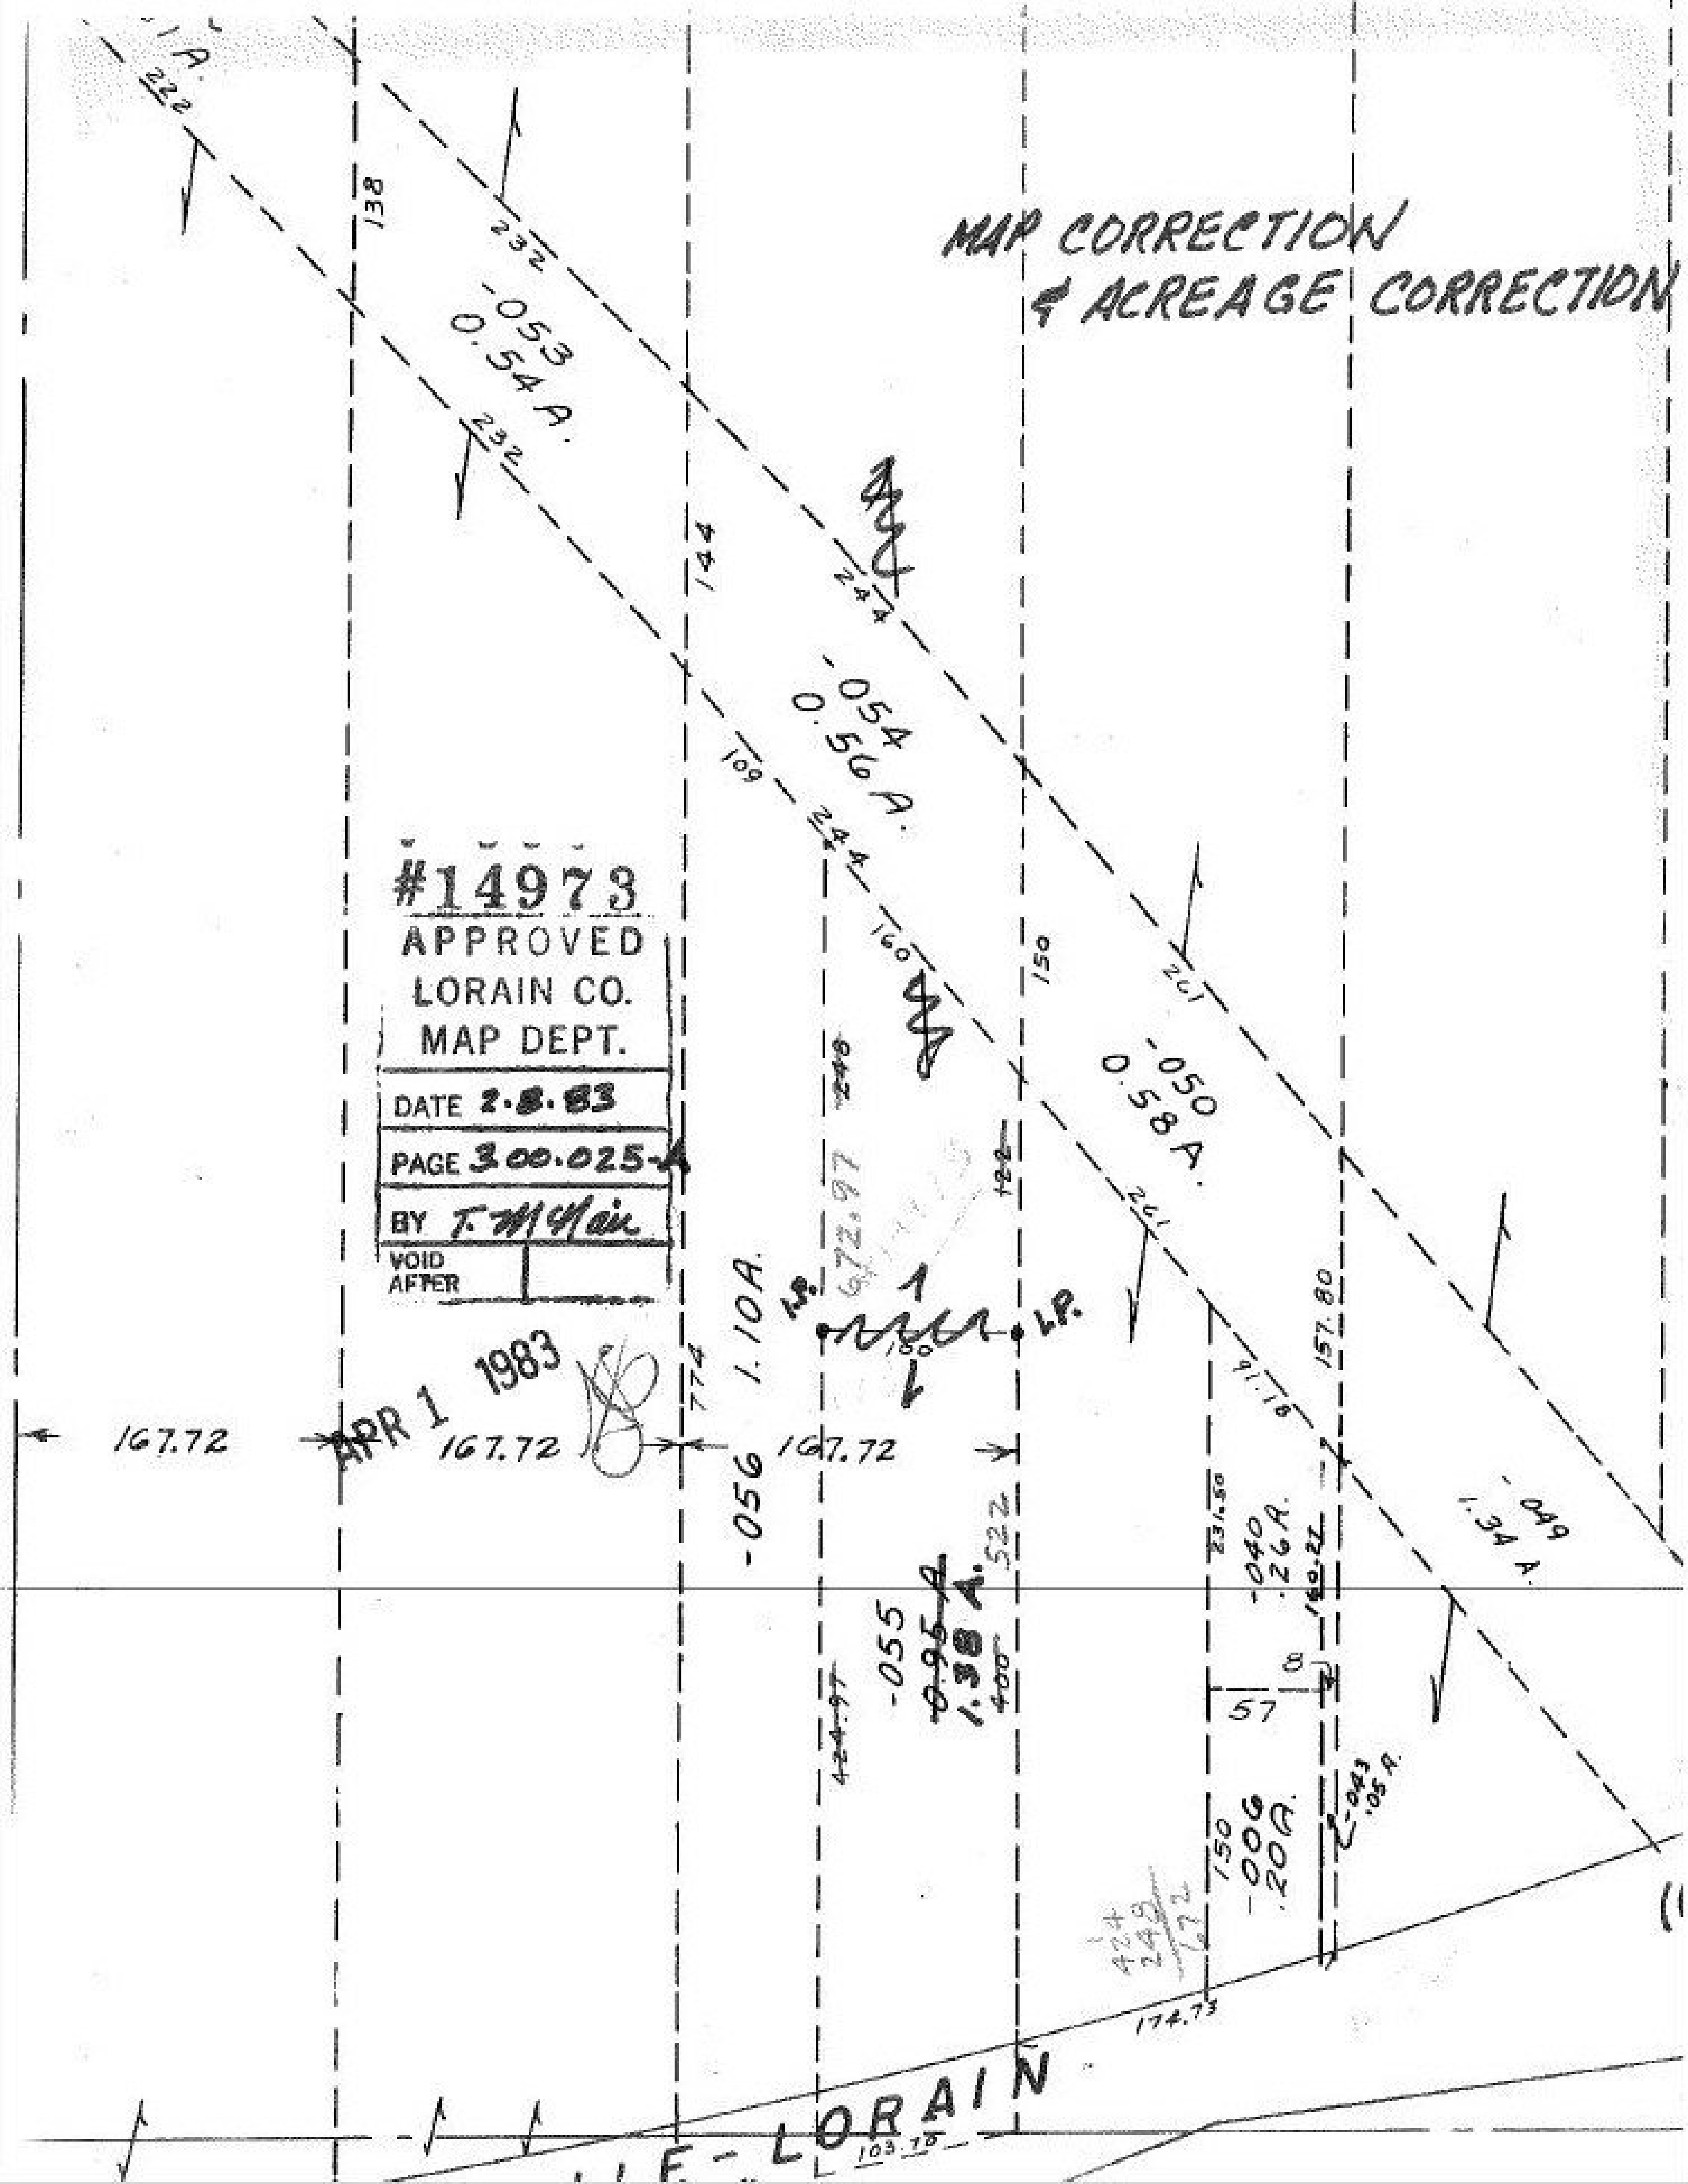
MAP CORRECTION
& ACREAGE CORRECTION
#14973
APPROVED
LORAIN CO.
MAP DEPT.
DATE 2-8-83
PAGE 300.025-A
VOID AFTER
APR 1 1983
-053
0.54 A.
-054
0.56 A.
-050
0.58 A.
-049
1.34 A.
-056
1.10 A.
-055
0.95 A.
1.38 A.
-040
.26 A.
-006
.20 A.
-043
.05 A.
167.72
167.72
167.72
174.73
157.80
231.50
91.18
57
138
144
150
232
232
244
244
160
109
201
201
222
774
522
400
424.97
160.22
103.15
I.P.
I.P.
LORAIN