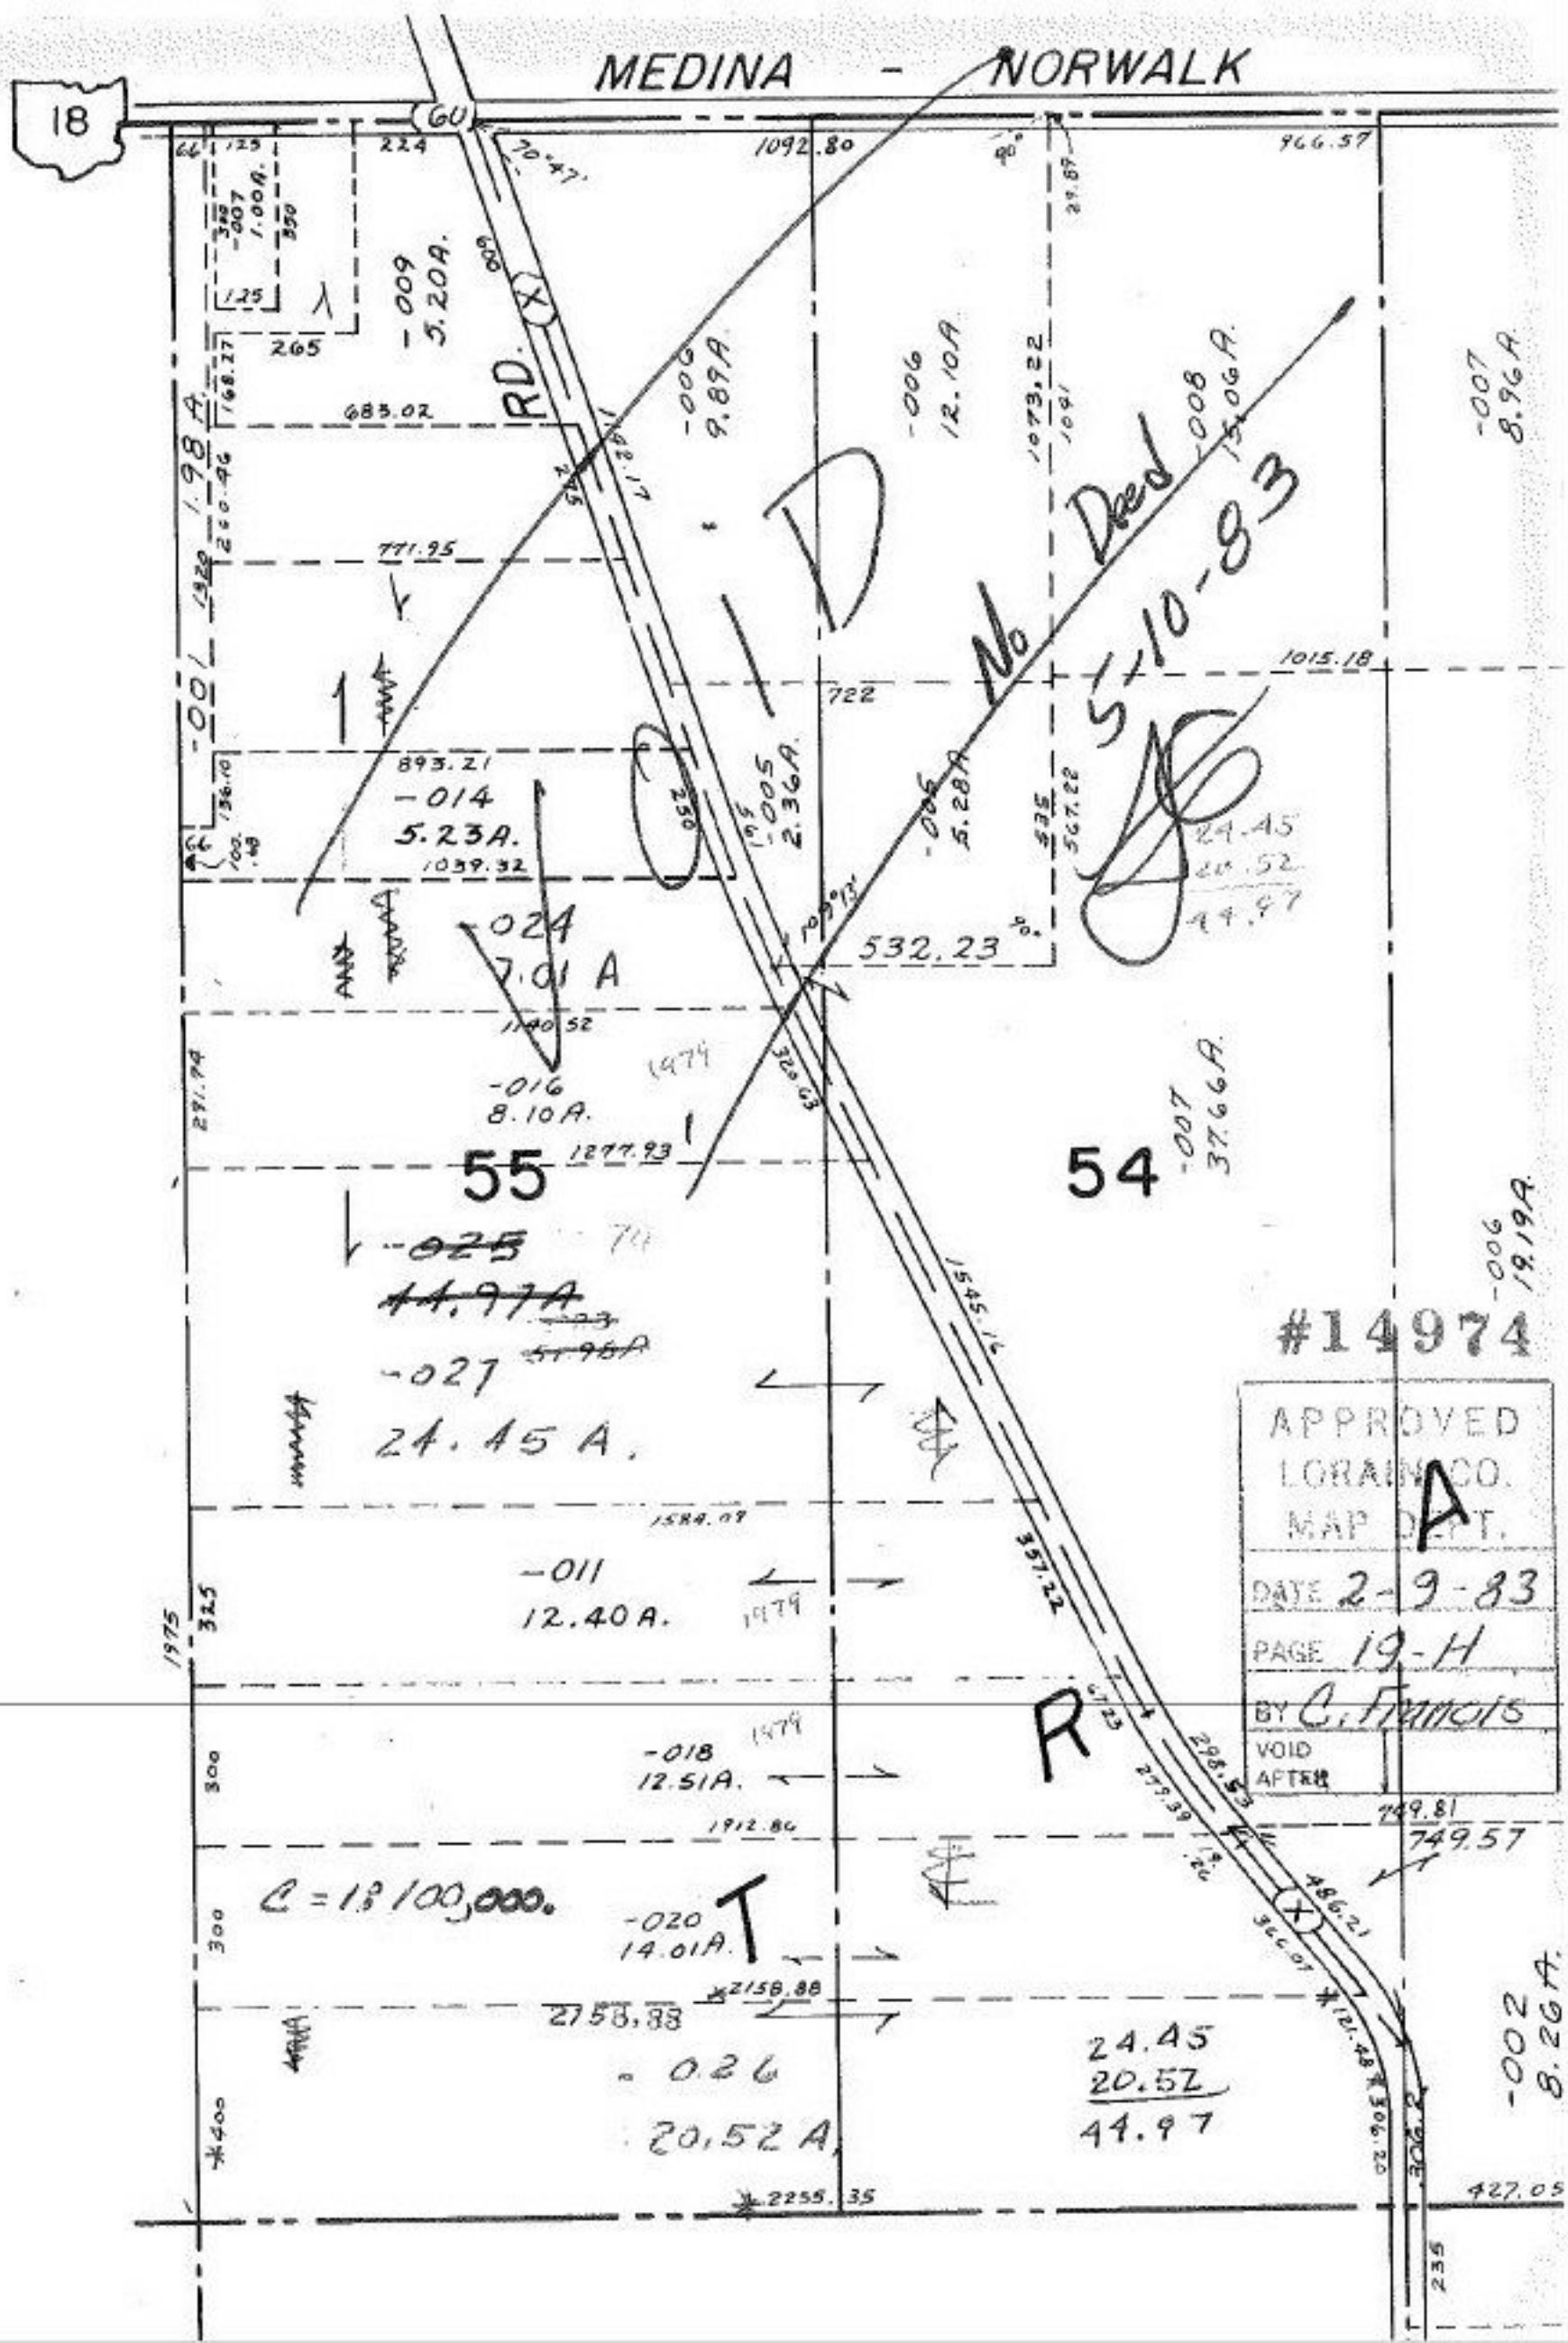

MEDINA - NORWALK
18
60
RD.
-009
5.20A.
-006
9.89A.
-006
12.10A.
-008
15.06A.
-007
8.96A.
-001
1.98A.
-014
5.23A.
-024
7.01 A
-016
8.10A.
-005
2.36A.
-005
5.28A.
No Deed
5-10-83
24.45
20.52
44.97
532.23
55
54
-007
37.66A.
-006
19.19A.
-025
44.97A
-027
24.45 A.
-011
12.40A.
-018
12.51A.
-020
14.01A.
C = 18,100,000.
-026
20.52 A.
24.45
20.52
44.97
-002
8.26A.
749.57
#14974
APPROVED
LORAIN CO.
MAP DEPT.
DATE 2-9-83
PAGE 19-H
BY C. Francis
VOID
AFTER