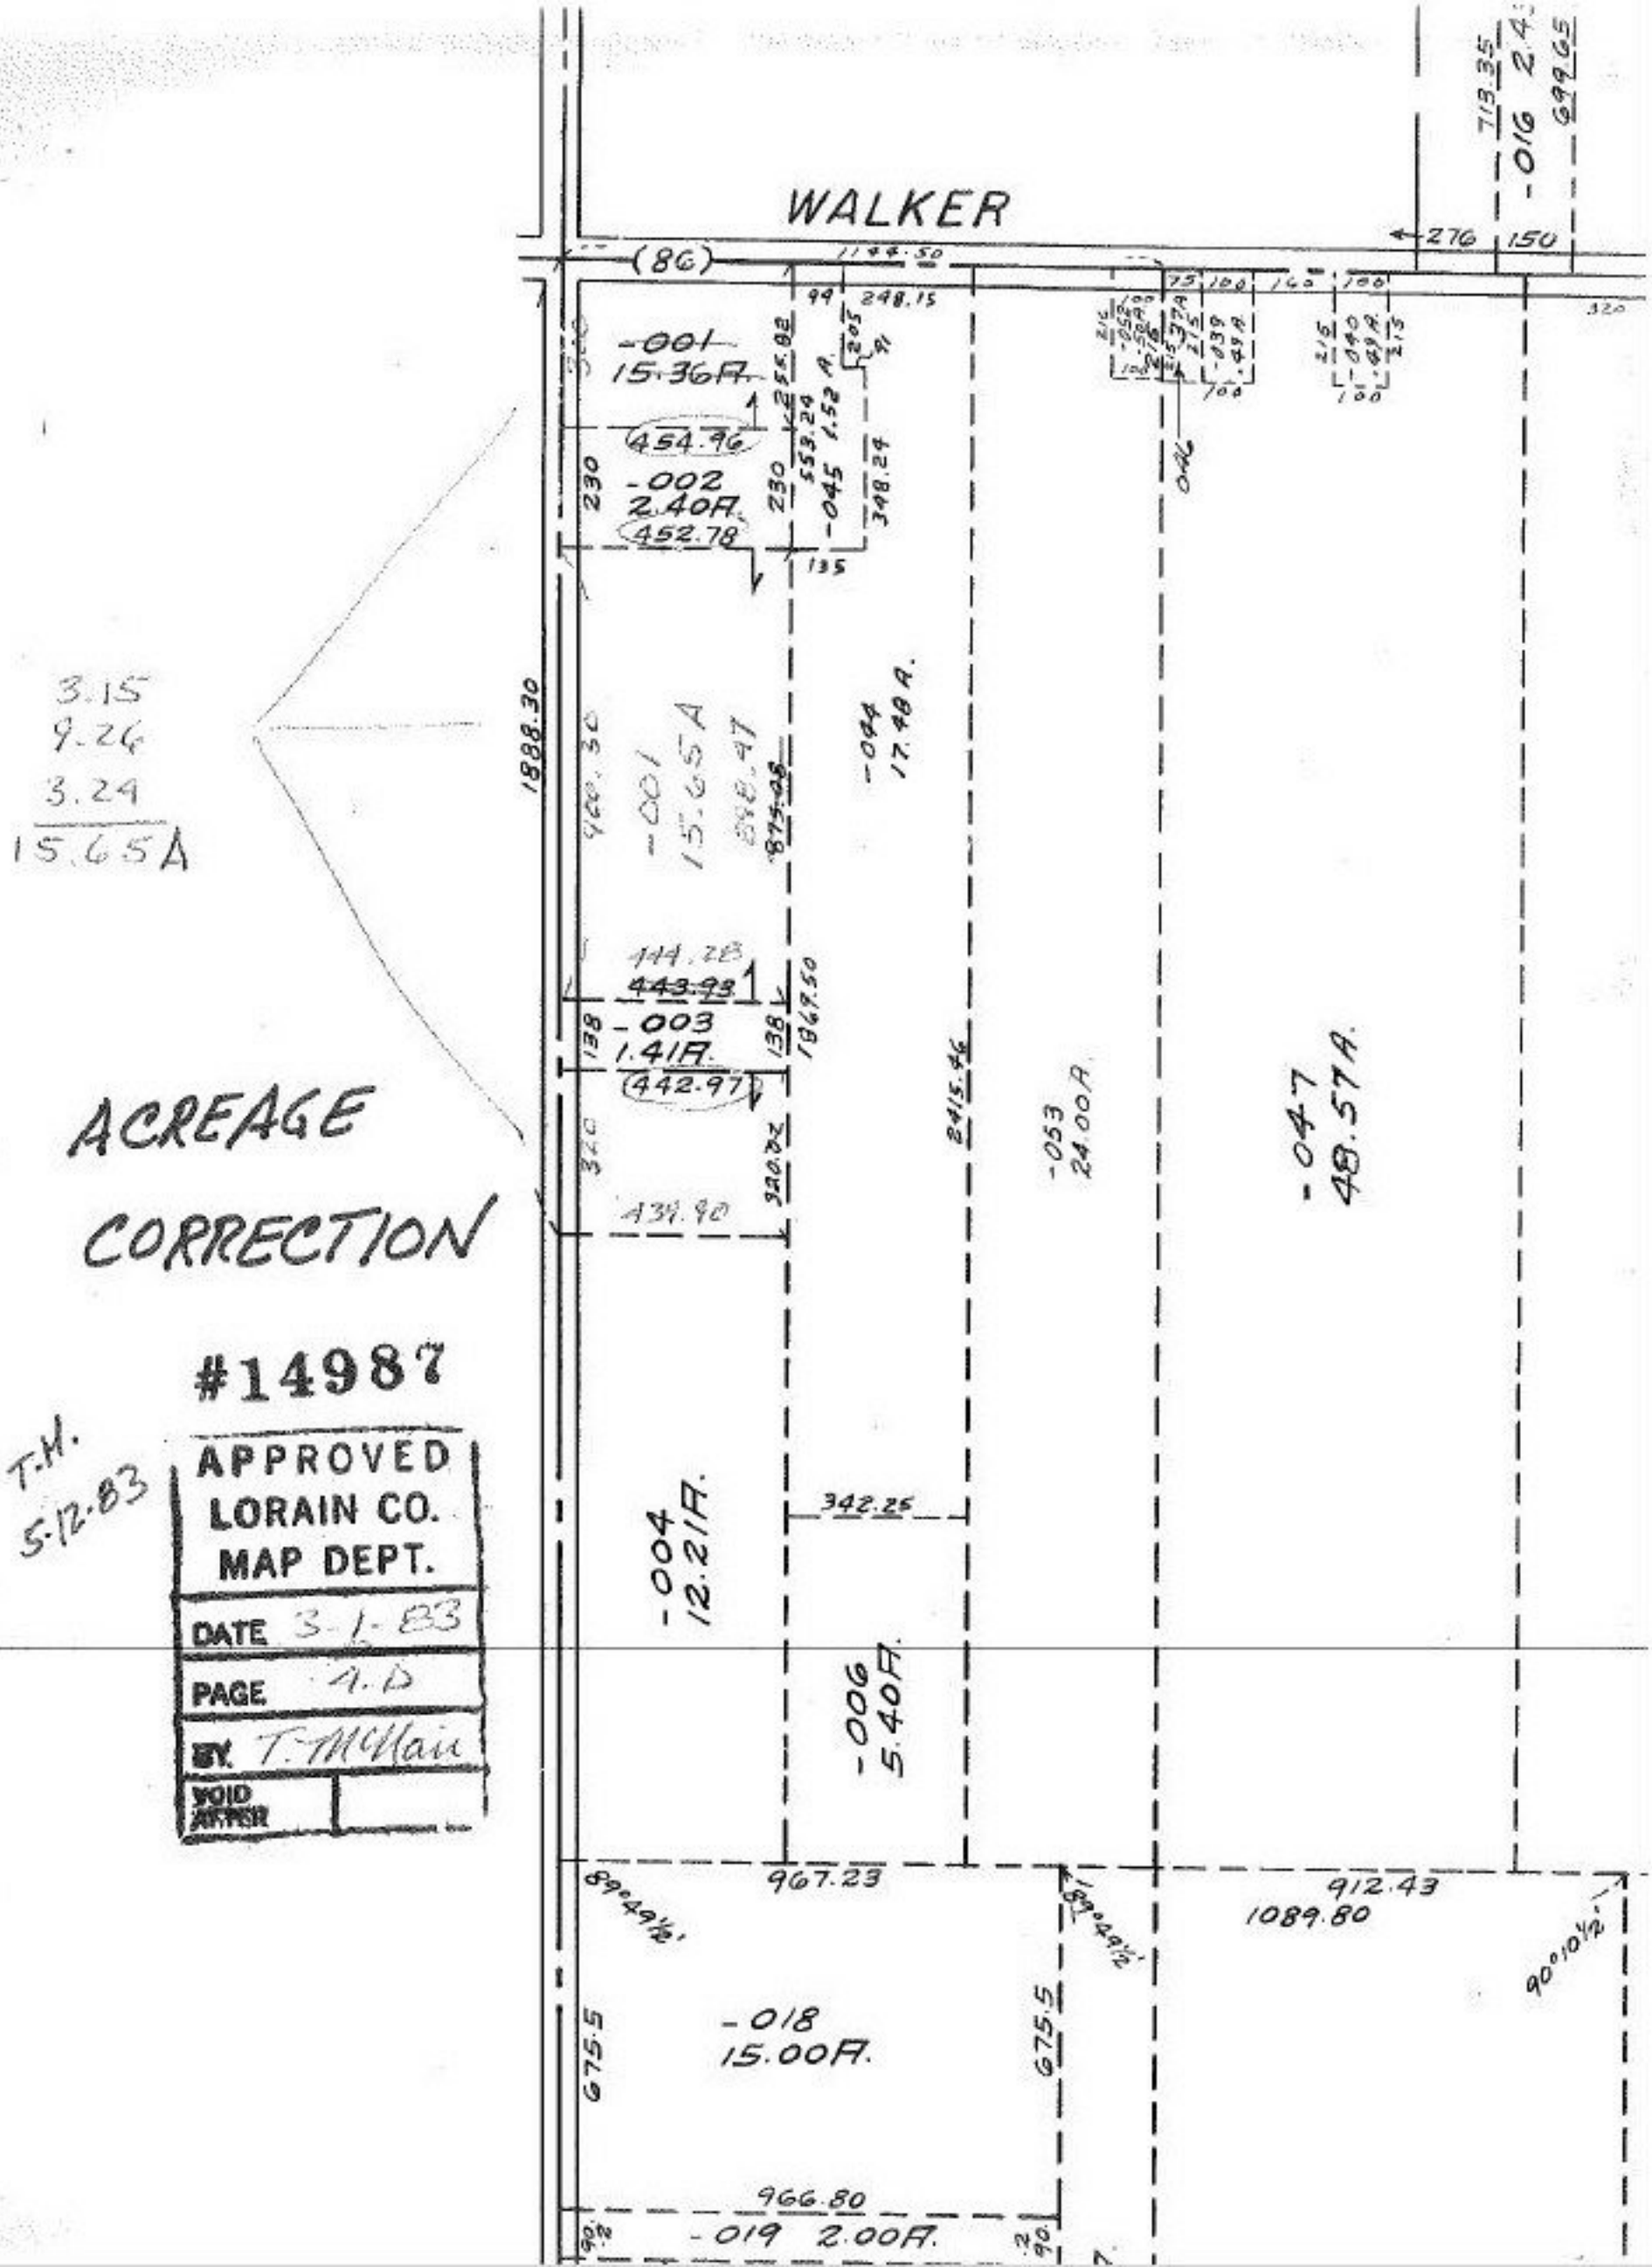
WALKER
(86)
1144.50
248.15
-001
15.36A.
454.96
-002
2.40A.
452.78
553.24
1.52 A.
-045
348.24
230
135
1888.30
-044
17.48 A.
-001
15.65A
888.47
444.28
443.93
-003
1.41A.
(442.97)
1867.50
138
320
439.90
2415.46
-053
24.00A.
-047
48.57A.
-004
12.21A.
342.25
-006
5.40A.
967.23
912.43
1089.80
-018
15.00A.
675.5
966.80
-019 2.00A.
713.35
-016 2.4
699.65
276
150
320
3.15
9.26
3.24
15.65A
ACREAGE
CORRECTION
#14987
T.H.
5-12-83
APPROVED
LORAIN CO.
MAP DEPT.
DATE 3-1-83
PAGE 4.D
BY T. McHain
VOID AFTER