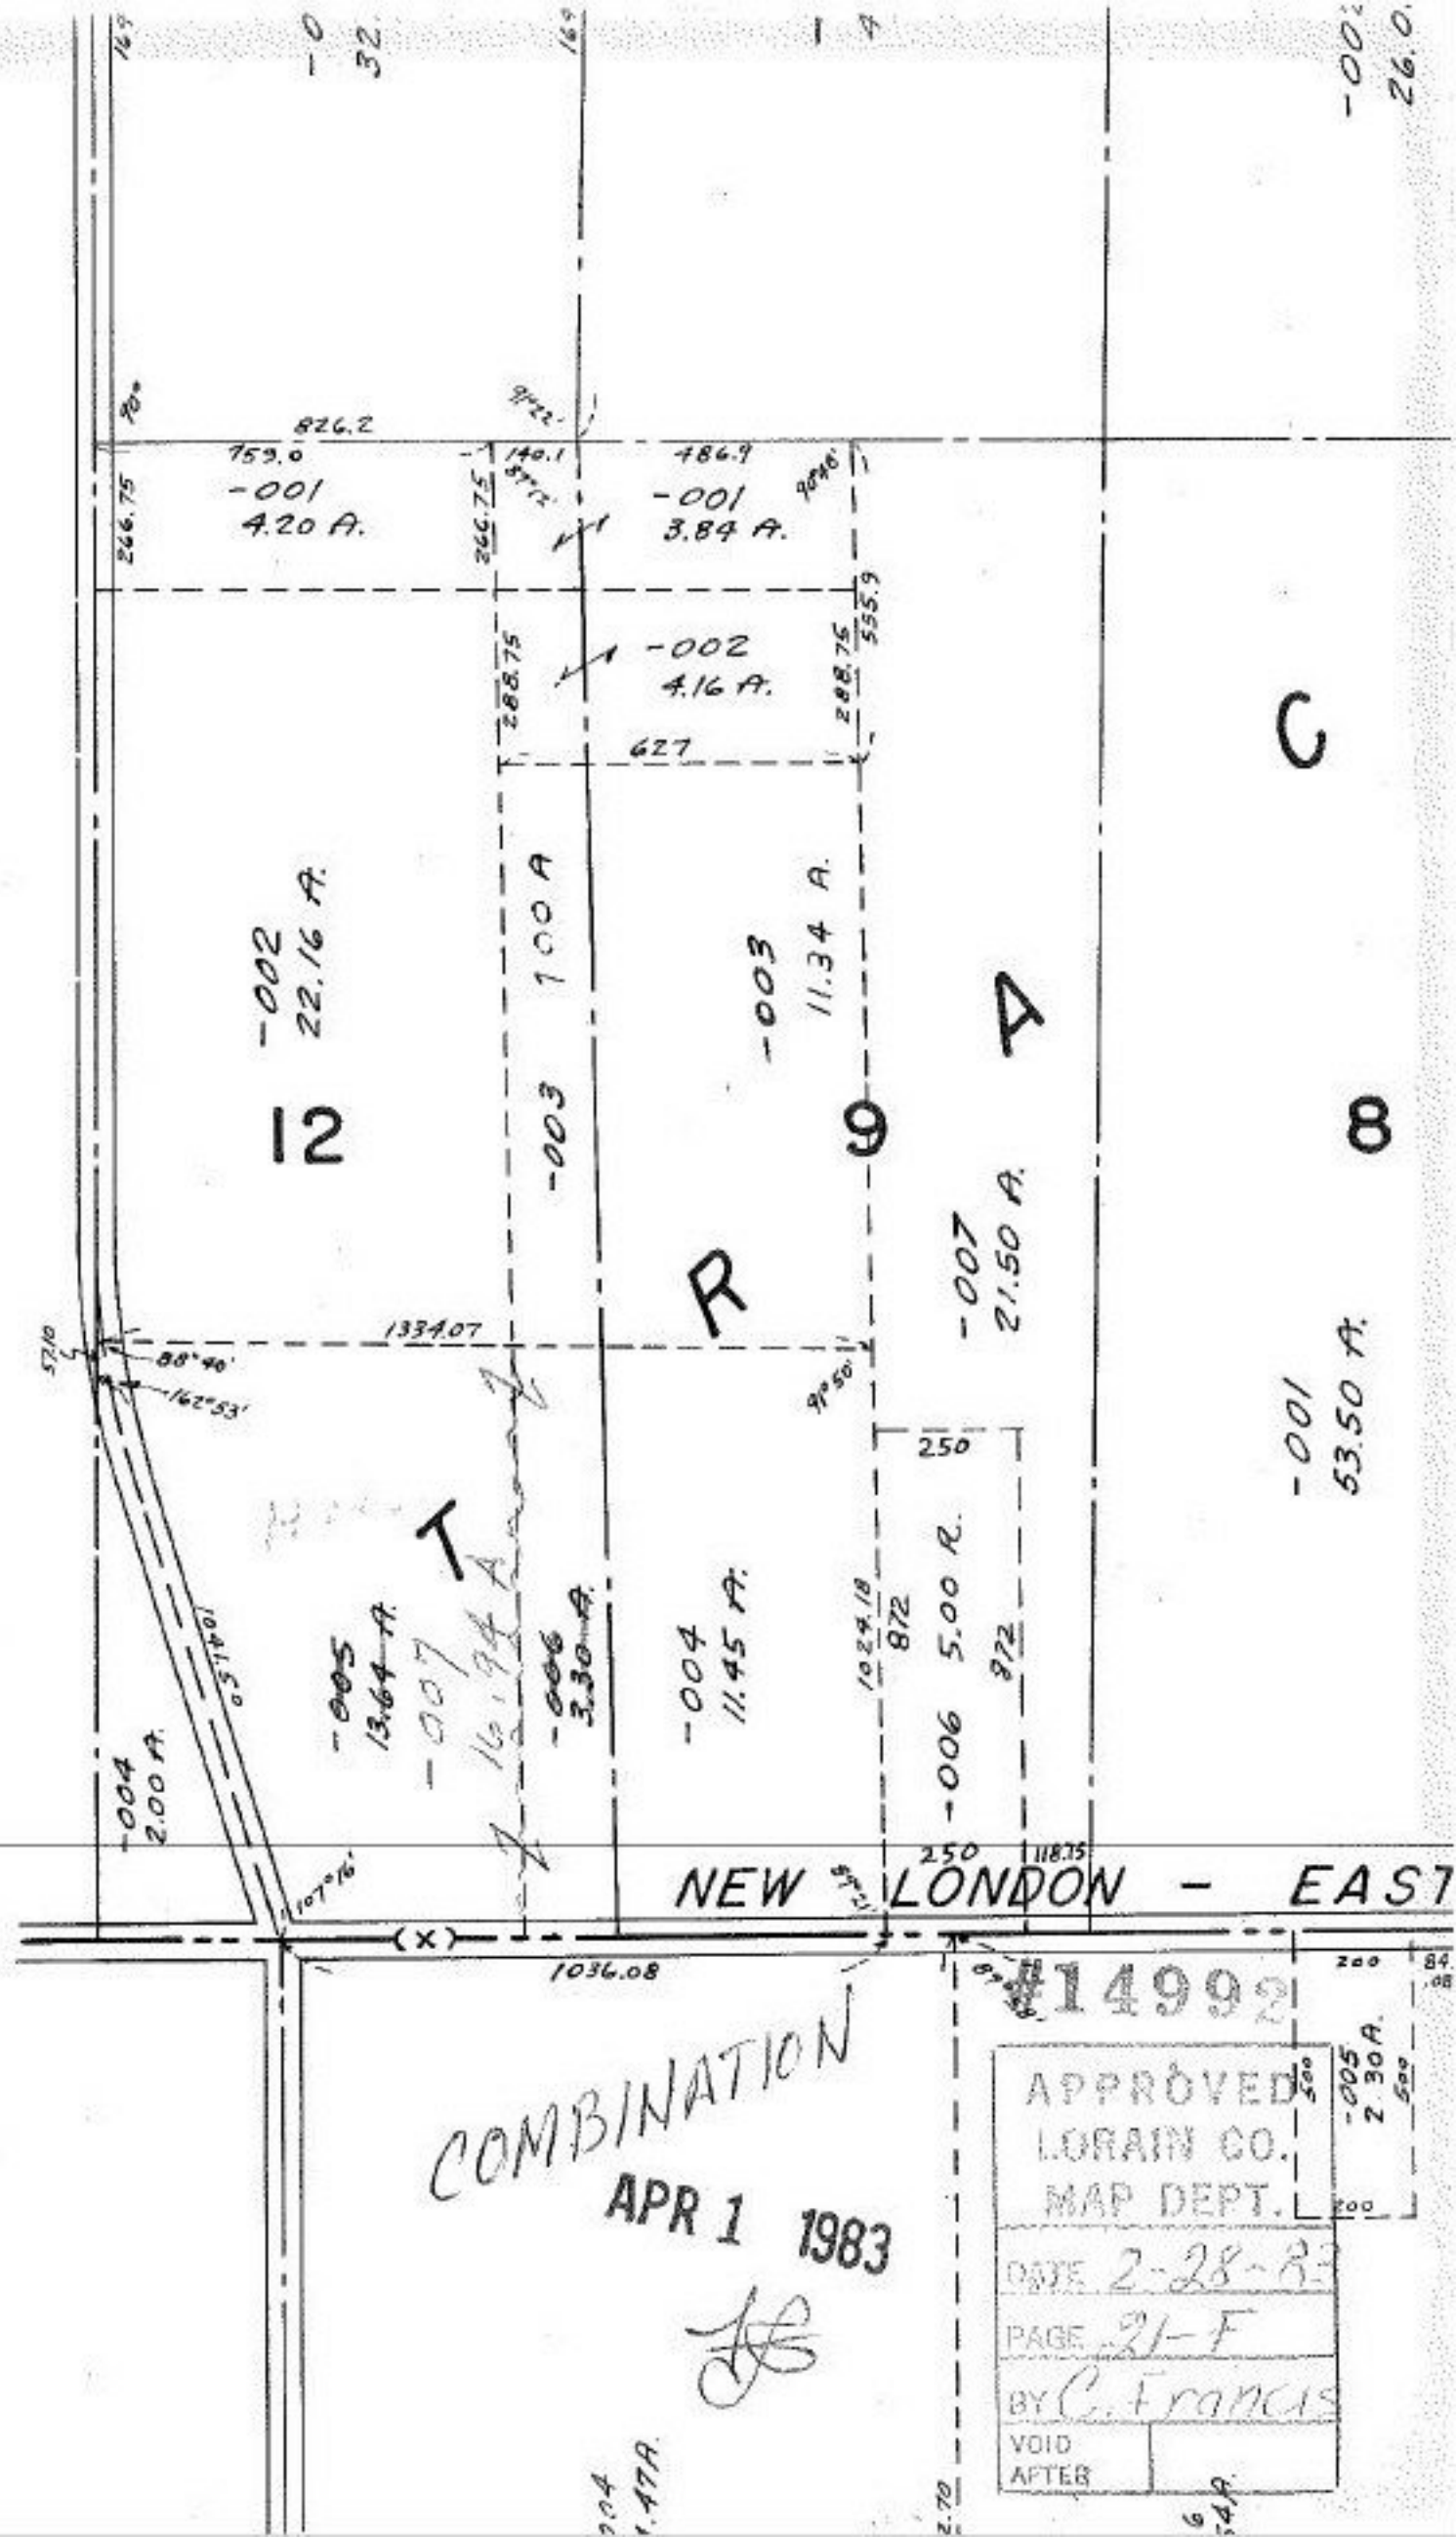

826.2
759.0
140.1
486.9
-001
4.20 A.
-001
3.84 A.
266.75
266.75
-002
4.16 A.
288.75
288.75
555.9
627
-002
22.16 A.
-003
11.34 A.
-003
12
9
8
C
A
R
T
-007
21.50 A.
-001
53.50 A.
1334.07
88°40'
162°53'
250
-005
13.64 A.
-007
16.94 A.
-006
3.30 A.
-004
11.45 A.
-006
5.00 A.
1024.18
872
872
-004
2.00 A.
1041.50
250
118.75
NEW LONDON - EAST
1036.08
#14992
COMBINATION
APR 1 1983
APPROVED
LORAIN CO.
MAP DEPT.
DATE 2-28-83
PAGE 21-F
BY C. Francis
VOID
AFTER
-005
2.30 A.