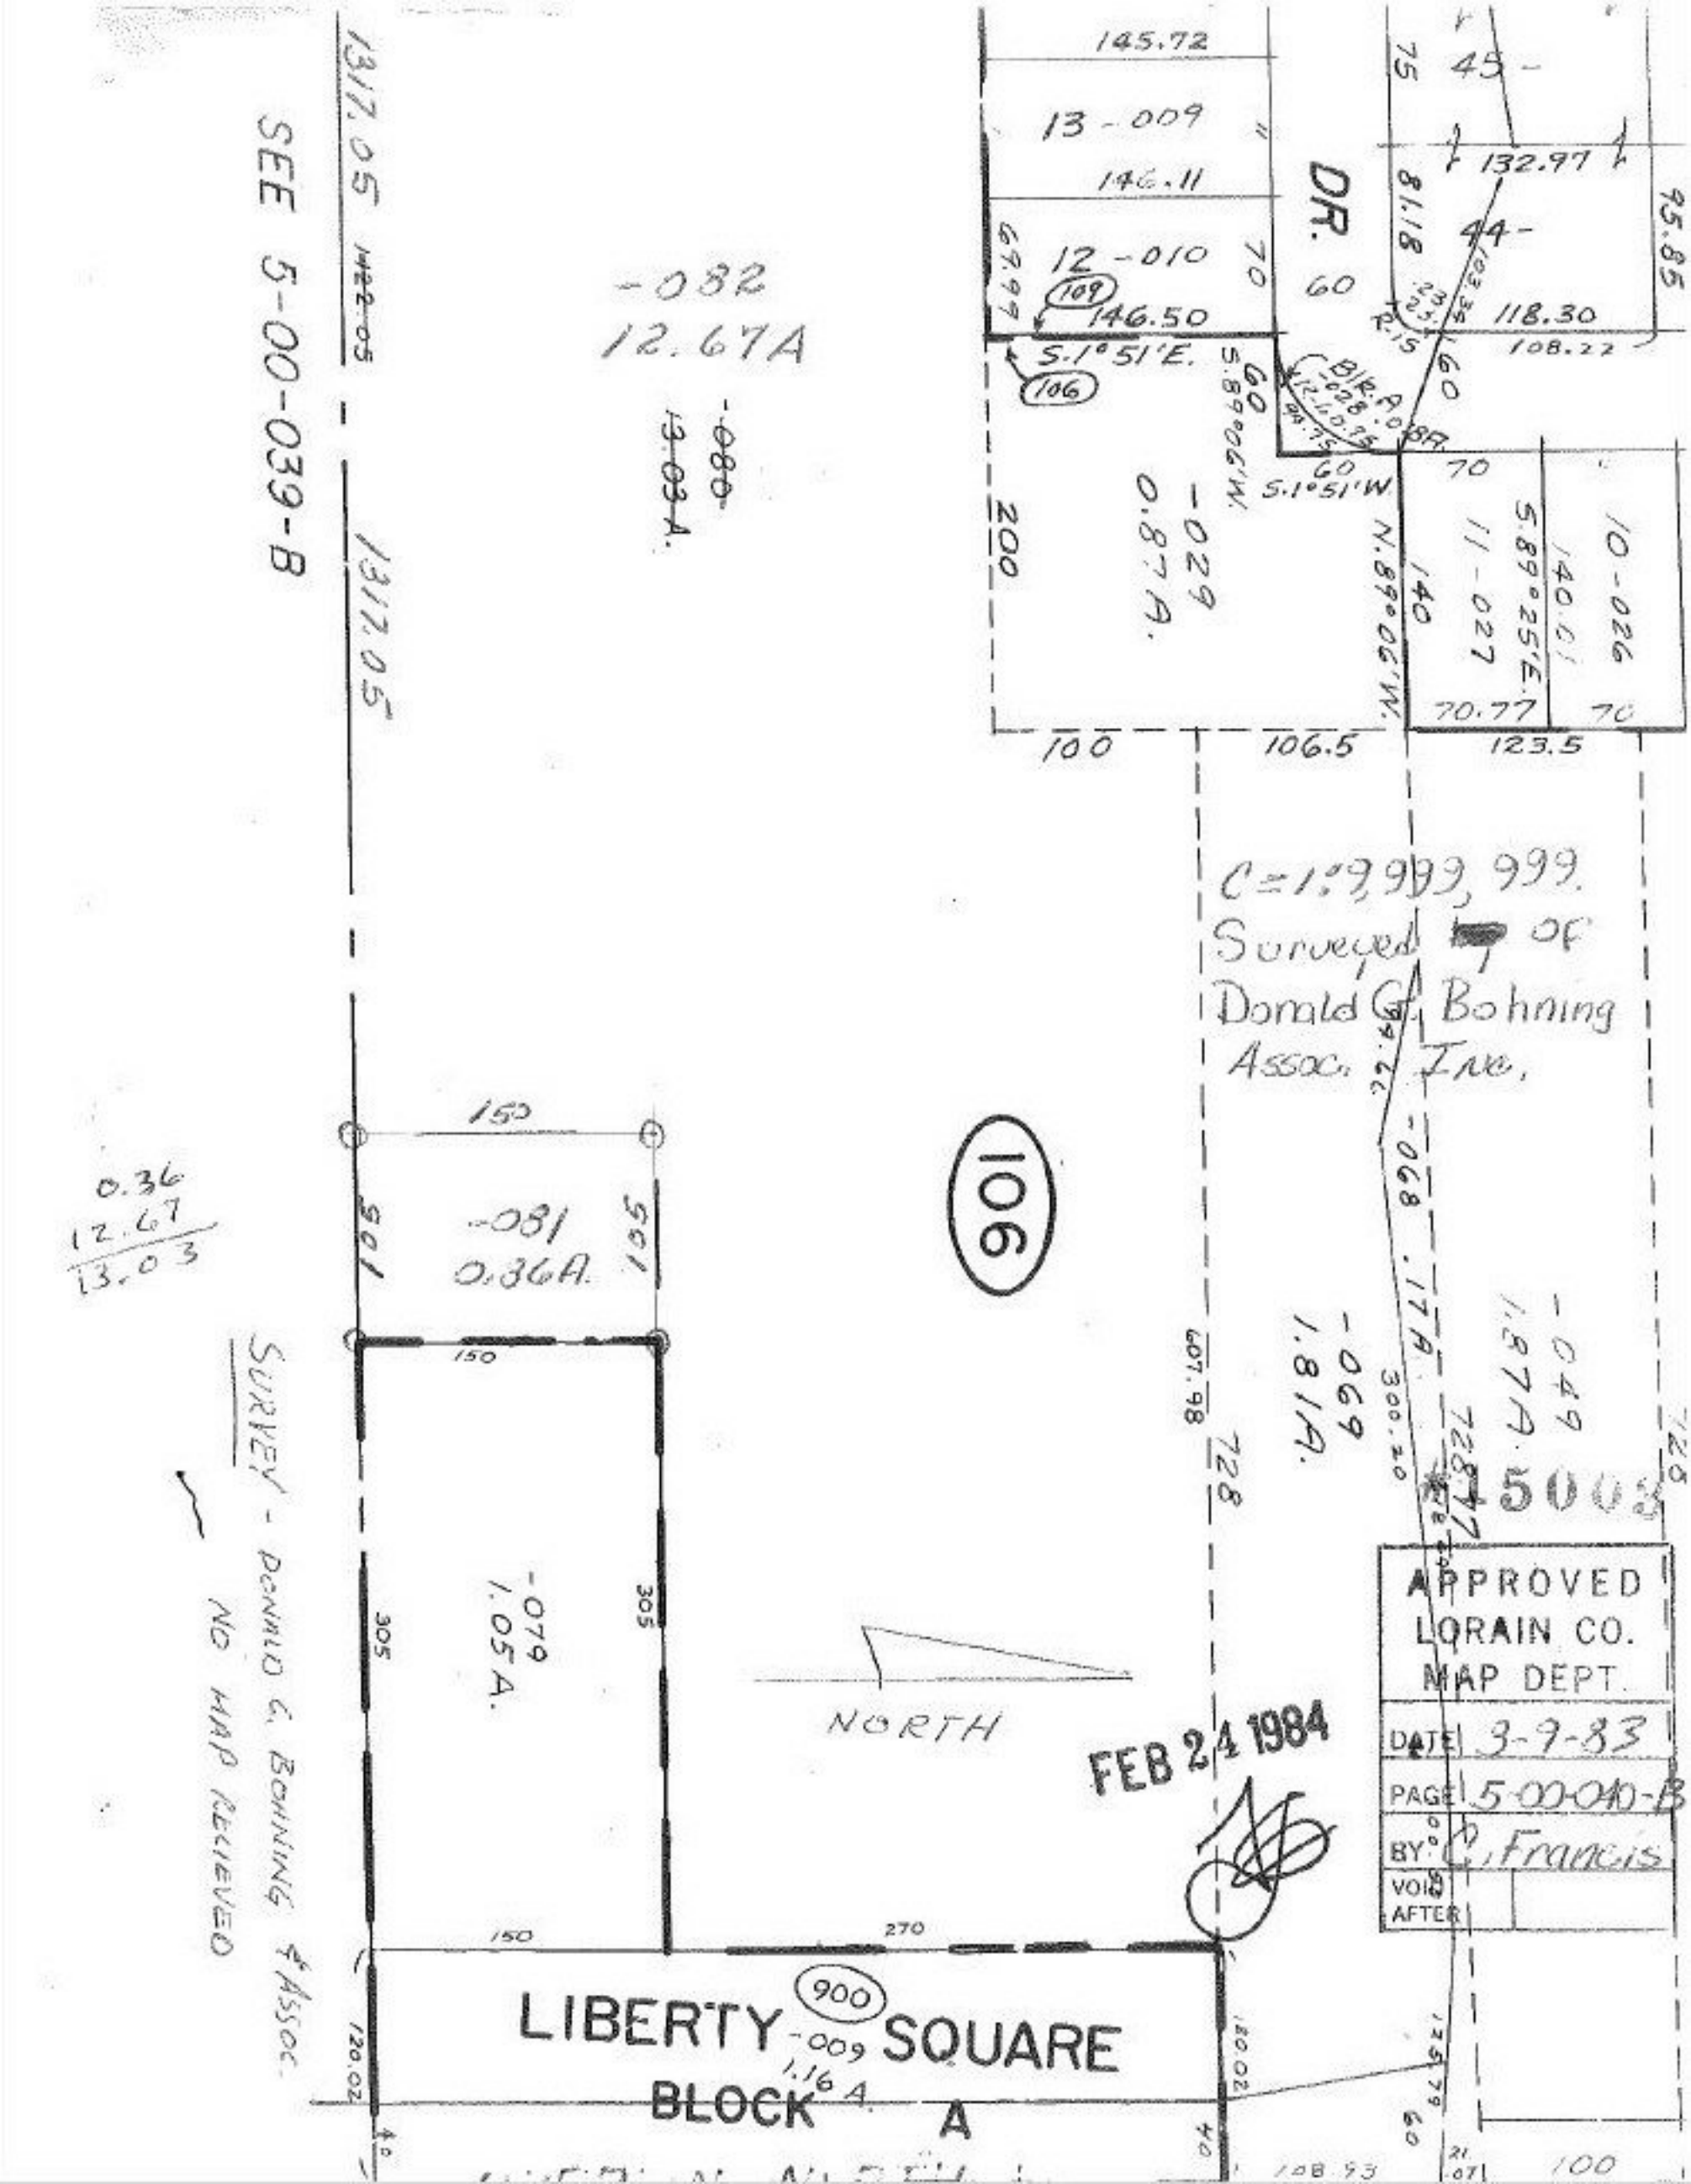

SEE 5-00-039-B
1317.05
1317.05
-082
12.67A
-080
13.03A.
145.72
13-009
146.11
12-010
146.50
109
106
S.1°51'E.
DR.
60
45-
132.97
44-
118.30
108.22
95.85
81.18
S.89°06'W.
S.1°51'W.
-029
0.87A.
200
N.89°06'W.
140
11-027
S.89°25'E.
140.01
10-026
70.77
70
100
106.5
123.5
C=1:9,999,999.
Surveyed of
Donald G. Bohning
Assoc. Inc.
150
-081
0.36A.
105
105
0.36
12.67
13.03
106
-068
.17A.
-069
1.81A.
-049
1.87A.
728
728
607.98
300.20
SURVEY - DONALD G. BOHNING & ASSOC.
NO MAP RECIEVED
305
305
-079
1.05A.
NORTH
FEB 24 1984
APPROVED
LORAIN CO.
MAP DEPT.
DATE 3-9-83
PAGE 5-00-040-B
BY C. Francis
VOID AFTER
150
270
LIBERTY SQUARE
900
-009
1.16 A.
BLOCK A
120.02
120.02
40
40
60
108.93
100