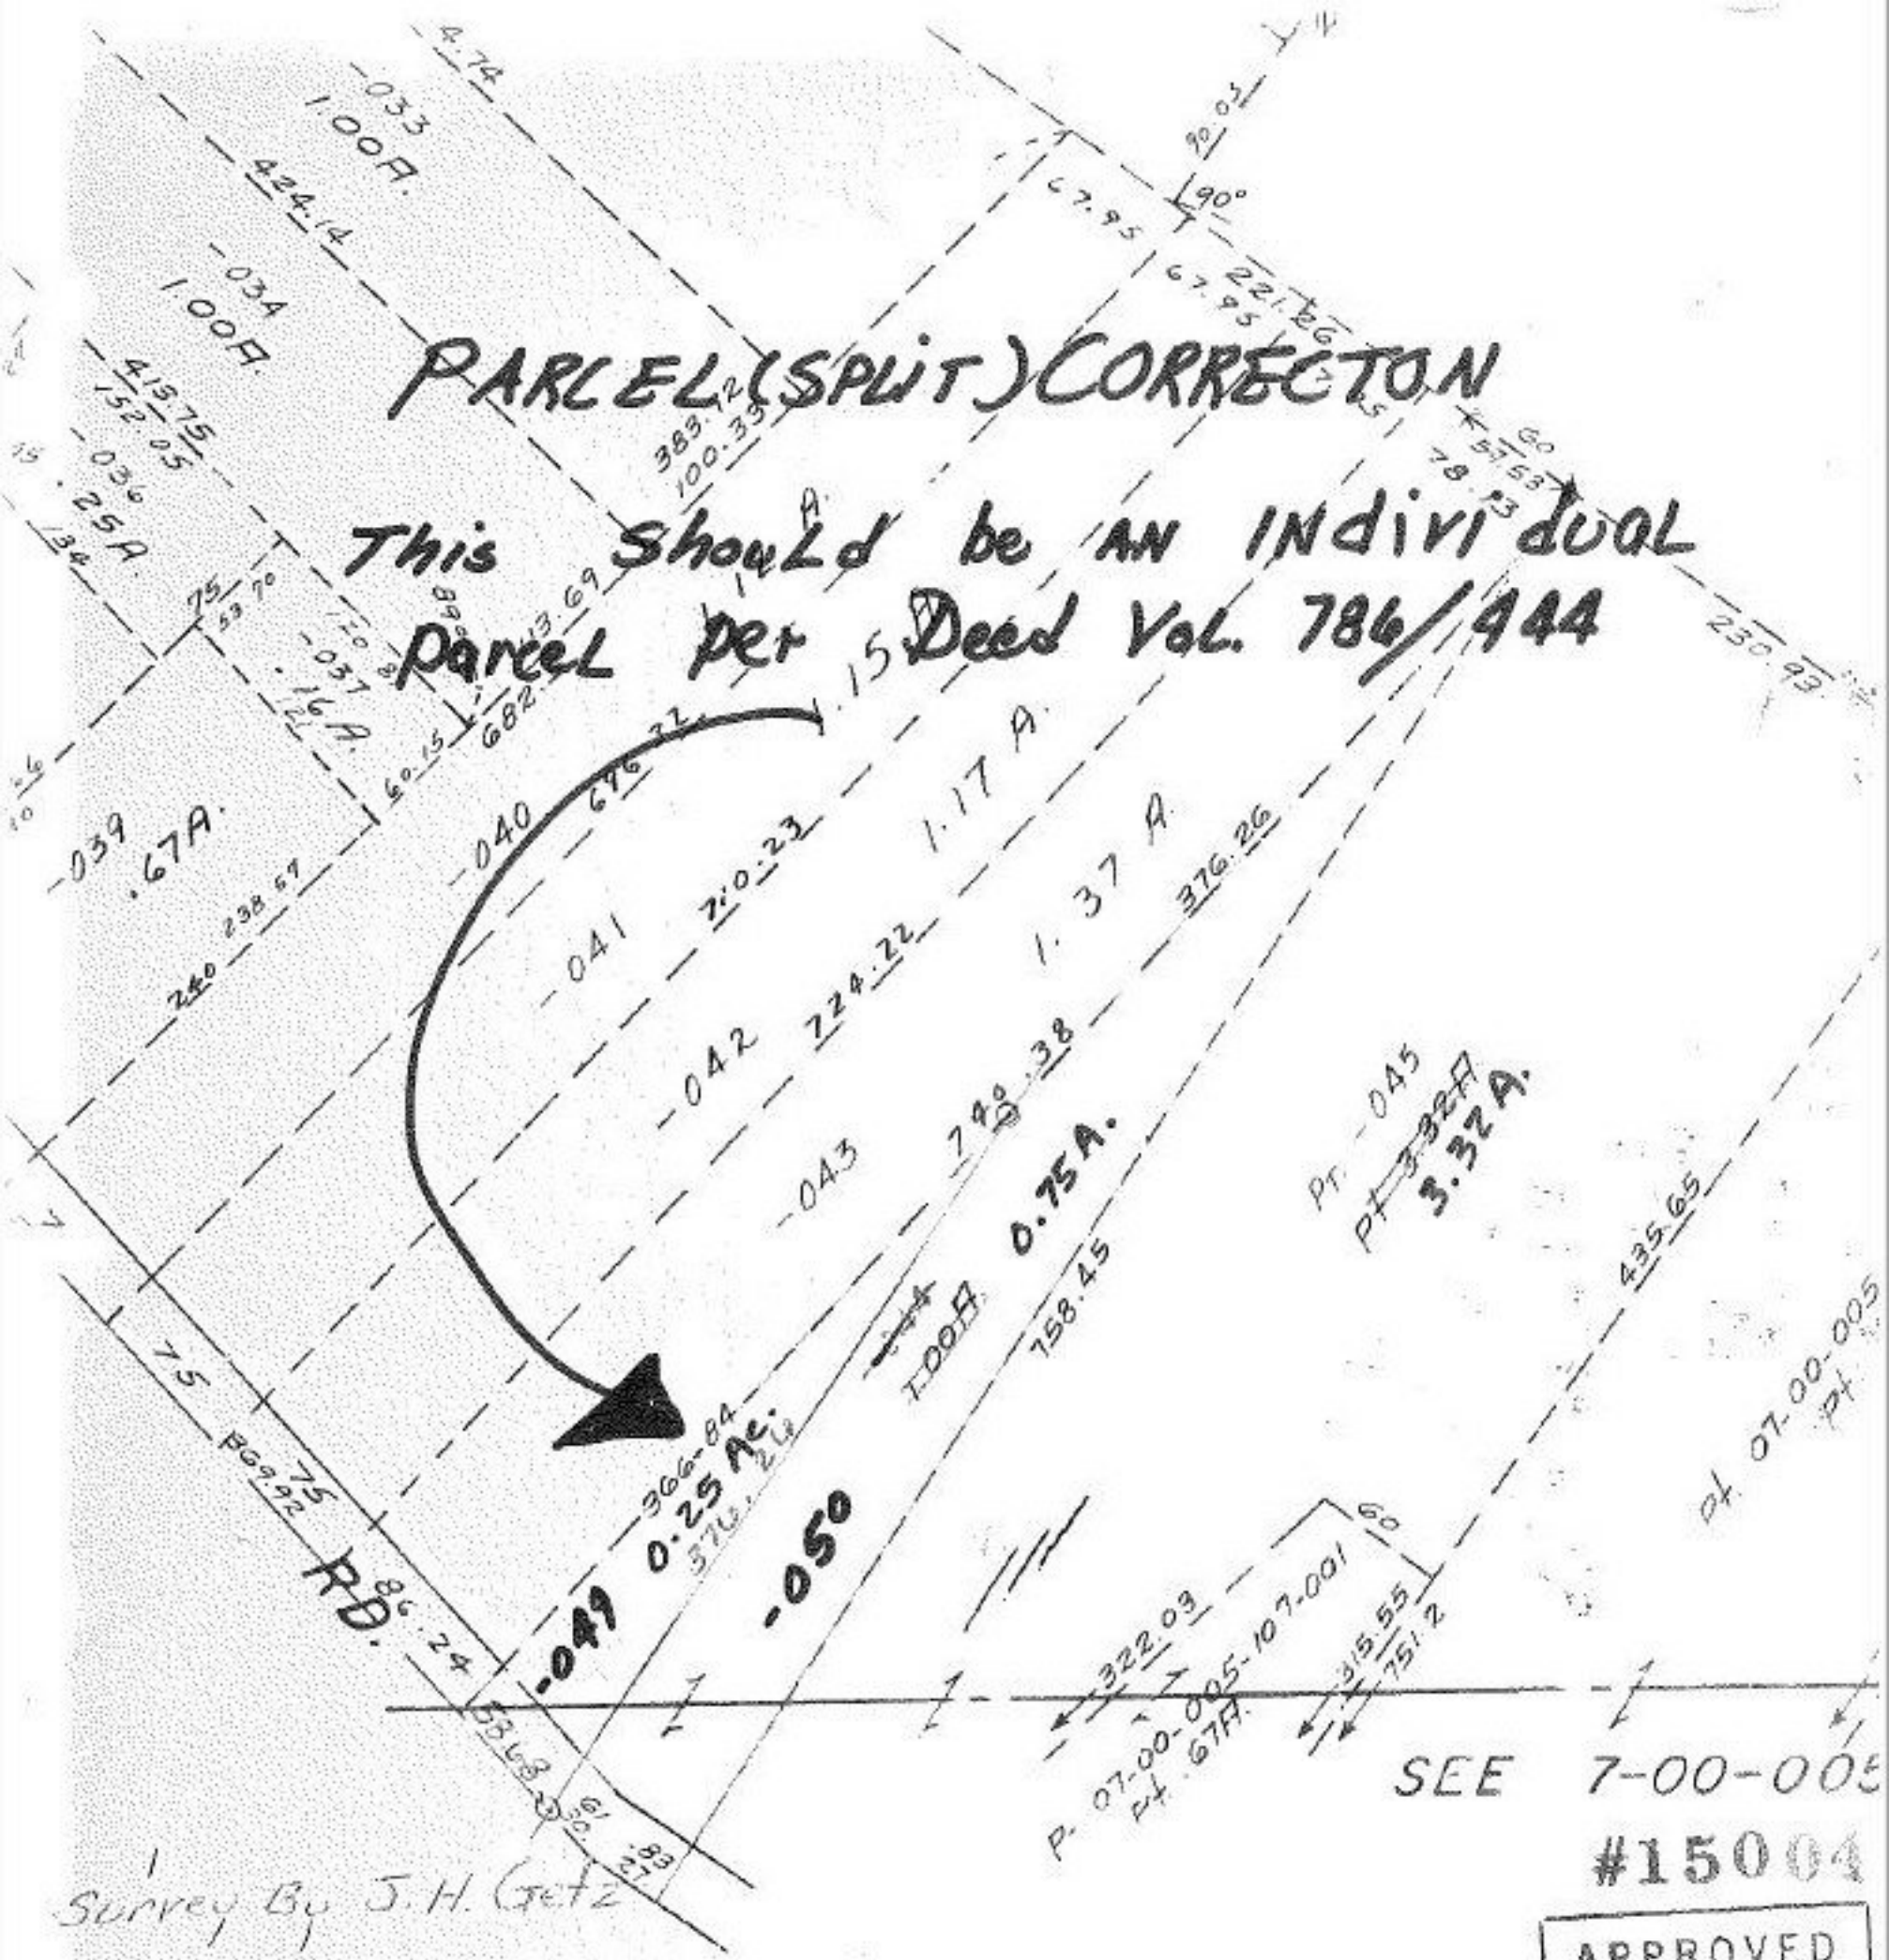
PARCEL (SPLIT) CORRECTON
This should be an individual parcel per Deed Vol. 786/444
-033 1.00A.
-034 1.00A.
-036 .25A.
-037 .16A.
-039 .67A.
-040
-041
-042
-043
-044 1.00A.
-045 3.32A.
-049 0.25 Ac.
-050
1.17 A.
1.37 A.
0.75A.
RD.
SEE 7-00-005
#15004
Survey By J.H. Getz
OCT/26/60
FVILLE TWP.
= 100'
6-3-83
APPROVED
LORAIN CO.
MAP DEPT.
DATE 3-14-83
PAGE
BY
VOID AFTER