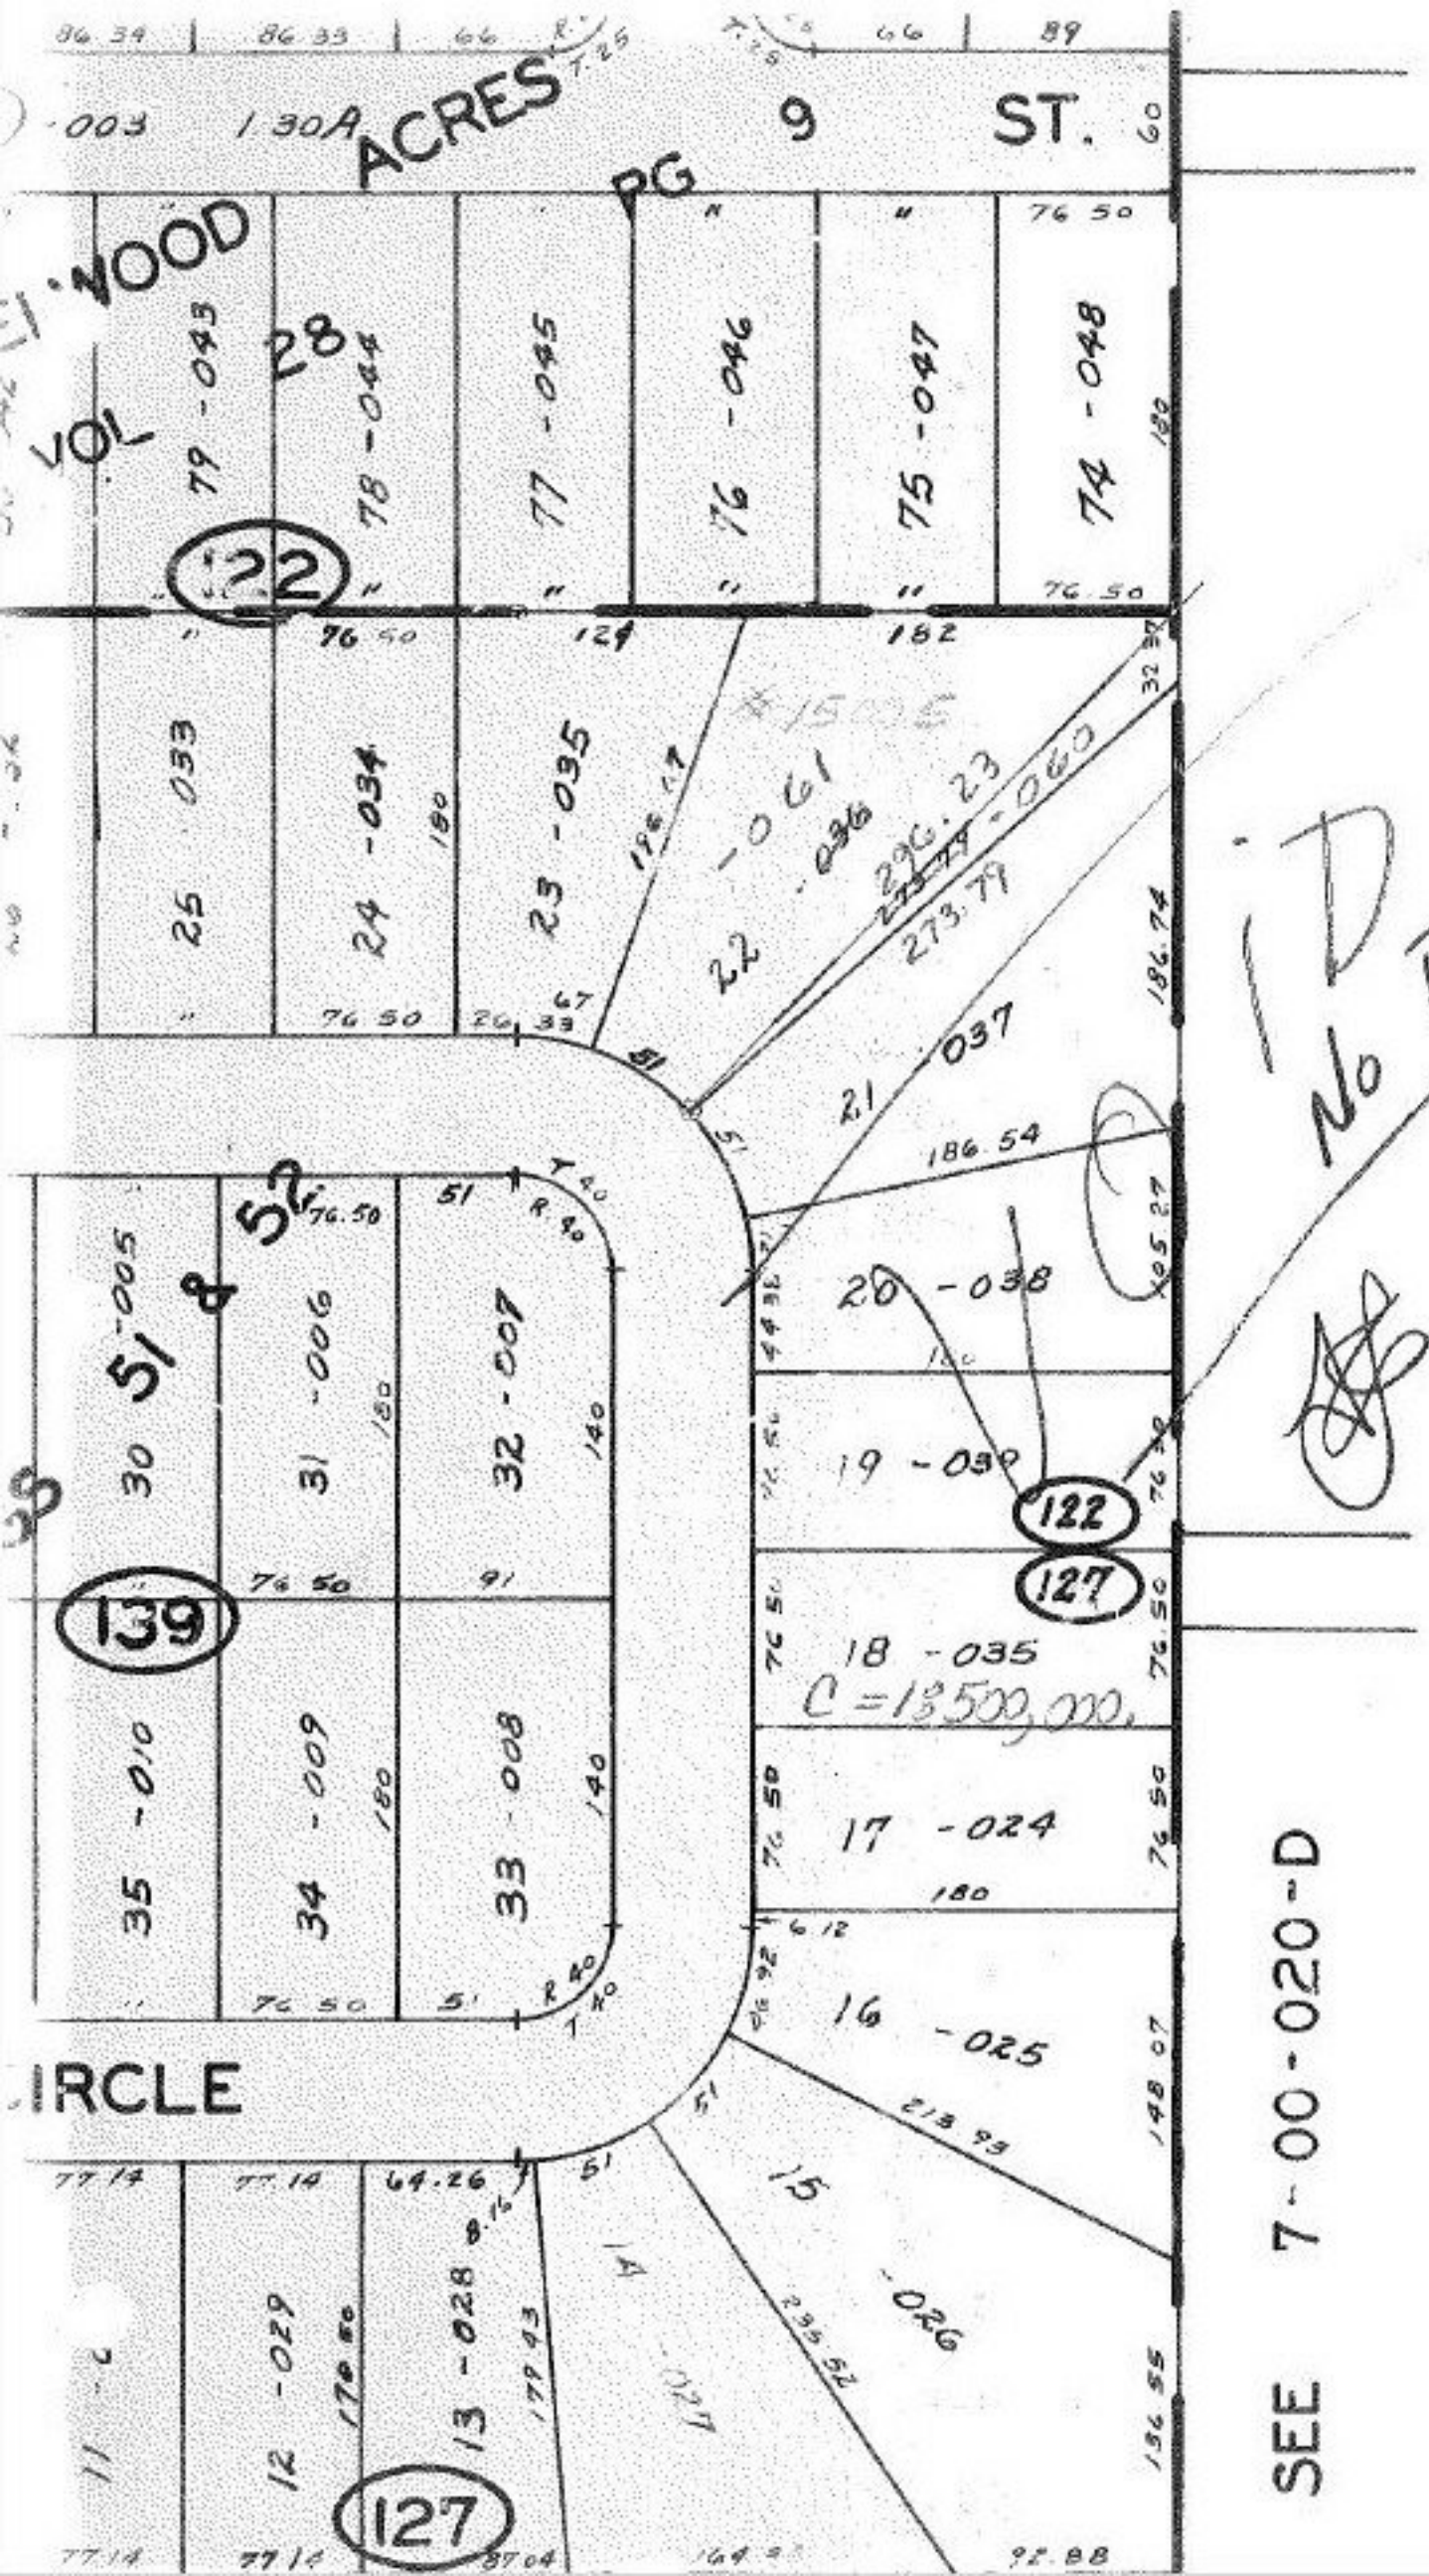

ID
No Deed.
5-10-83

C = 13500,000.

#15005

APPROVED
LORAIN CO.
MAP DEPT.

DATE 3-10-83
PAGE 7-00-020-C
BY C. Francis
VOID AFTER