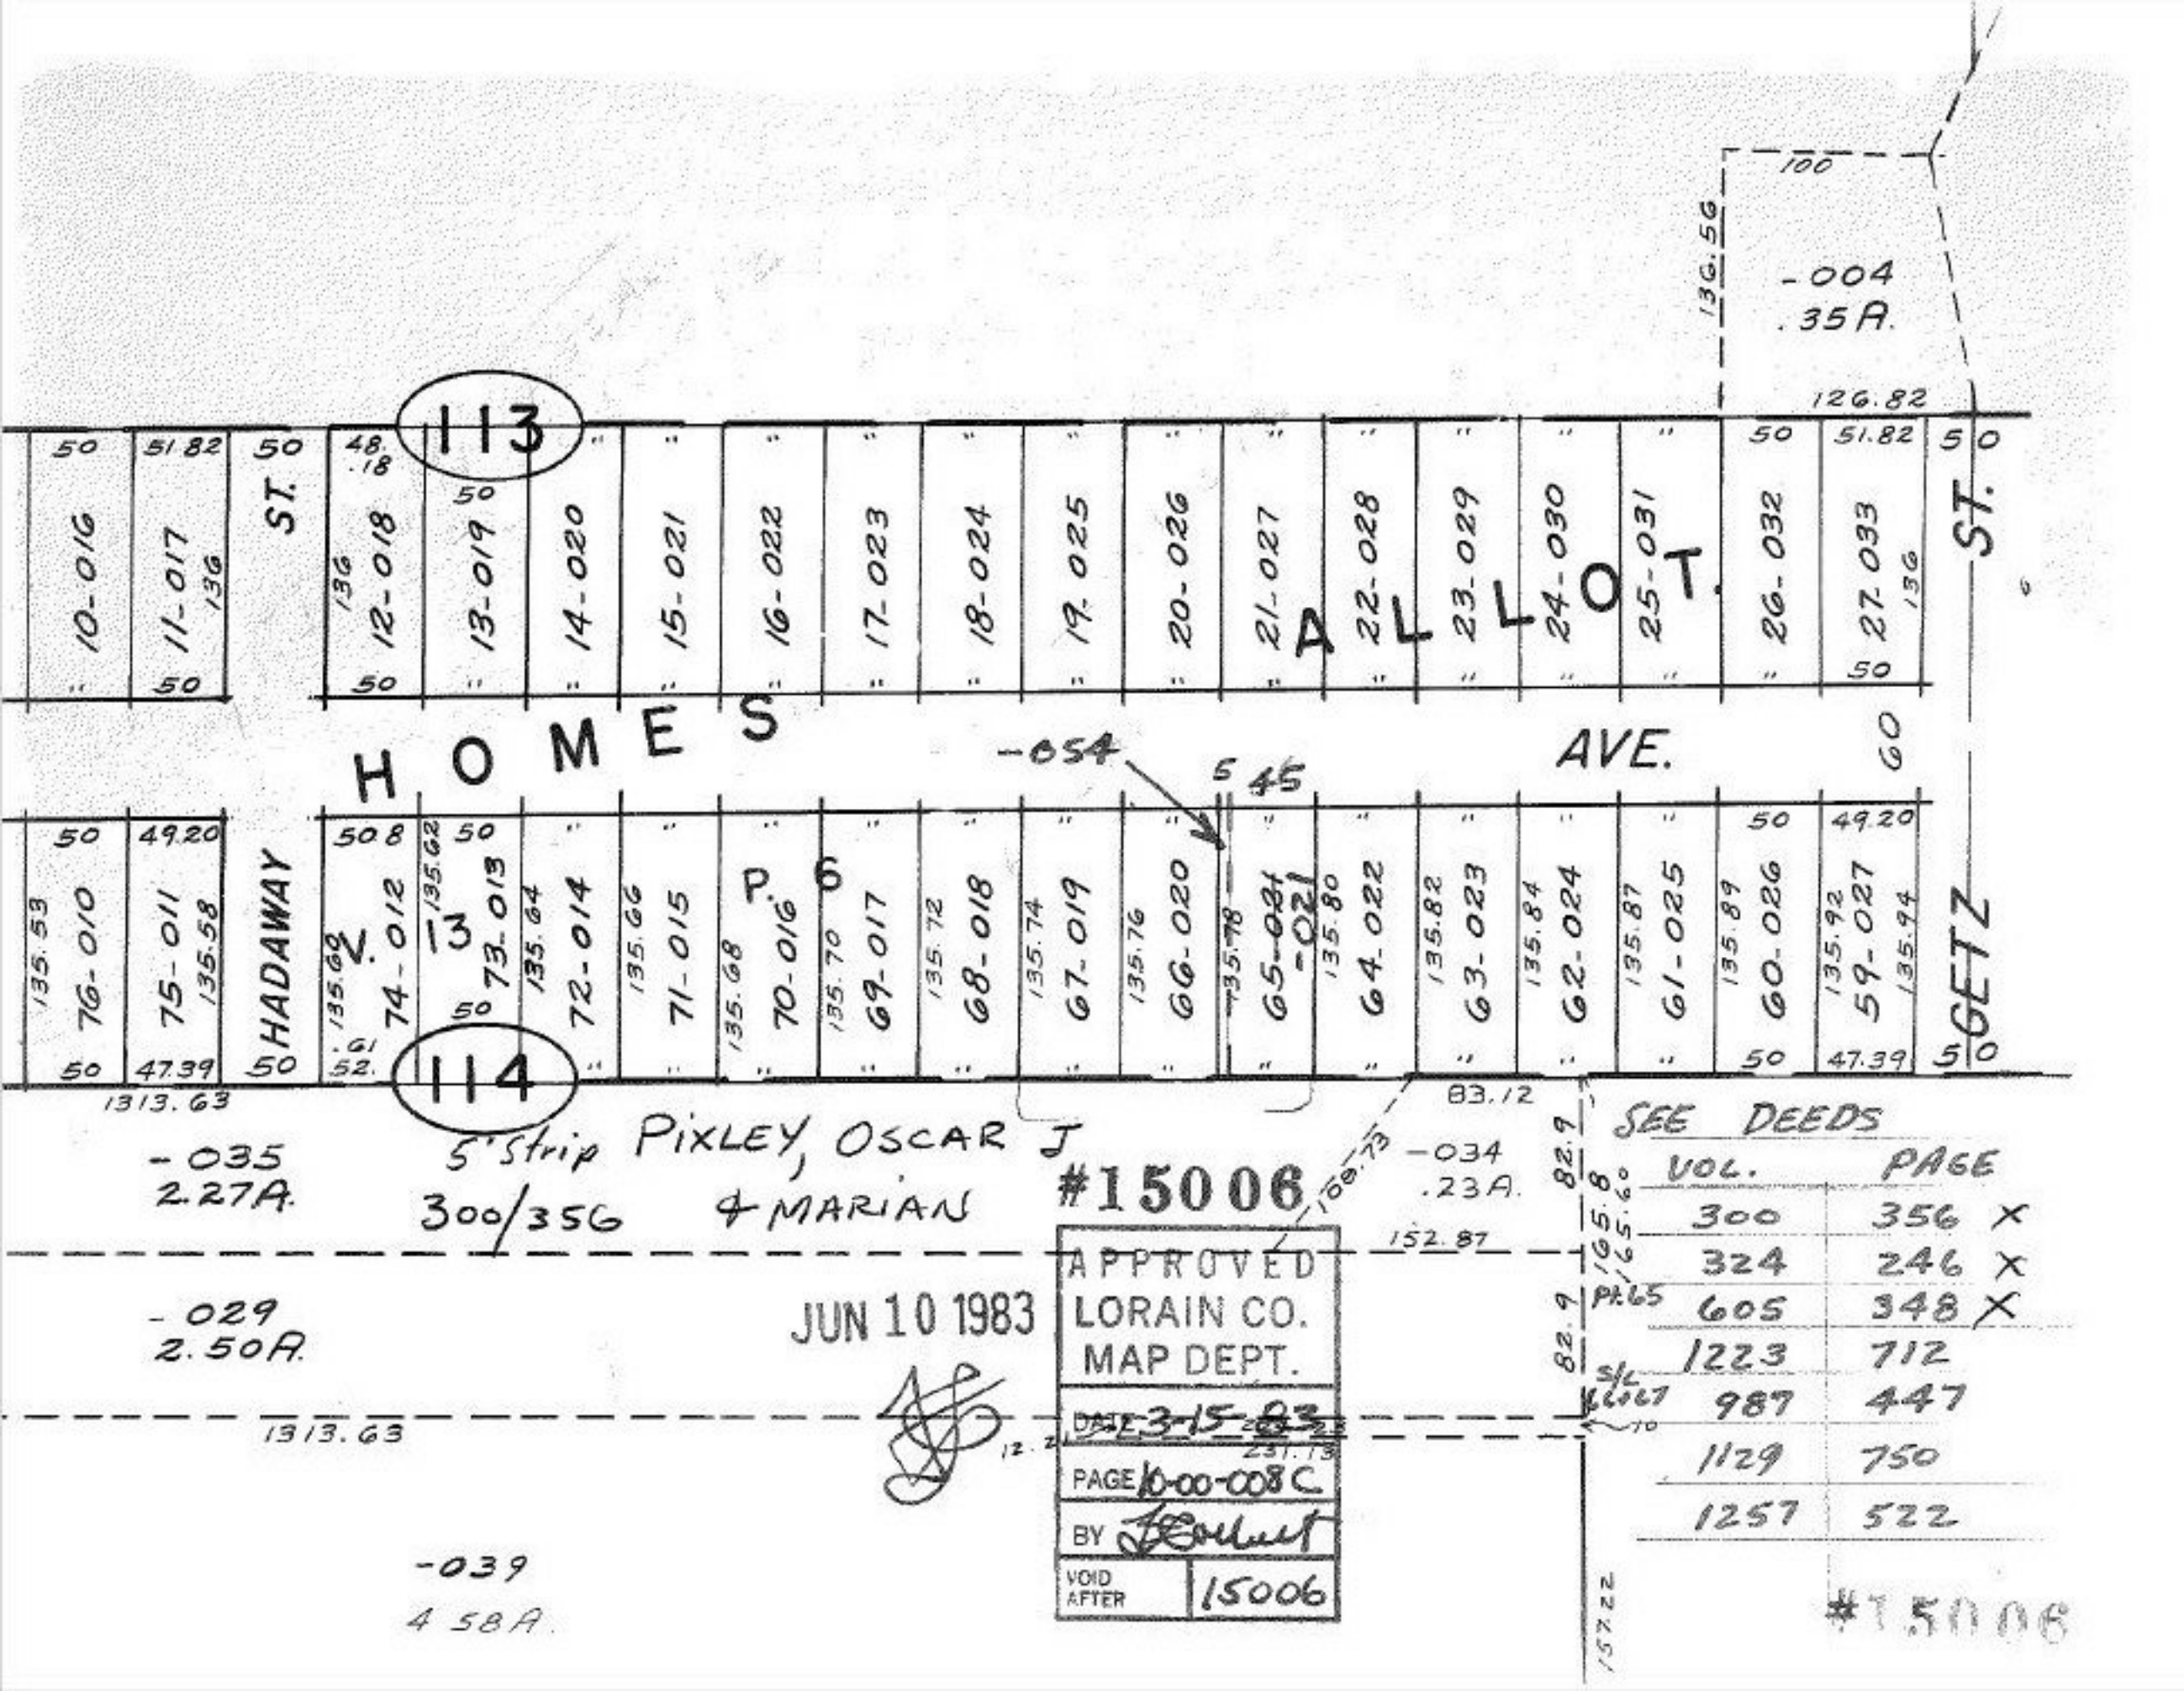

SEE DEEDS

VOL.	PAGE
300	356 X
324	246 X
605	348 X
1223	712
987	447
1129	750
1257	522

#15006

JUN 10 1983

APPROVED
LORAIN CO.
MAP DEPT.
DATE 3-15-83
PAGE 10-00-008C
BY [signature]
VOID AFTER 15006

#15006