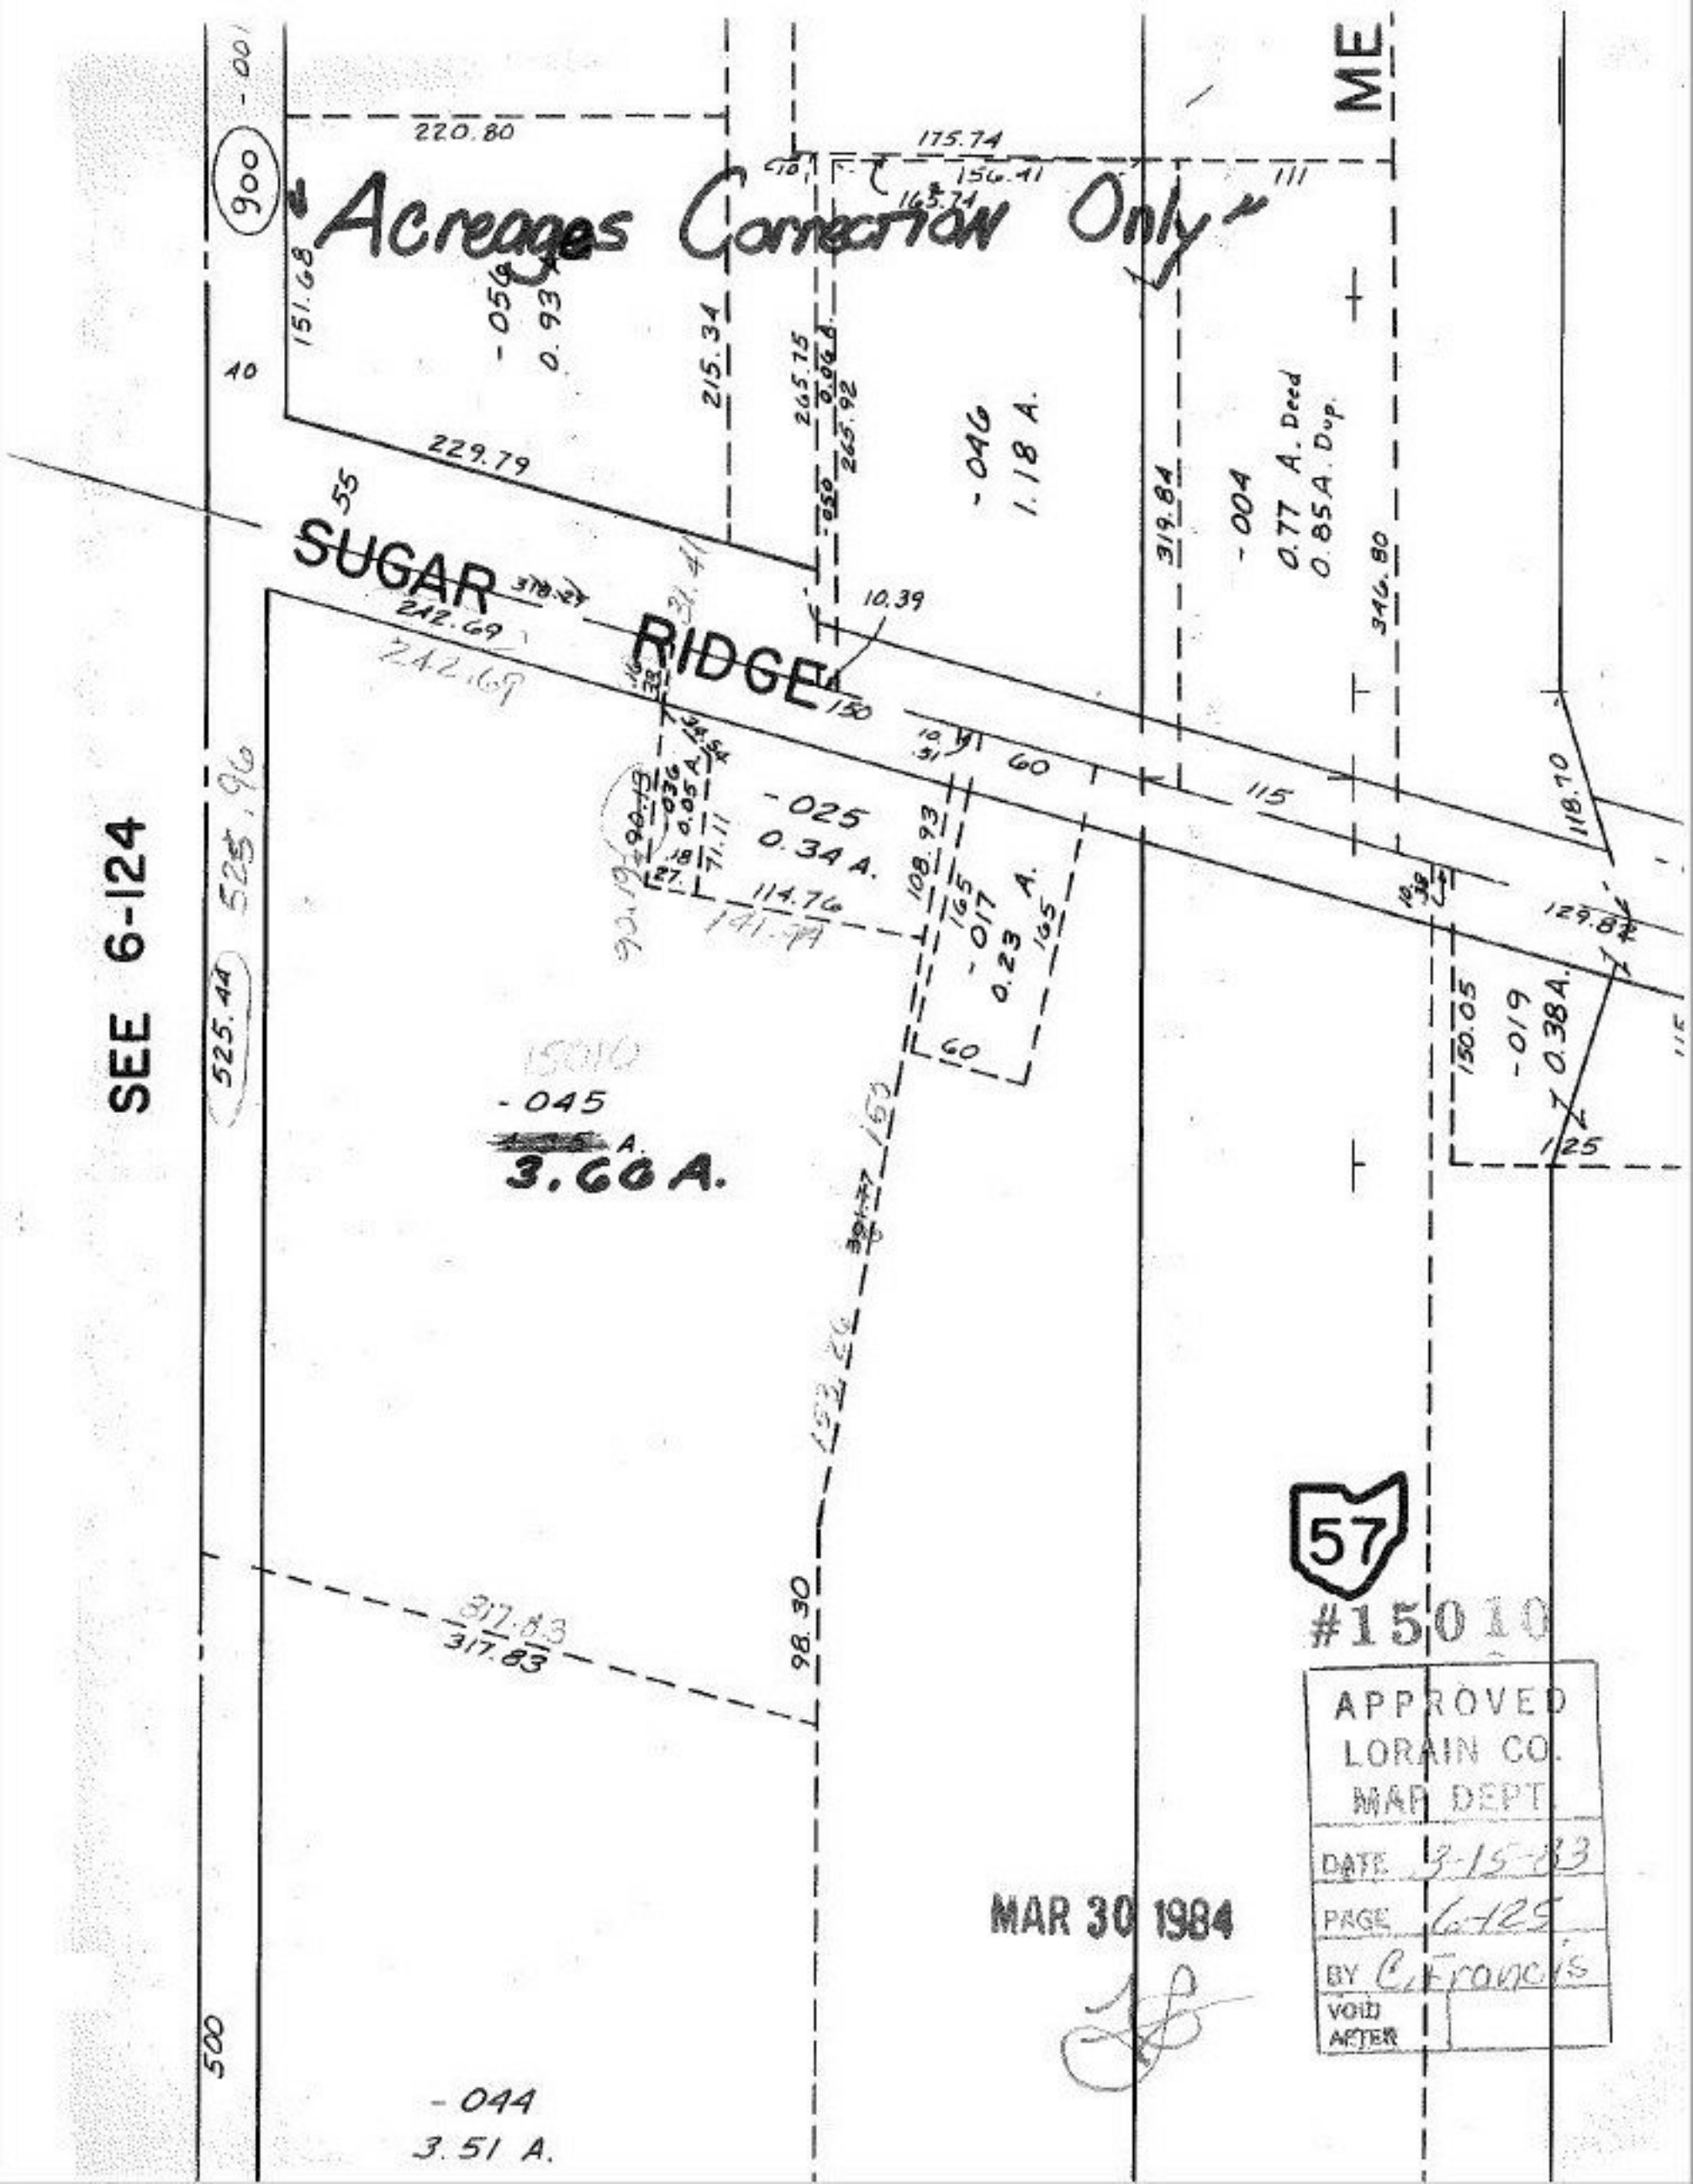

"Acreages Correction Only"
SEE 6-124
SUGAR RIDGE
ME
57
900
525.96
525.44
220.80
175.74
156.41
165.74
151.68
-056
0.93
215.34
265.75
265.92
229.79
-046
1.18 A.
319.84
-004
0.77 A. Deed
0.85 A. Dup.
346.80
242.69
10.39
-025
0.34 A.
114.76
108.93
-017
0.23 A.
118.70
129.82
150.05
-019
0.38 A.
-045
3.60 A.
98.30
317.83
-044
3.51 A.
500
#15010
APPROVED
LORAIN CO.
MAP DEPT.
DATE 3-15-83
PAGE 6-125
BY C. Francis
VOID AFTER
MAR 30 1984