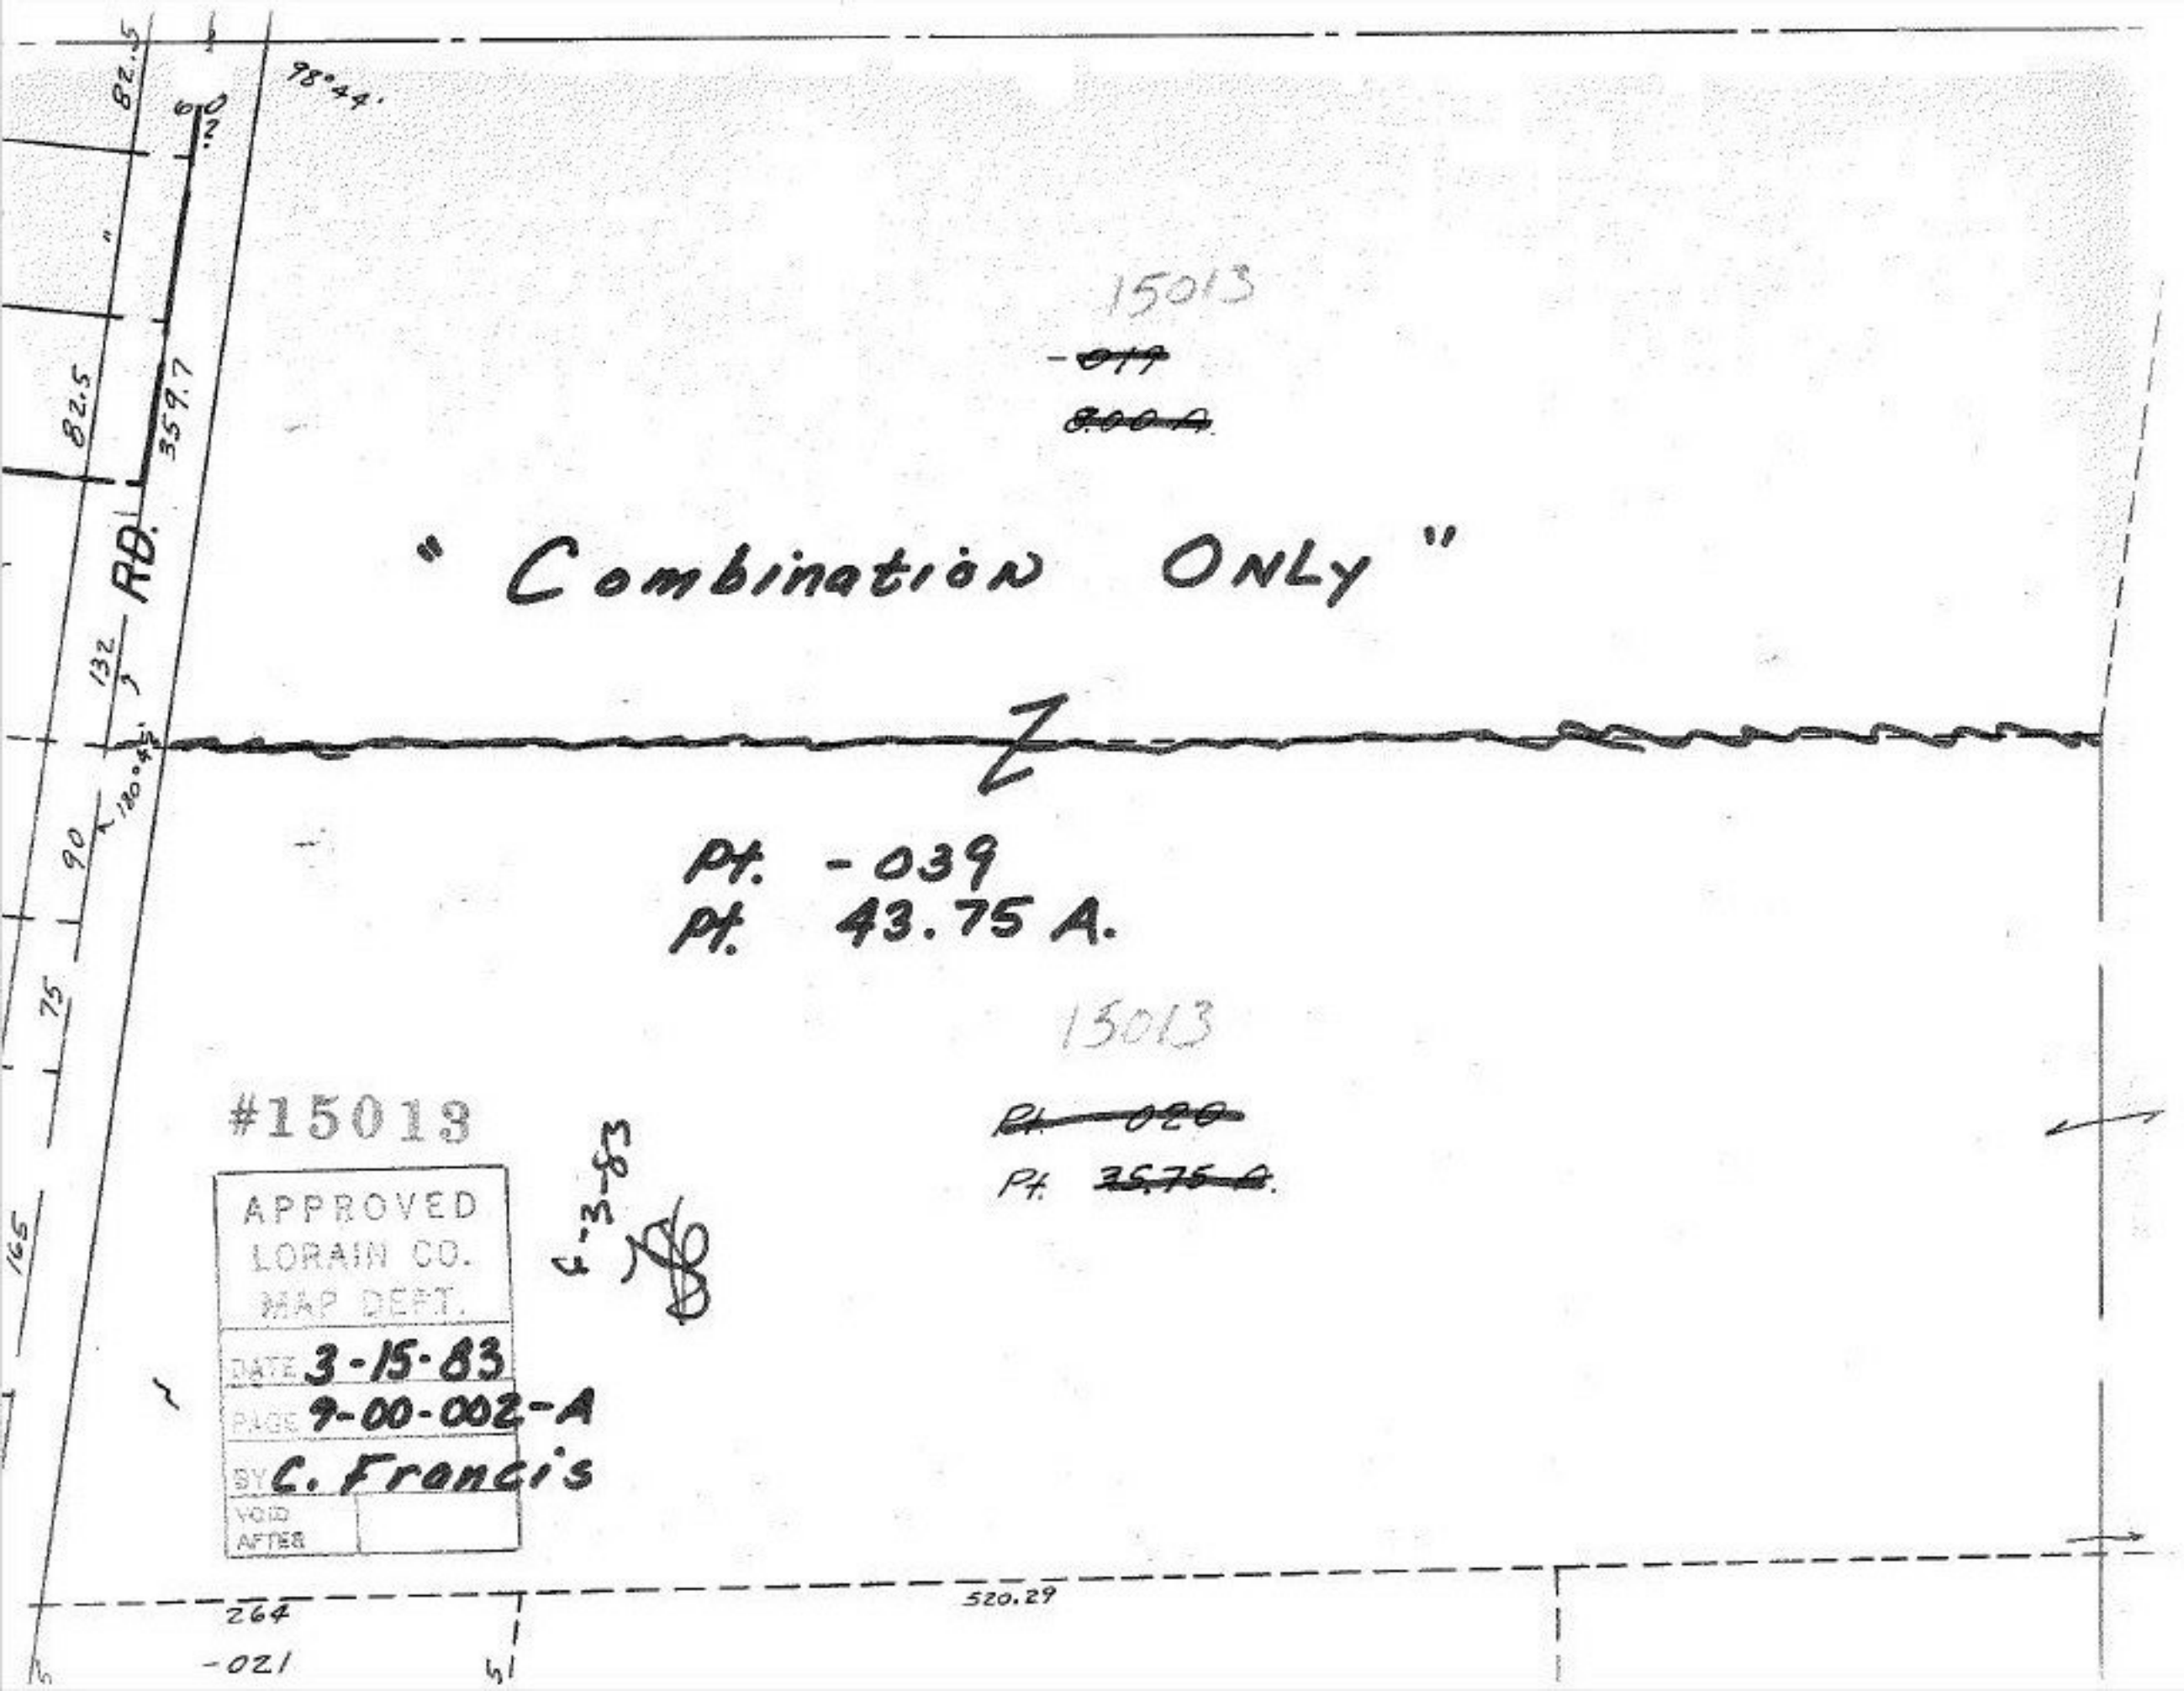

98°44'
82.5
82.5
359.7
RD.
132
180°45'
90
75
165
15013
~~-019~~
~~8.00 A.~~
" Combination ONLY "
Z
Pt. -039
Pt. 43.75 A.
15013
~~Pt. -020~~
Pt. ~~35.75 A.~~
#15013
APPROVED
LORAIN CO.
MAP DEPT.
DATE 3-15-83
PAGE 9-00-002-A
BY C. Francis
VOID AFTER
4-3-83
520.29
264
-021