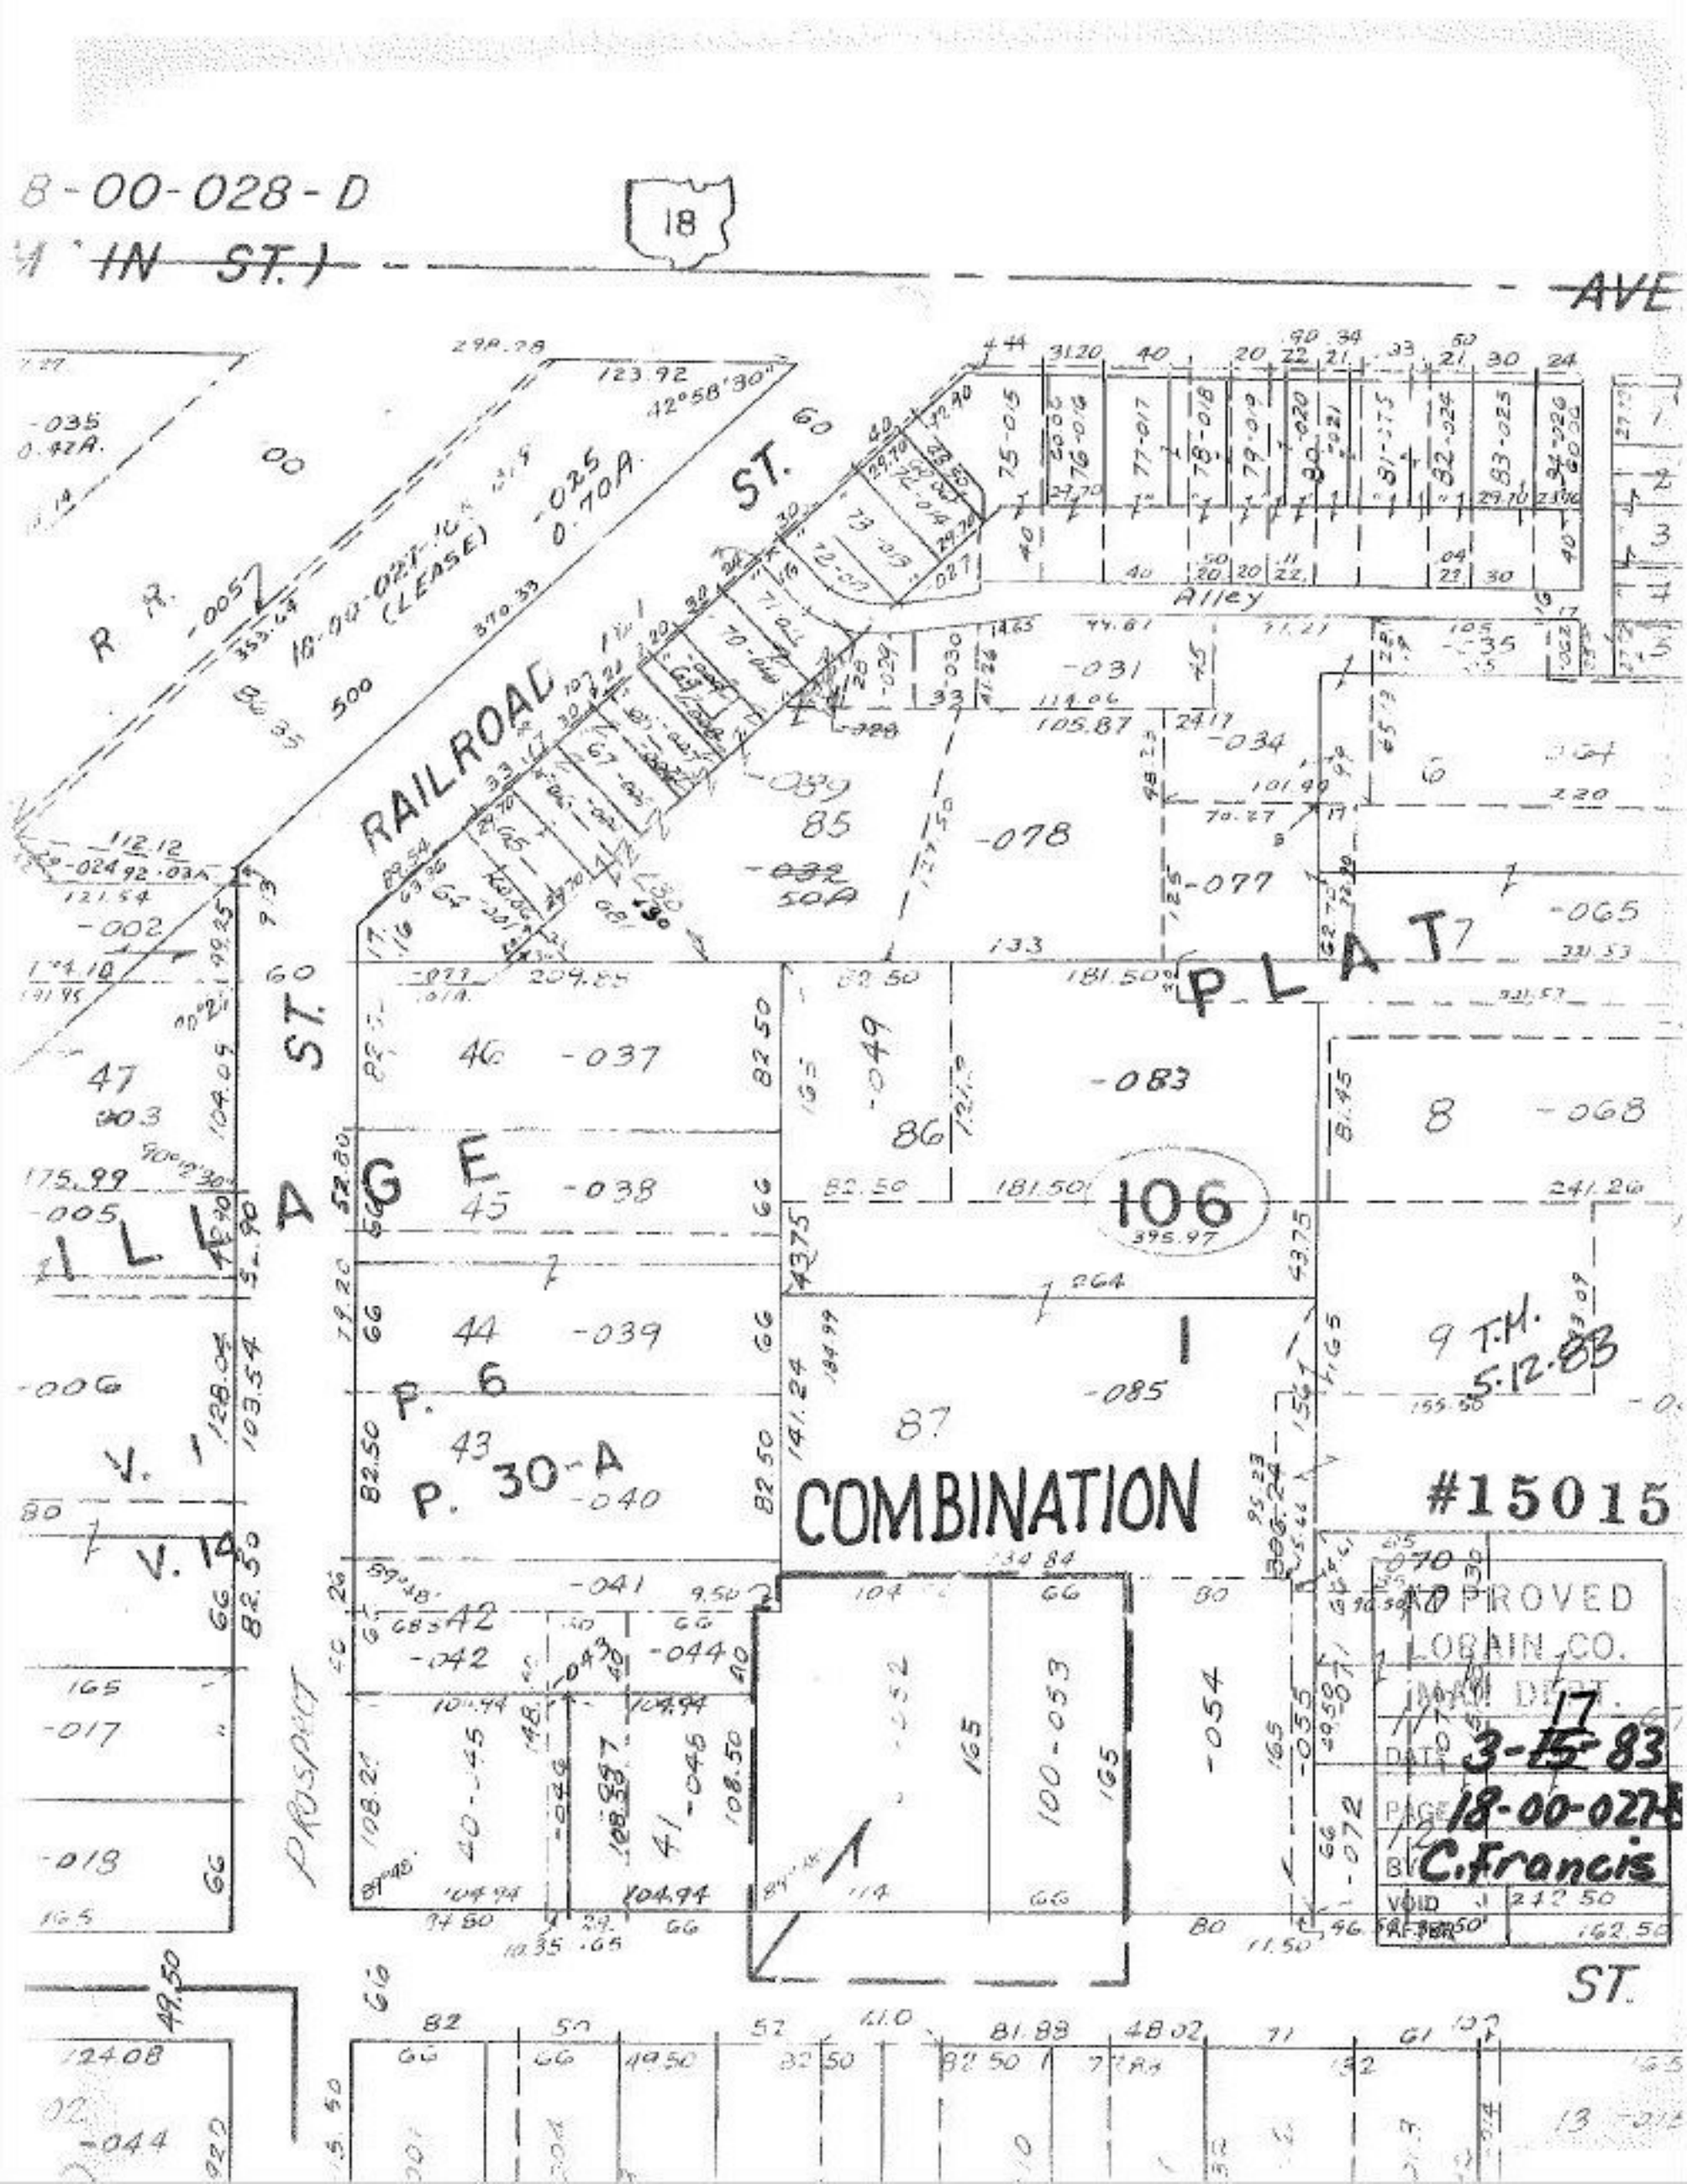

8-00-028-D
18
IN ST.)
AVE
RAILROAD
ST.
Alley
PLAT
ST.
ILLAGE
P. 6
P. 30-A
V. 1
V. 14
PROSPECT
COMBINATION
106
#15015
APPROVED
LORAIN CO.
MAP DEPT.
DATE 3-17-83
PAGE 18-00-027-
BY C. Francis
VOID