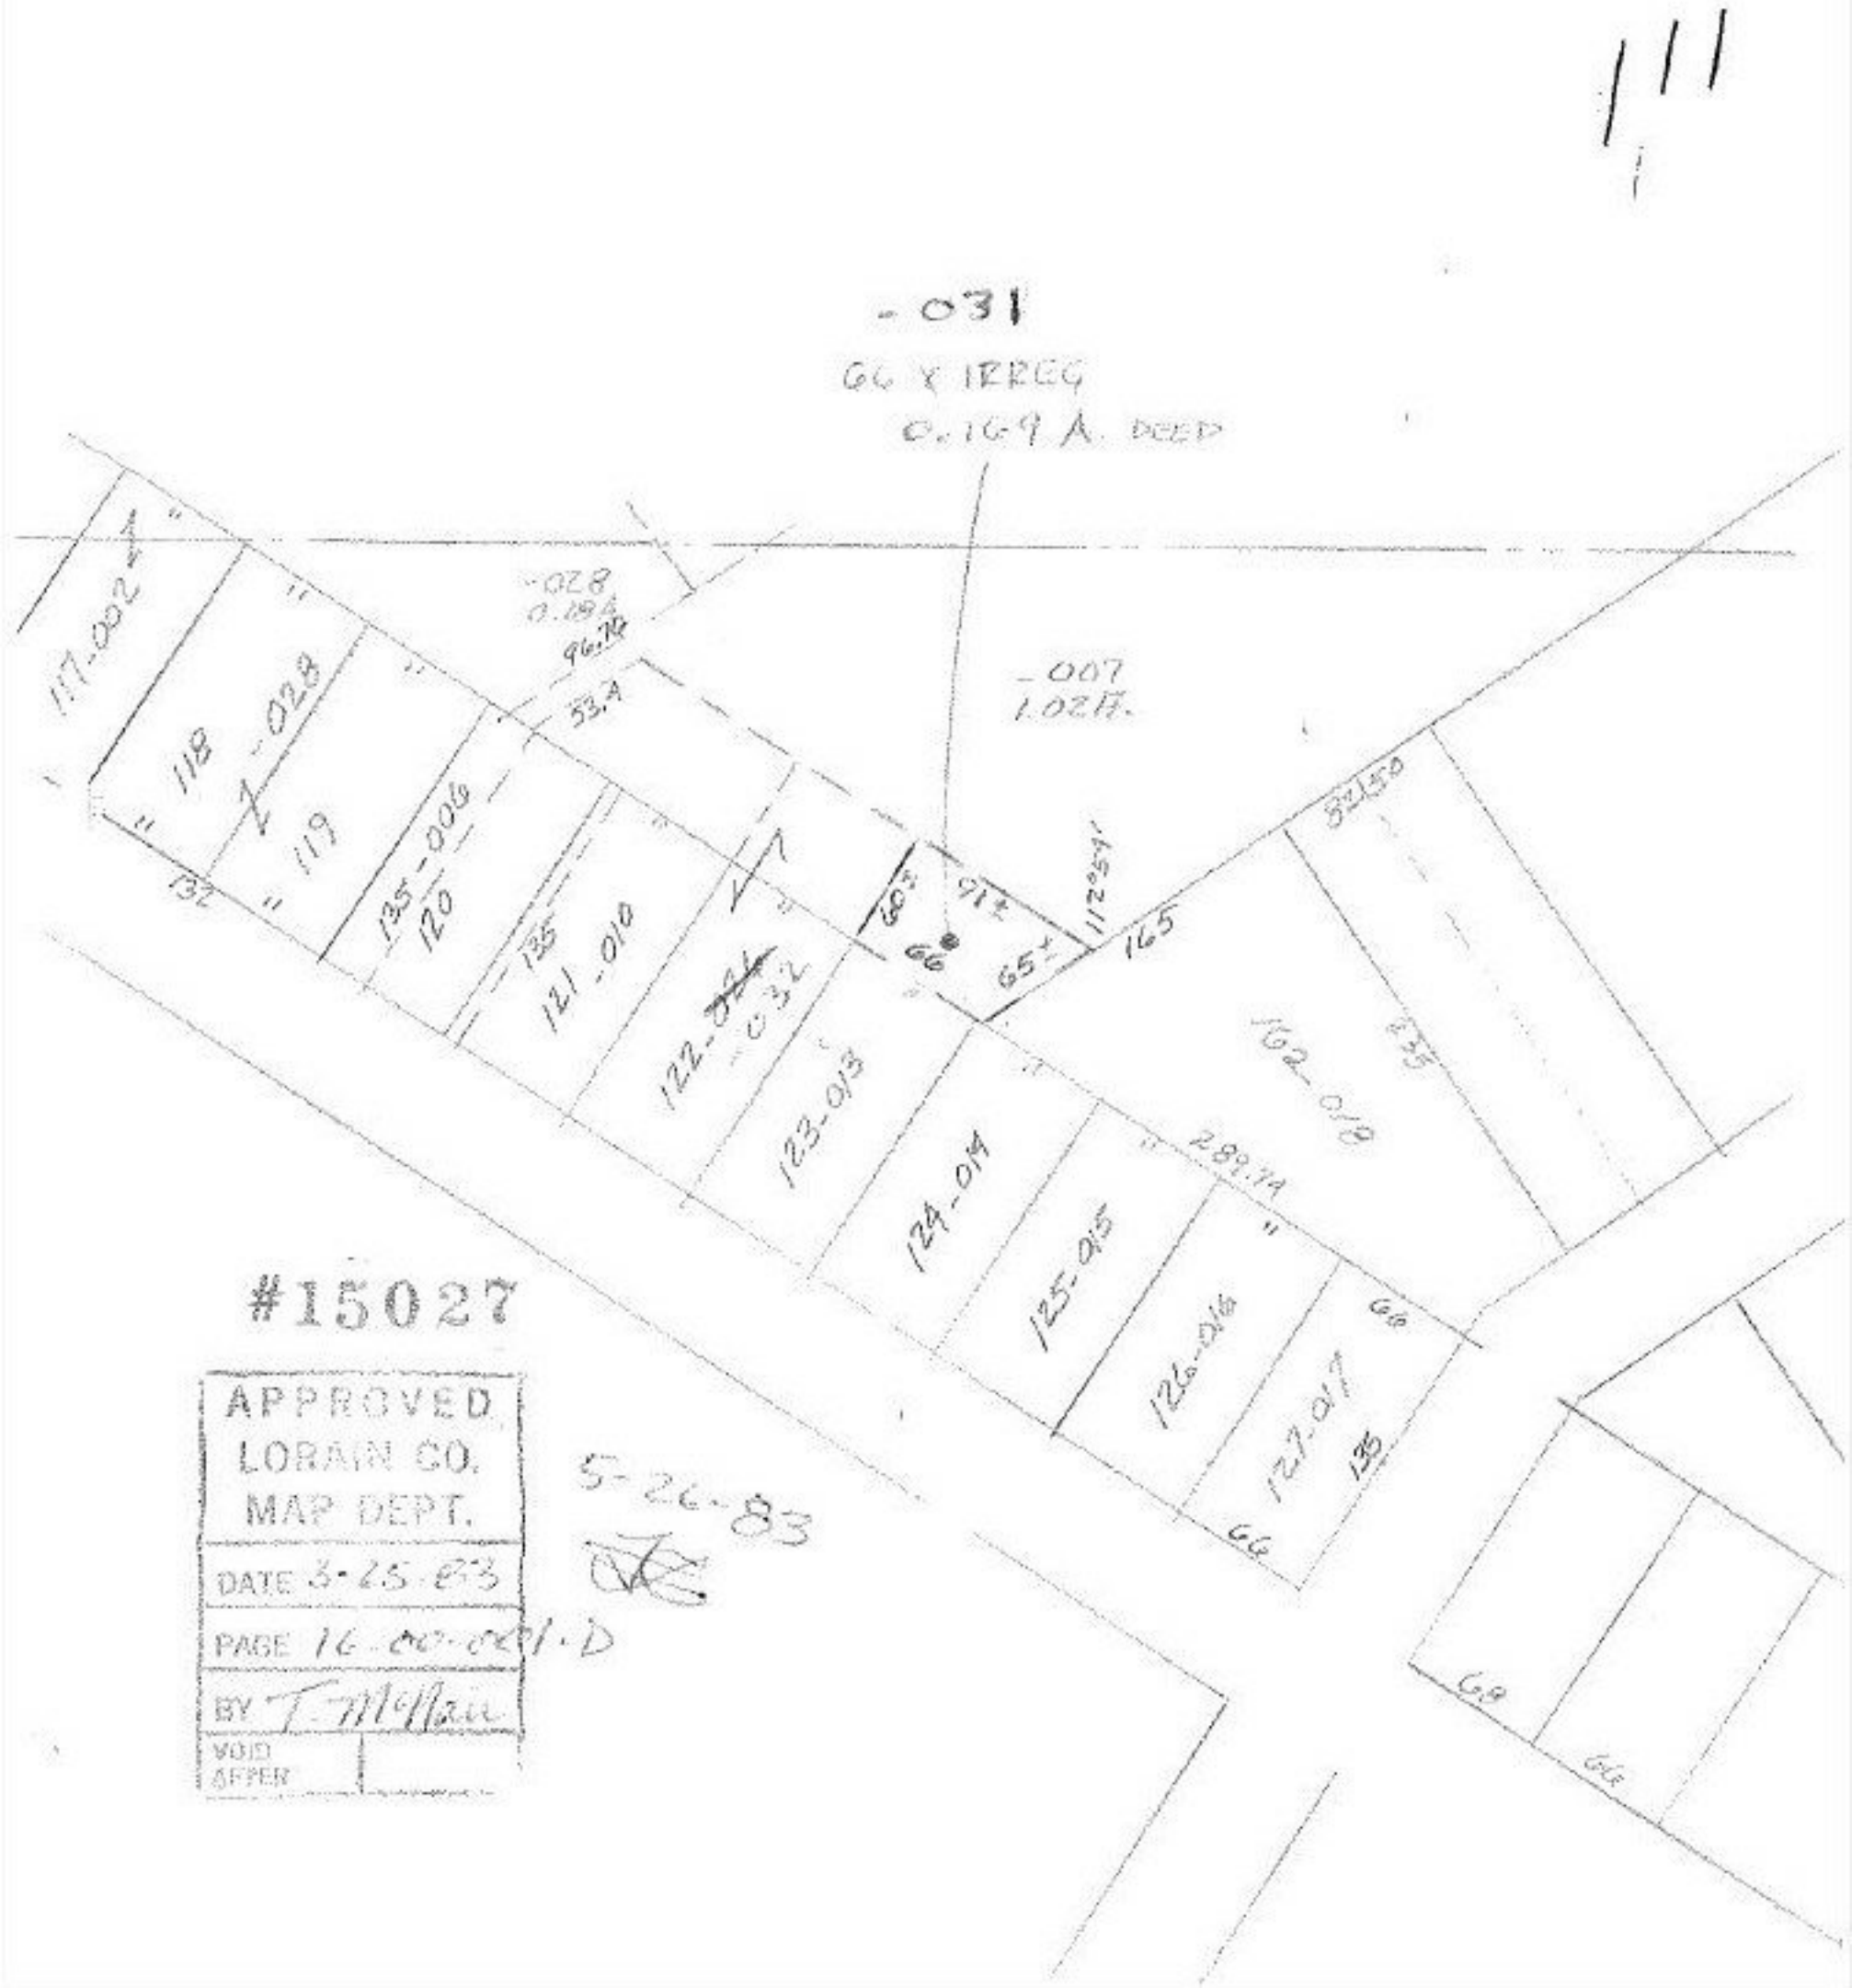

#15027

APPROVED
LORAIN CO.
MAP DEPT.
DATE 3-25-83
PAGE 16-00-001-D
BY T. McNair
VOID AFTER

5-26-83