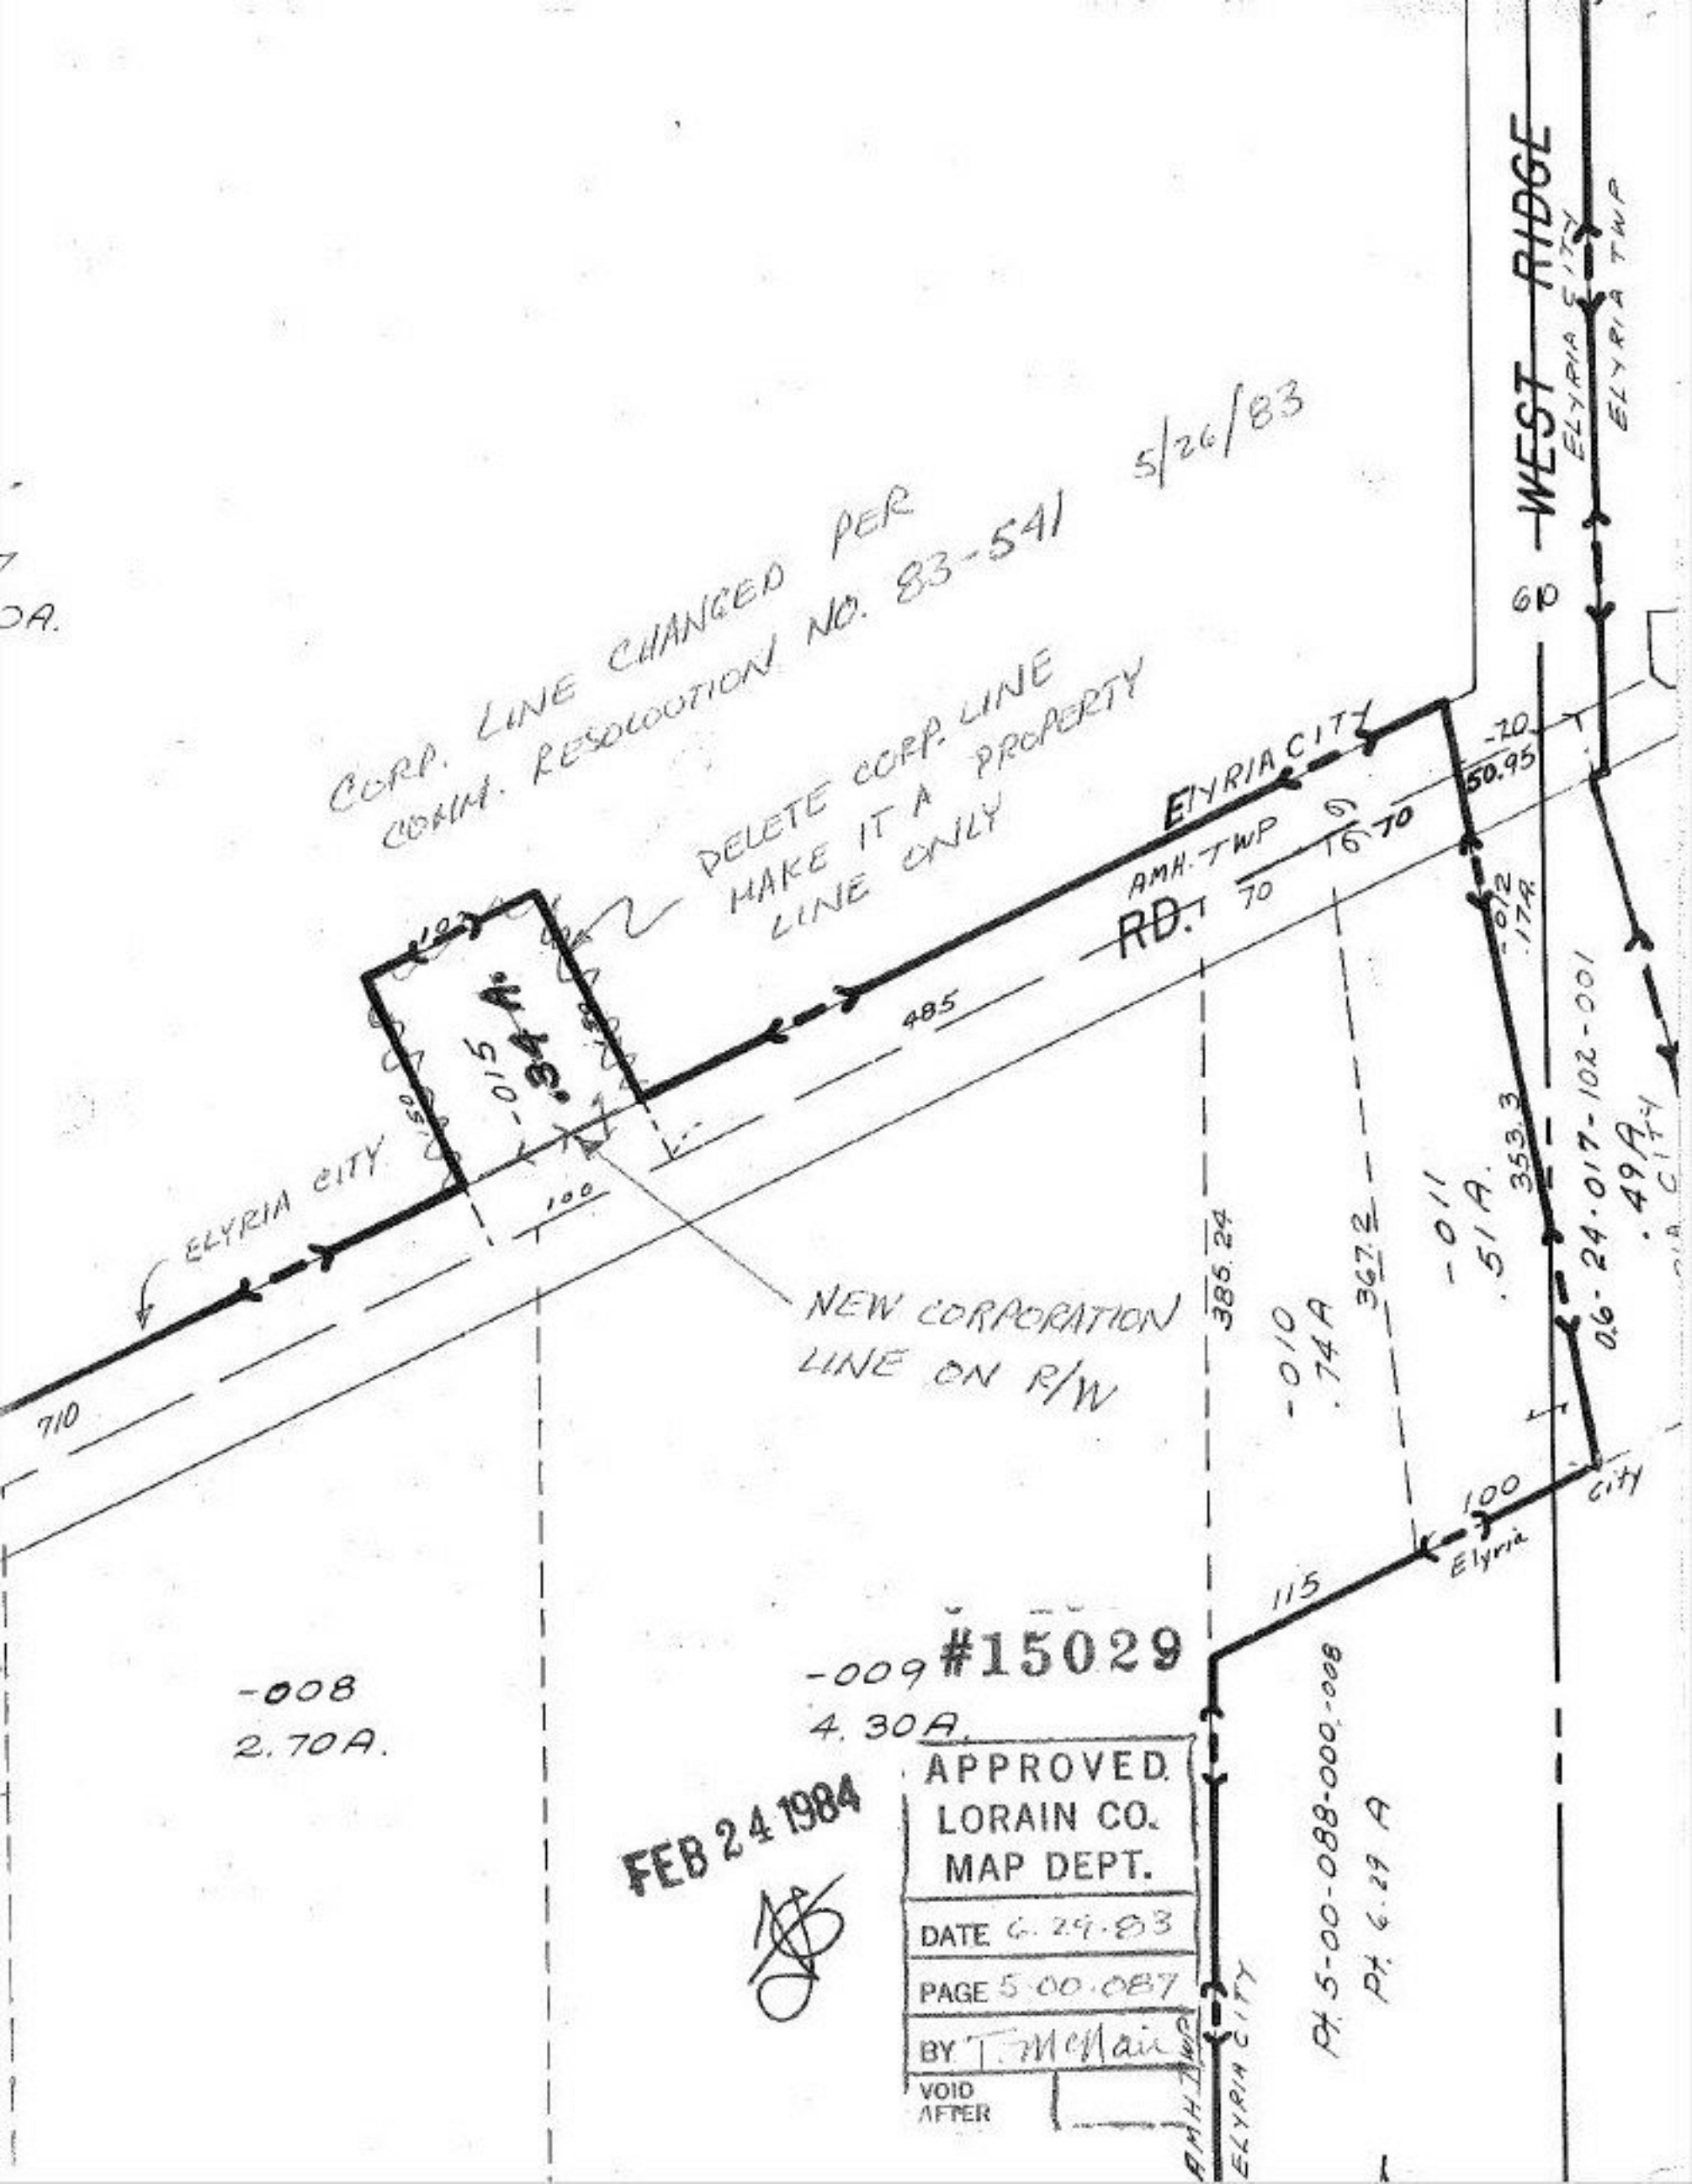

#15029

FEB 24 1984

APPROVED
LORAIN CO.
MAP DEPT.
DATE 6.29.83
PAGE 5.00.087
BY T. McNair
VOID
AFTER