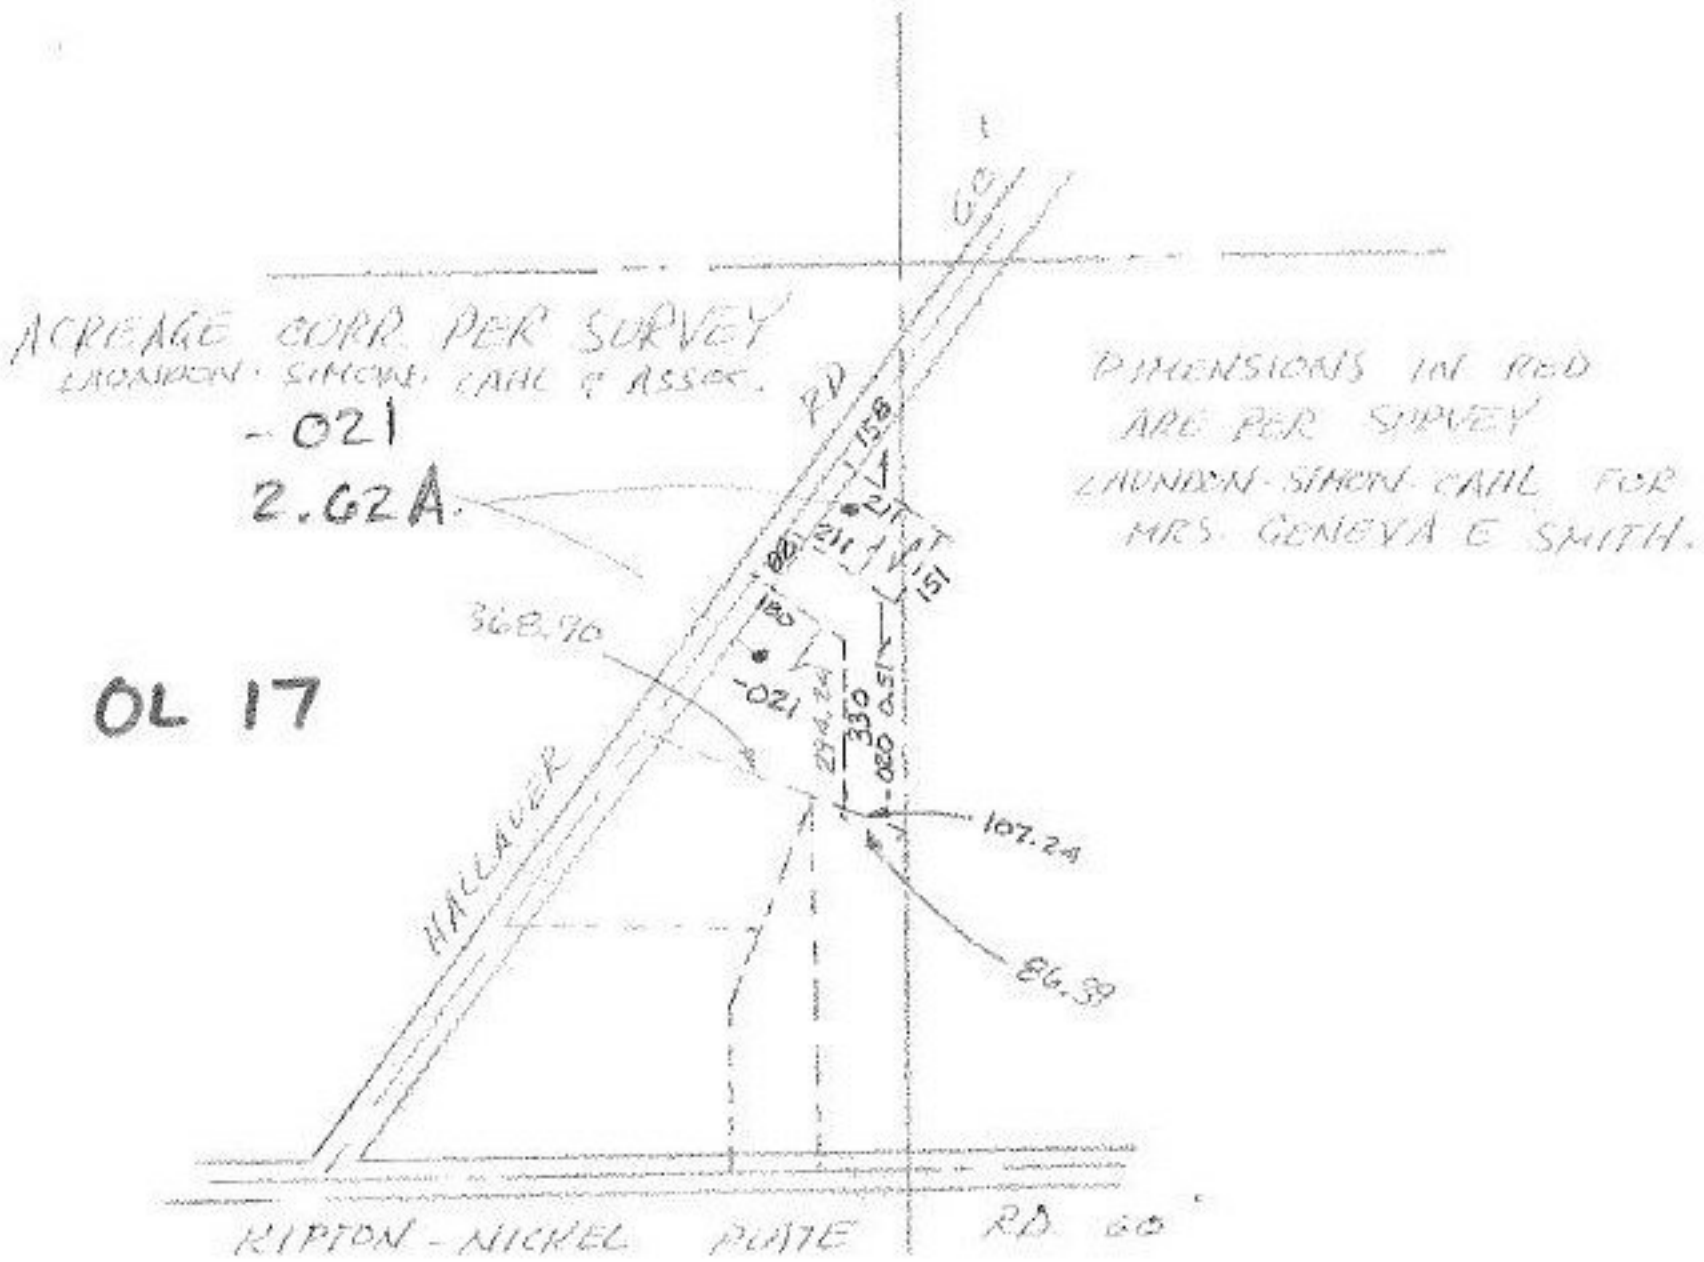

#15031

APPROVED
LORAIN CO.
MAP DEPT.
DATE 5-25-83
PAGE 14-C
BY T. Mallace
VOID
AFTER

5-23-83