


SEE 6-106

781.65

650.05  
649.7

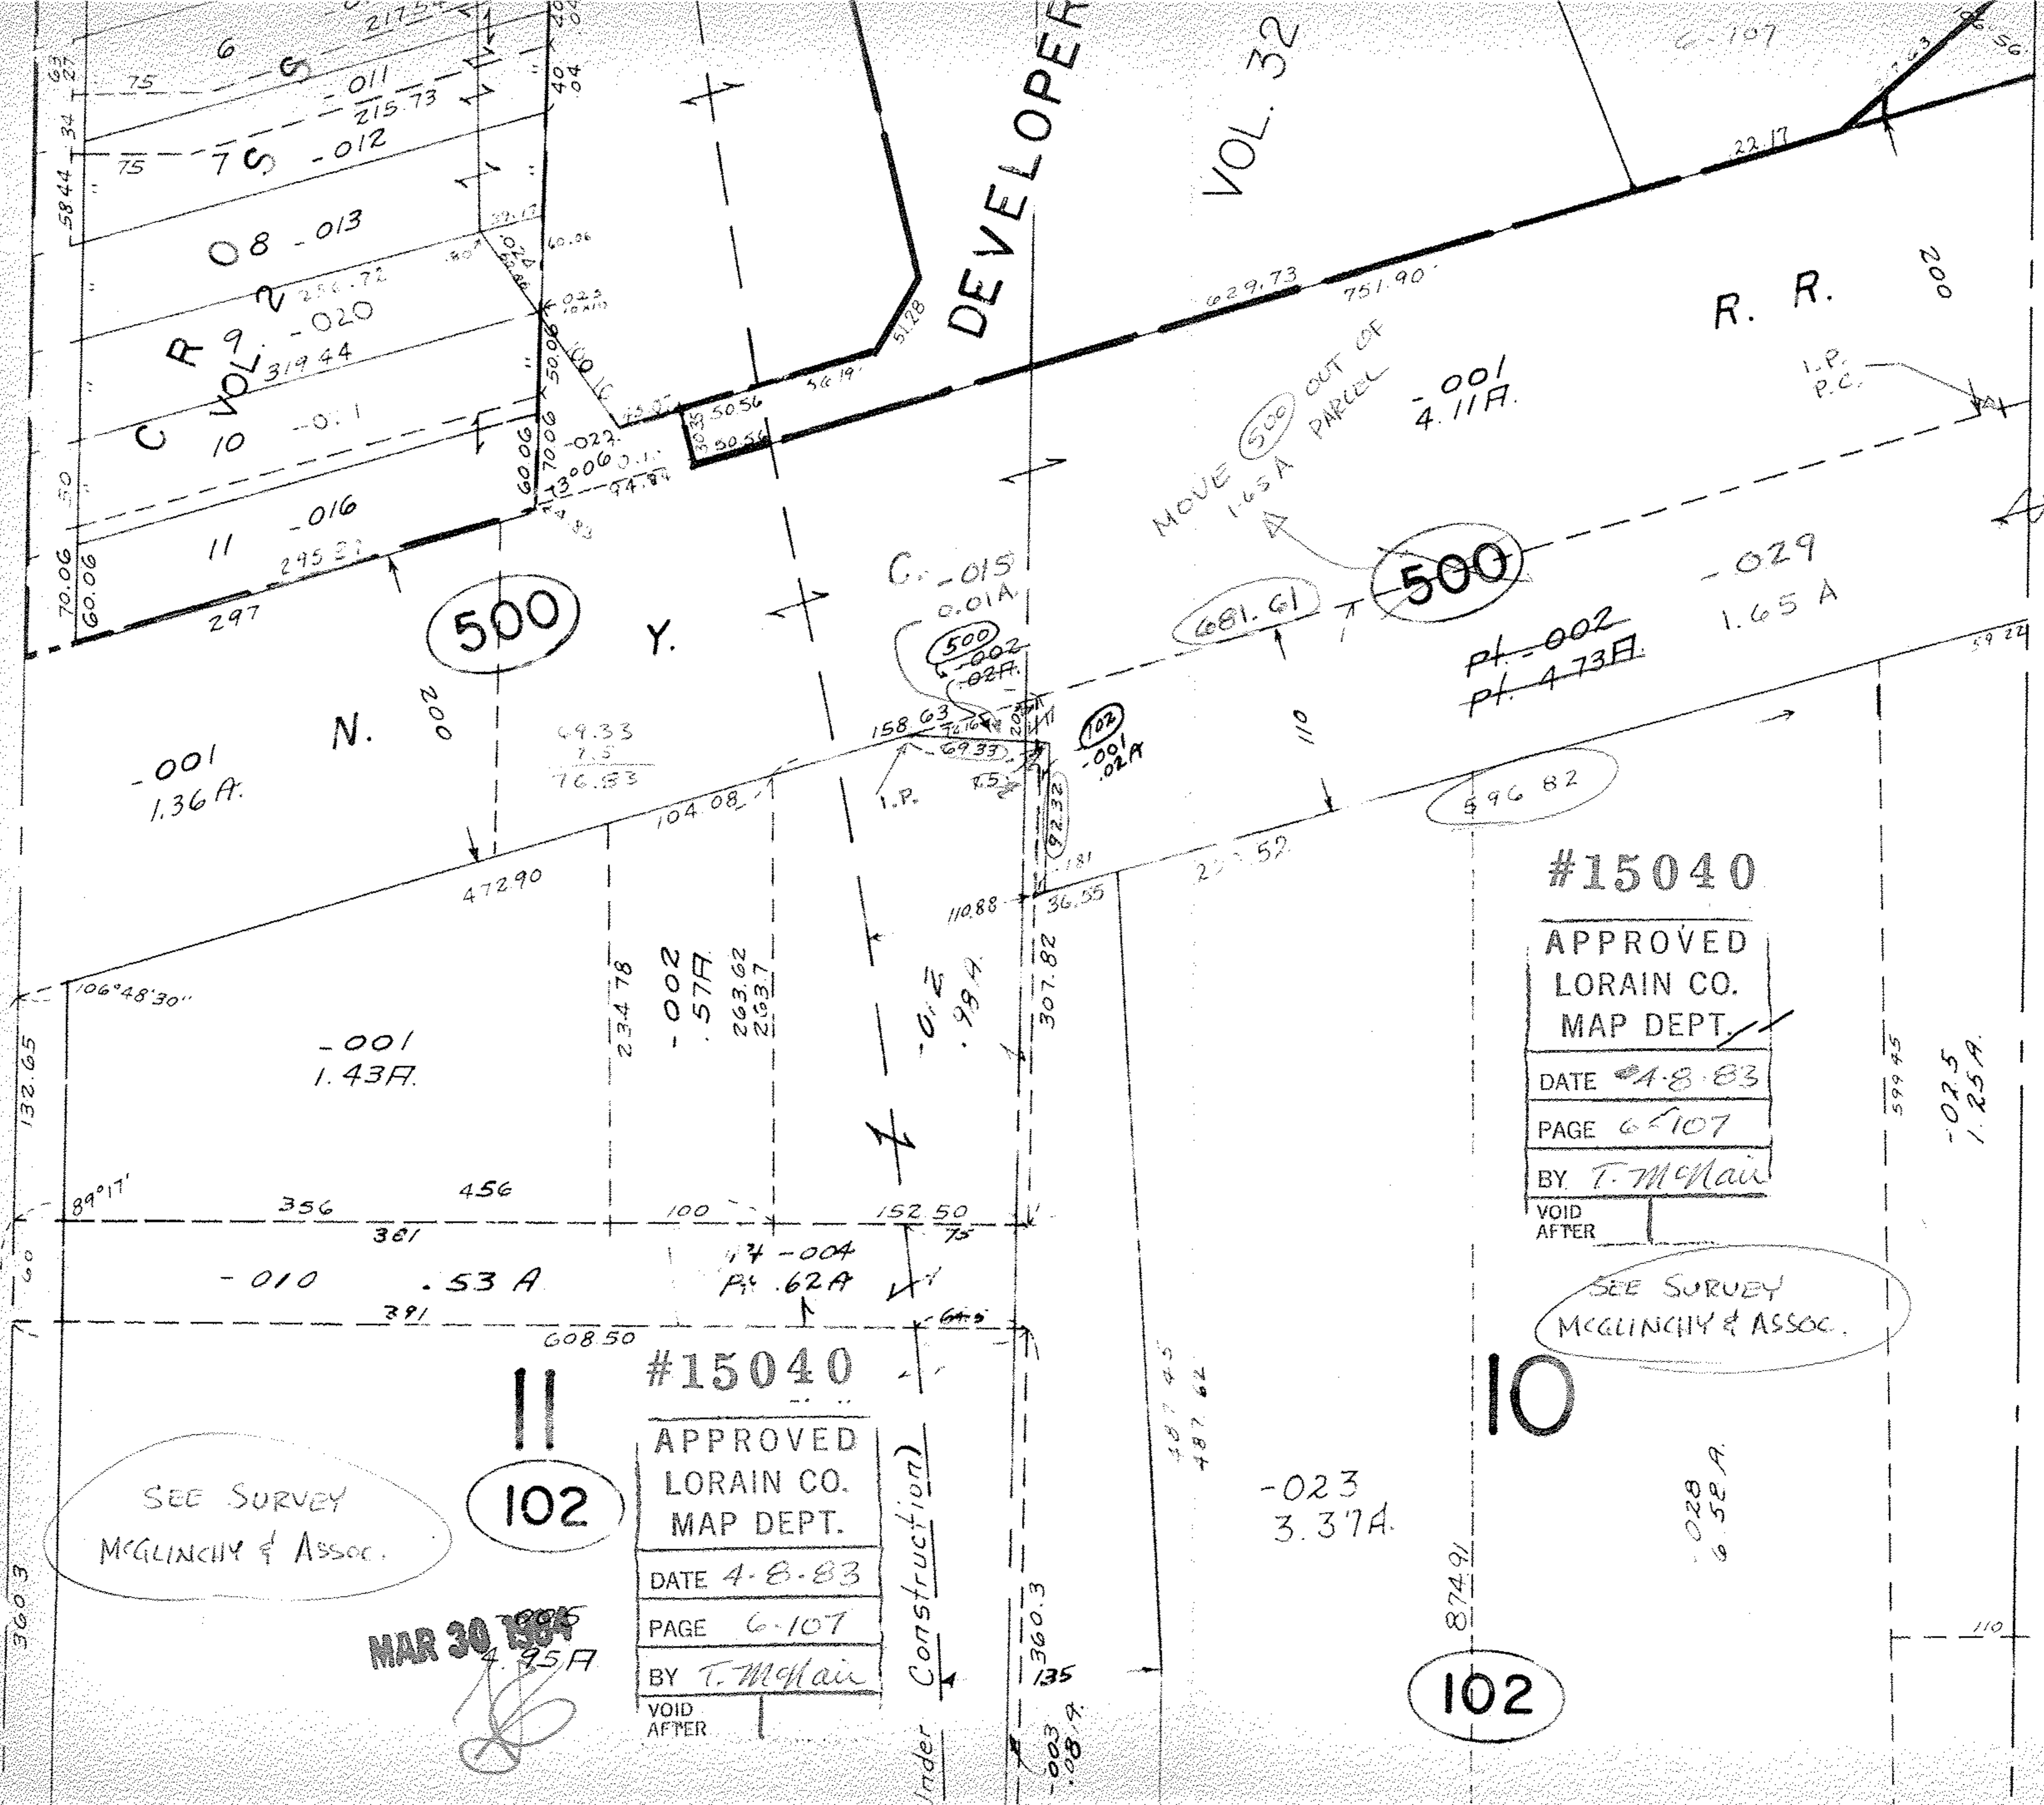

DEVELOPER

VOL. 32

R. R.

#15040

APPROVED  
LORAIN CO.  
MAP DEPT.

DATE 4-8-83

PAGE 6-107

BY T. McHair

VOID  
AFTER

SEE SURVEY  
MCGLINCHY & ASSOC.

10

102

500

500

500

681.61

596.82

102

#15040

APPROVED  
LORAIN CO.  
MAP DEPT.

DATE 4-8-83

PAGE 6-107

BY T. McHair

VOID  
AFTER

MAR 30 1984  
4.95 A

Under Construction

SEE 6-108