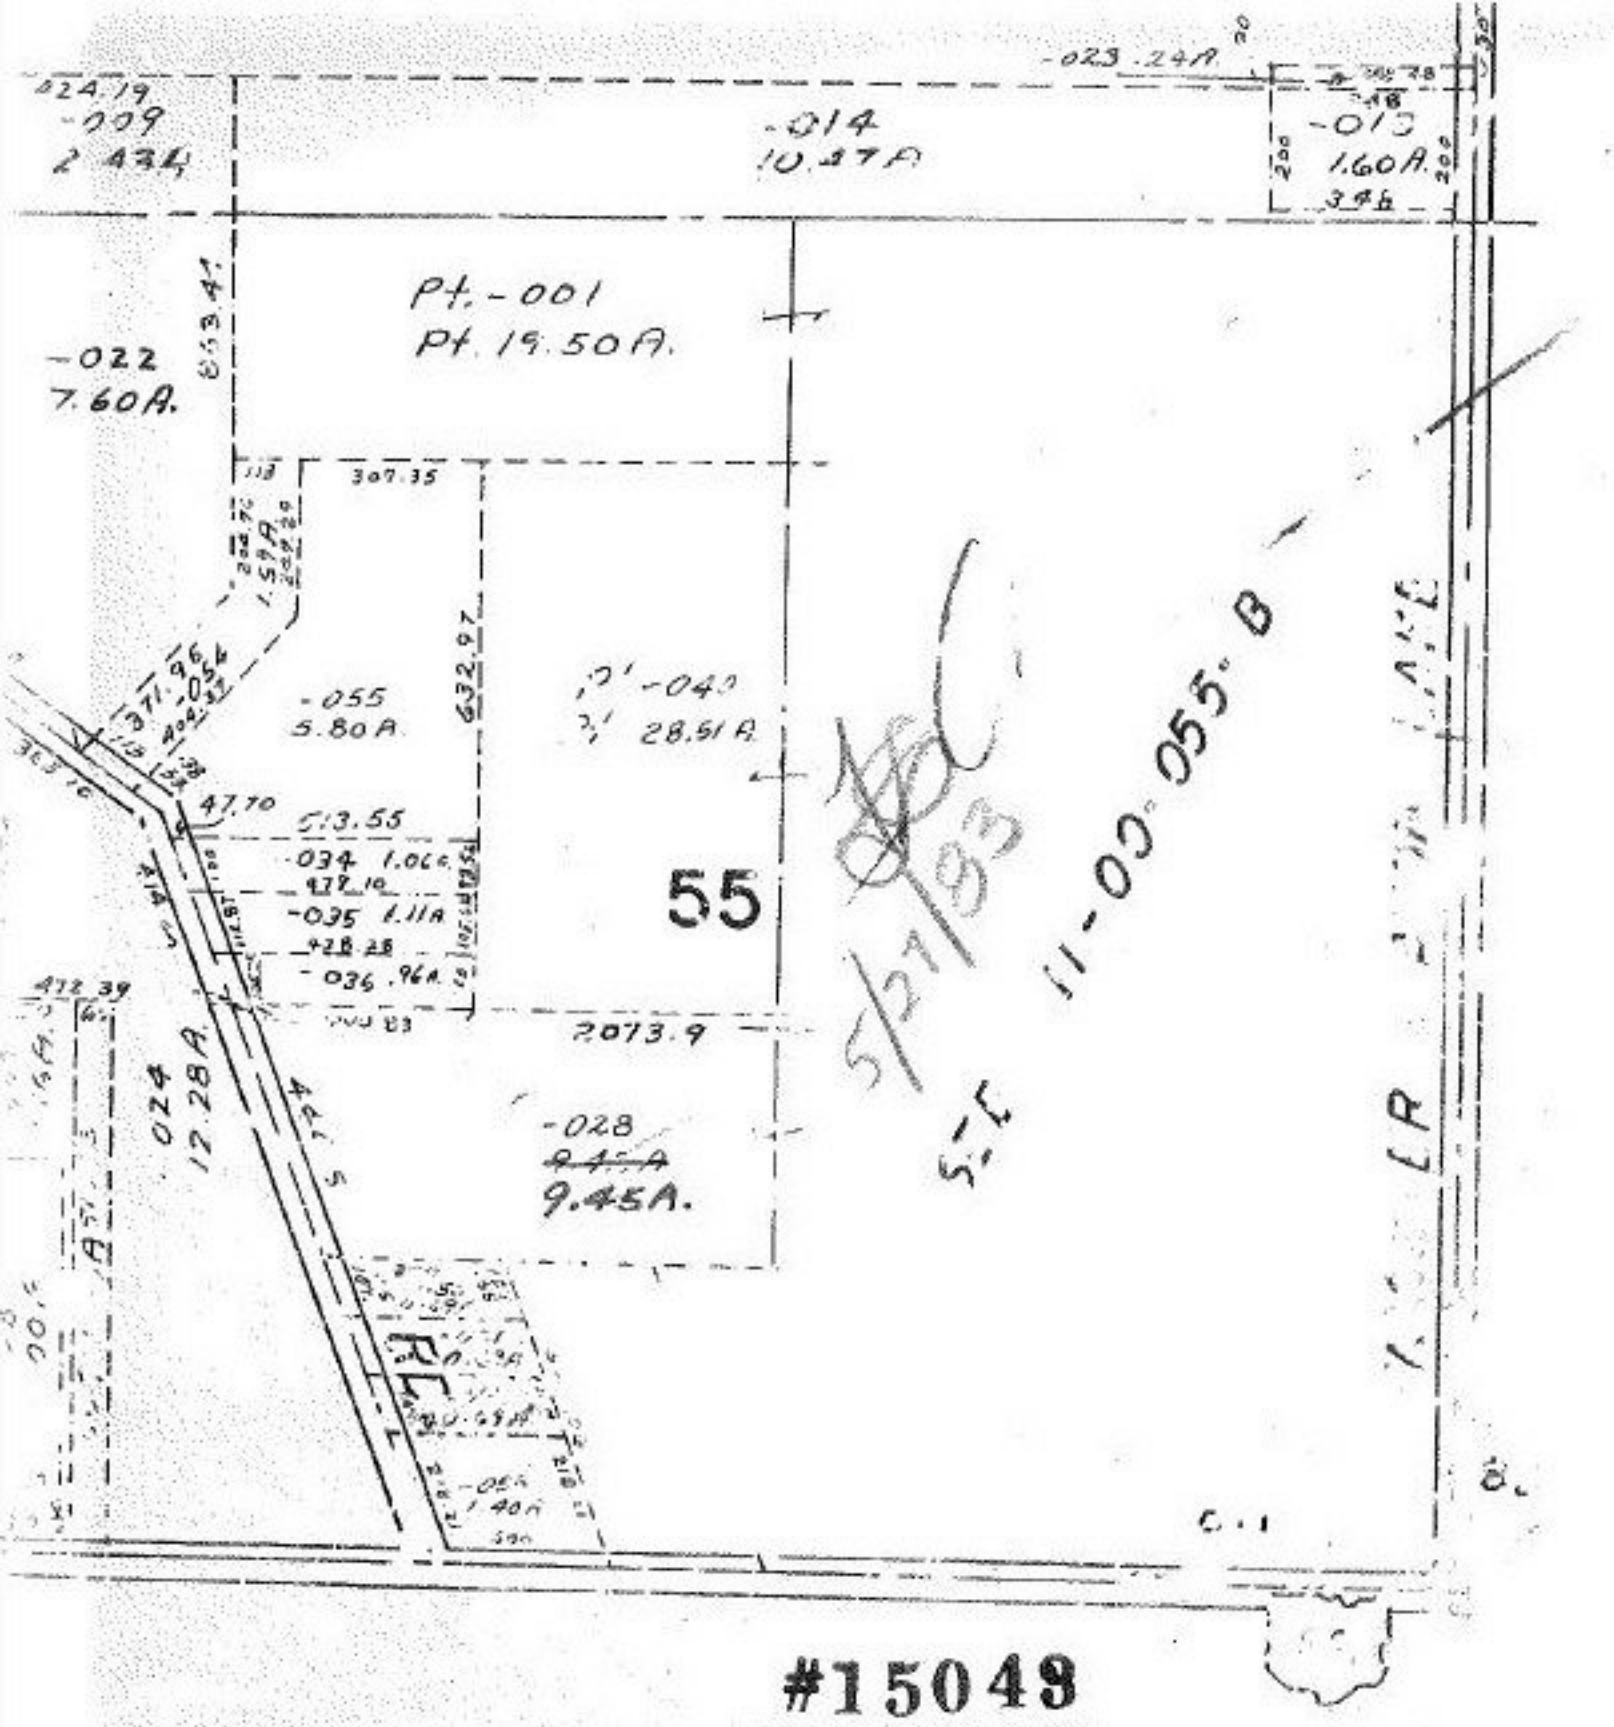

#15049

APPROVED LORAIN CO. MAP DEPT.
DATE 4-5-83
PAGE 11-B
BY Gallert
VOID AFTER

Copyright 1964
2-4-93

11-B