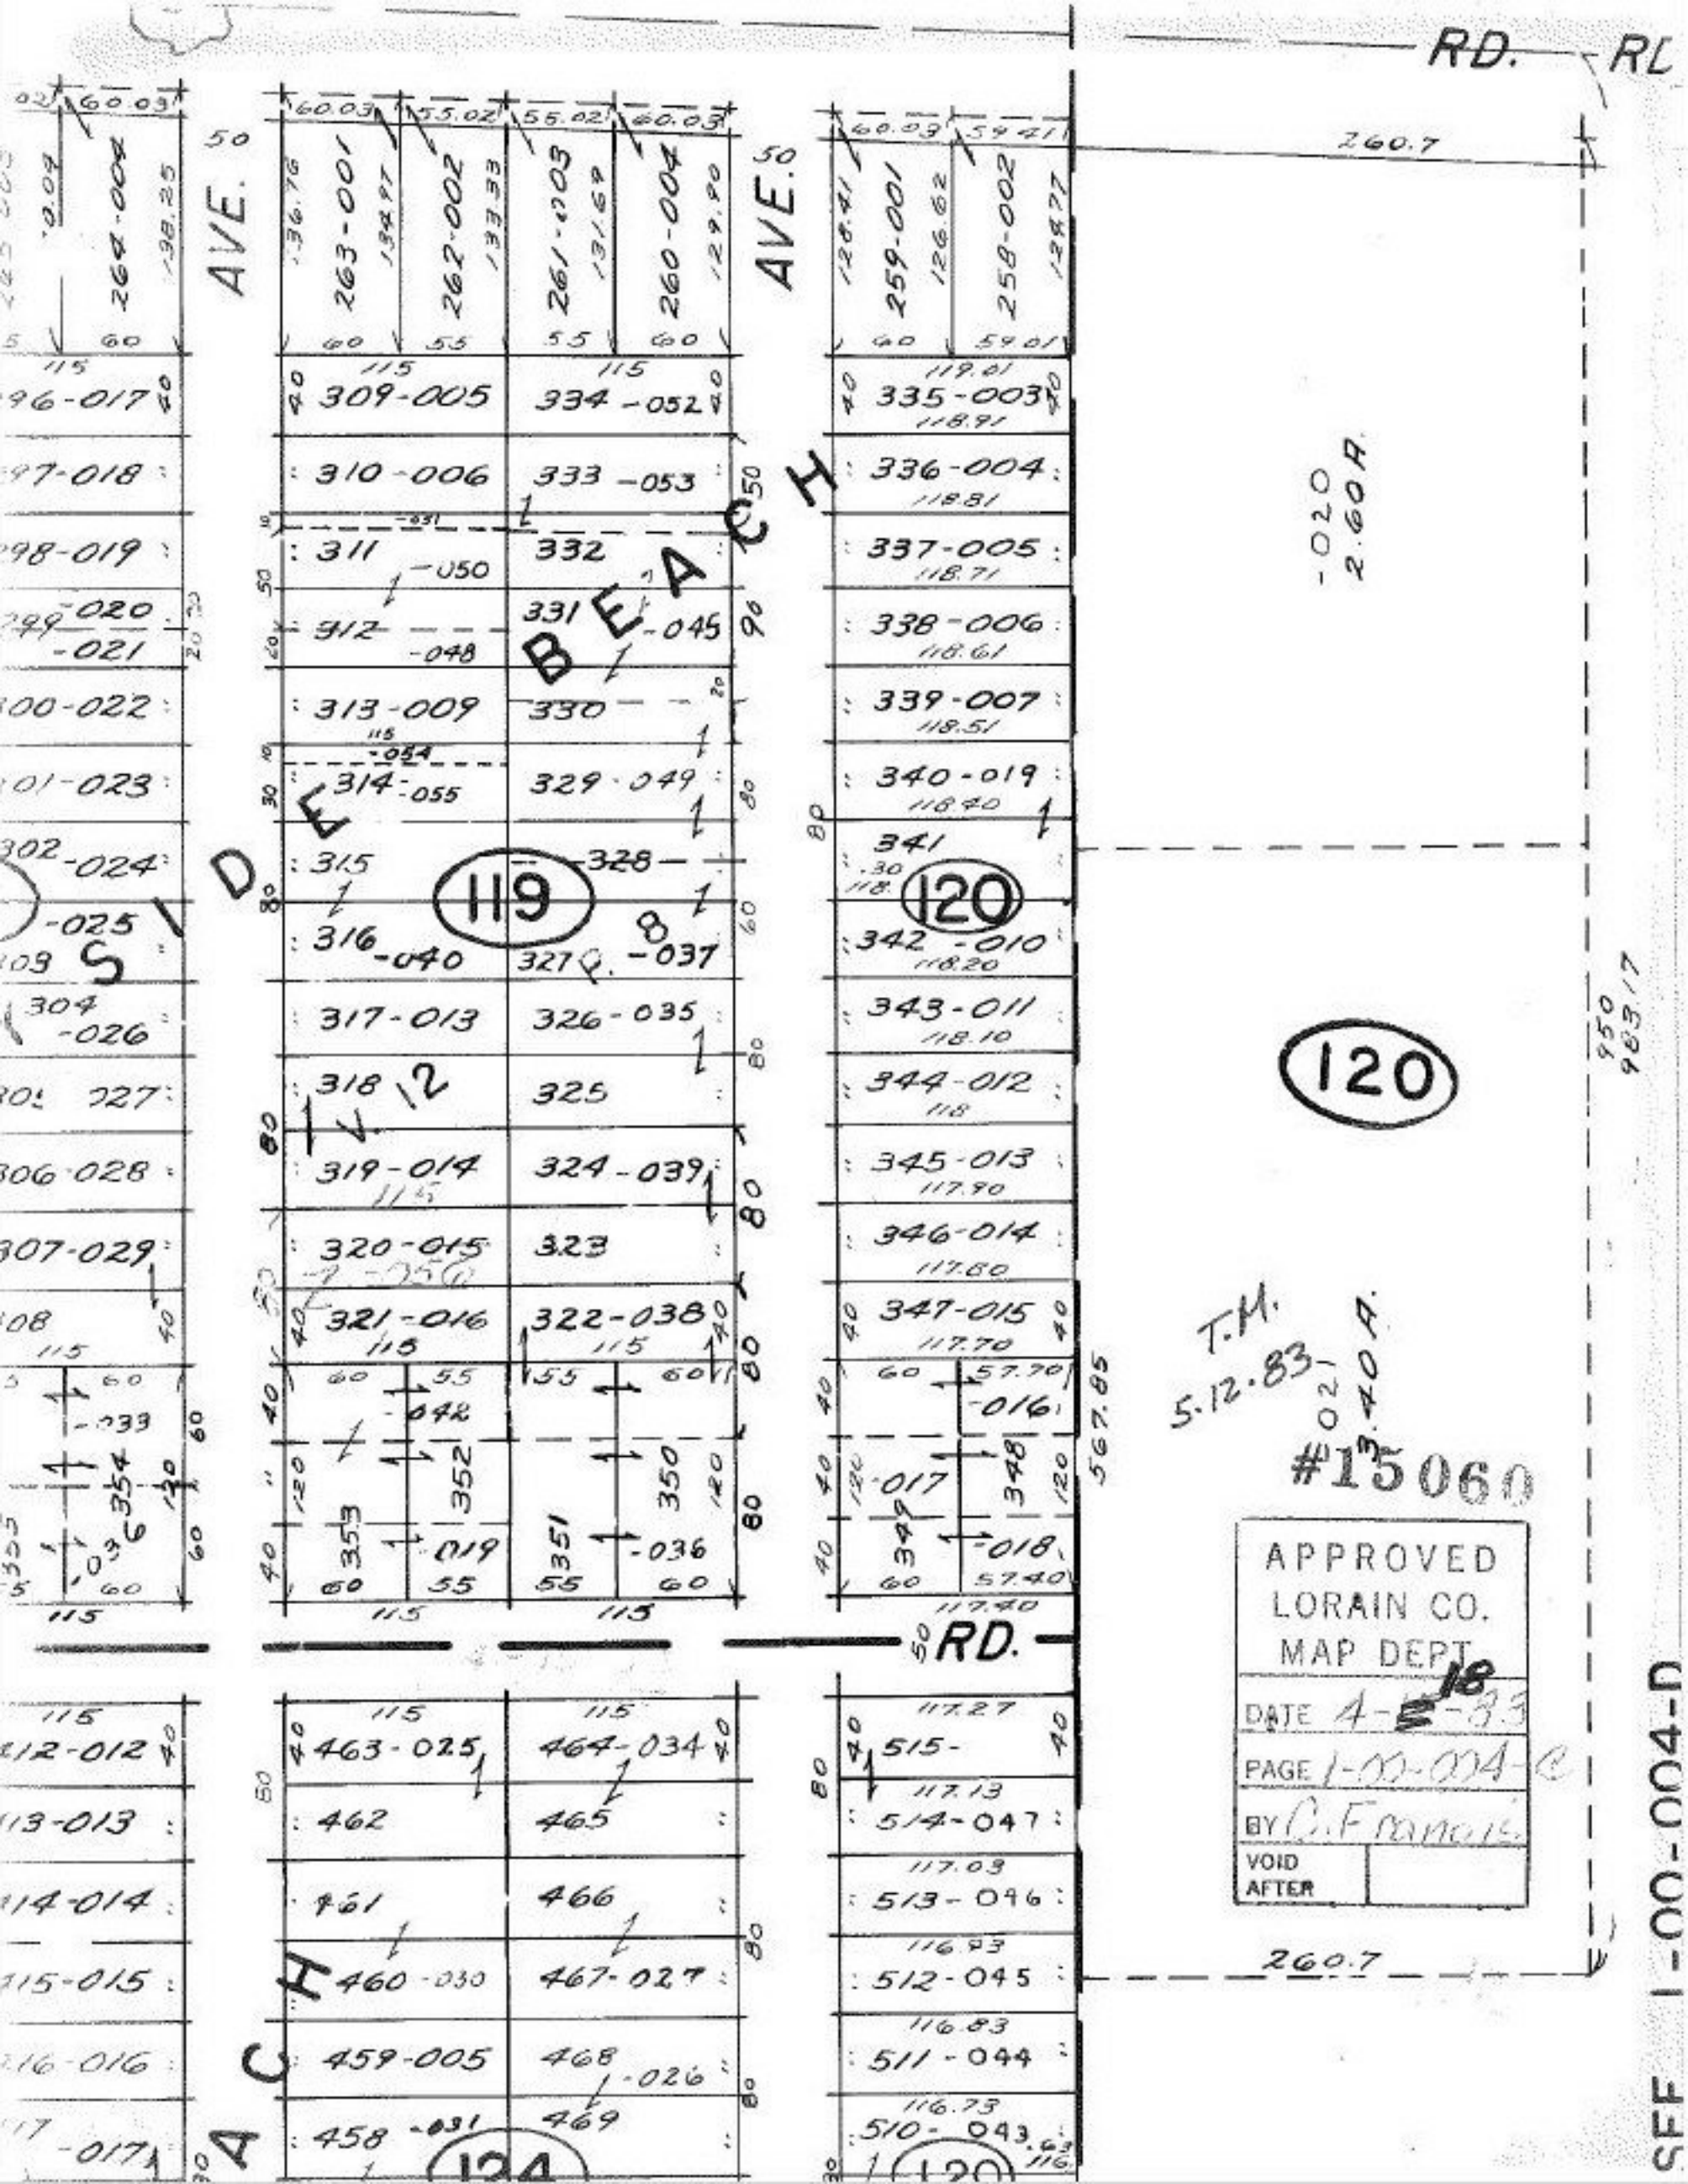

RD.
RD
260.7
AVE.
AVE.
SIDE BEACH
BEACH
RD.
119
120
120
124
120
-020
2.60 A.
T.M.
5.12.83
021
3.40 A.
#15060
APPROVED
LORAIN CO.
MAP DEPT.
DATE 4-18-83
PAGE 1-00-004-C
BY C. Francis
VOID AFTER
260.7
SFF 1-00-004-D