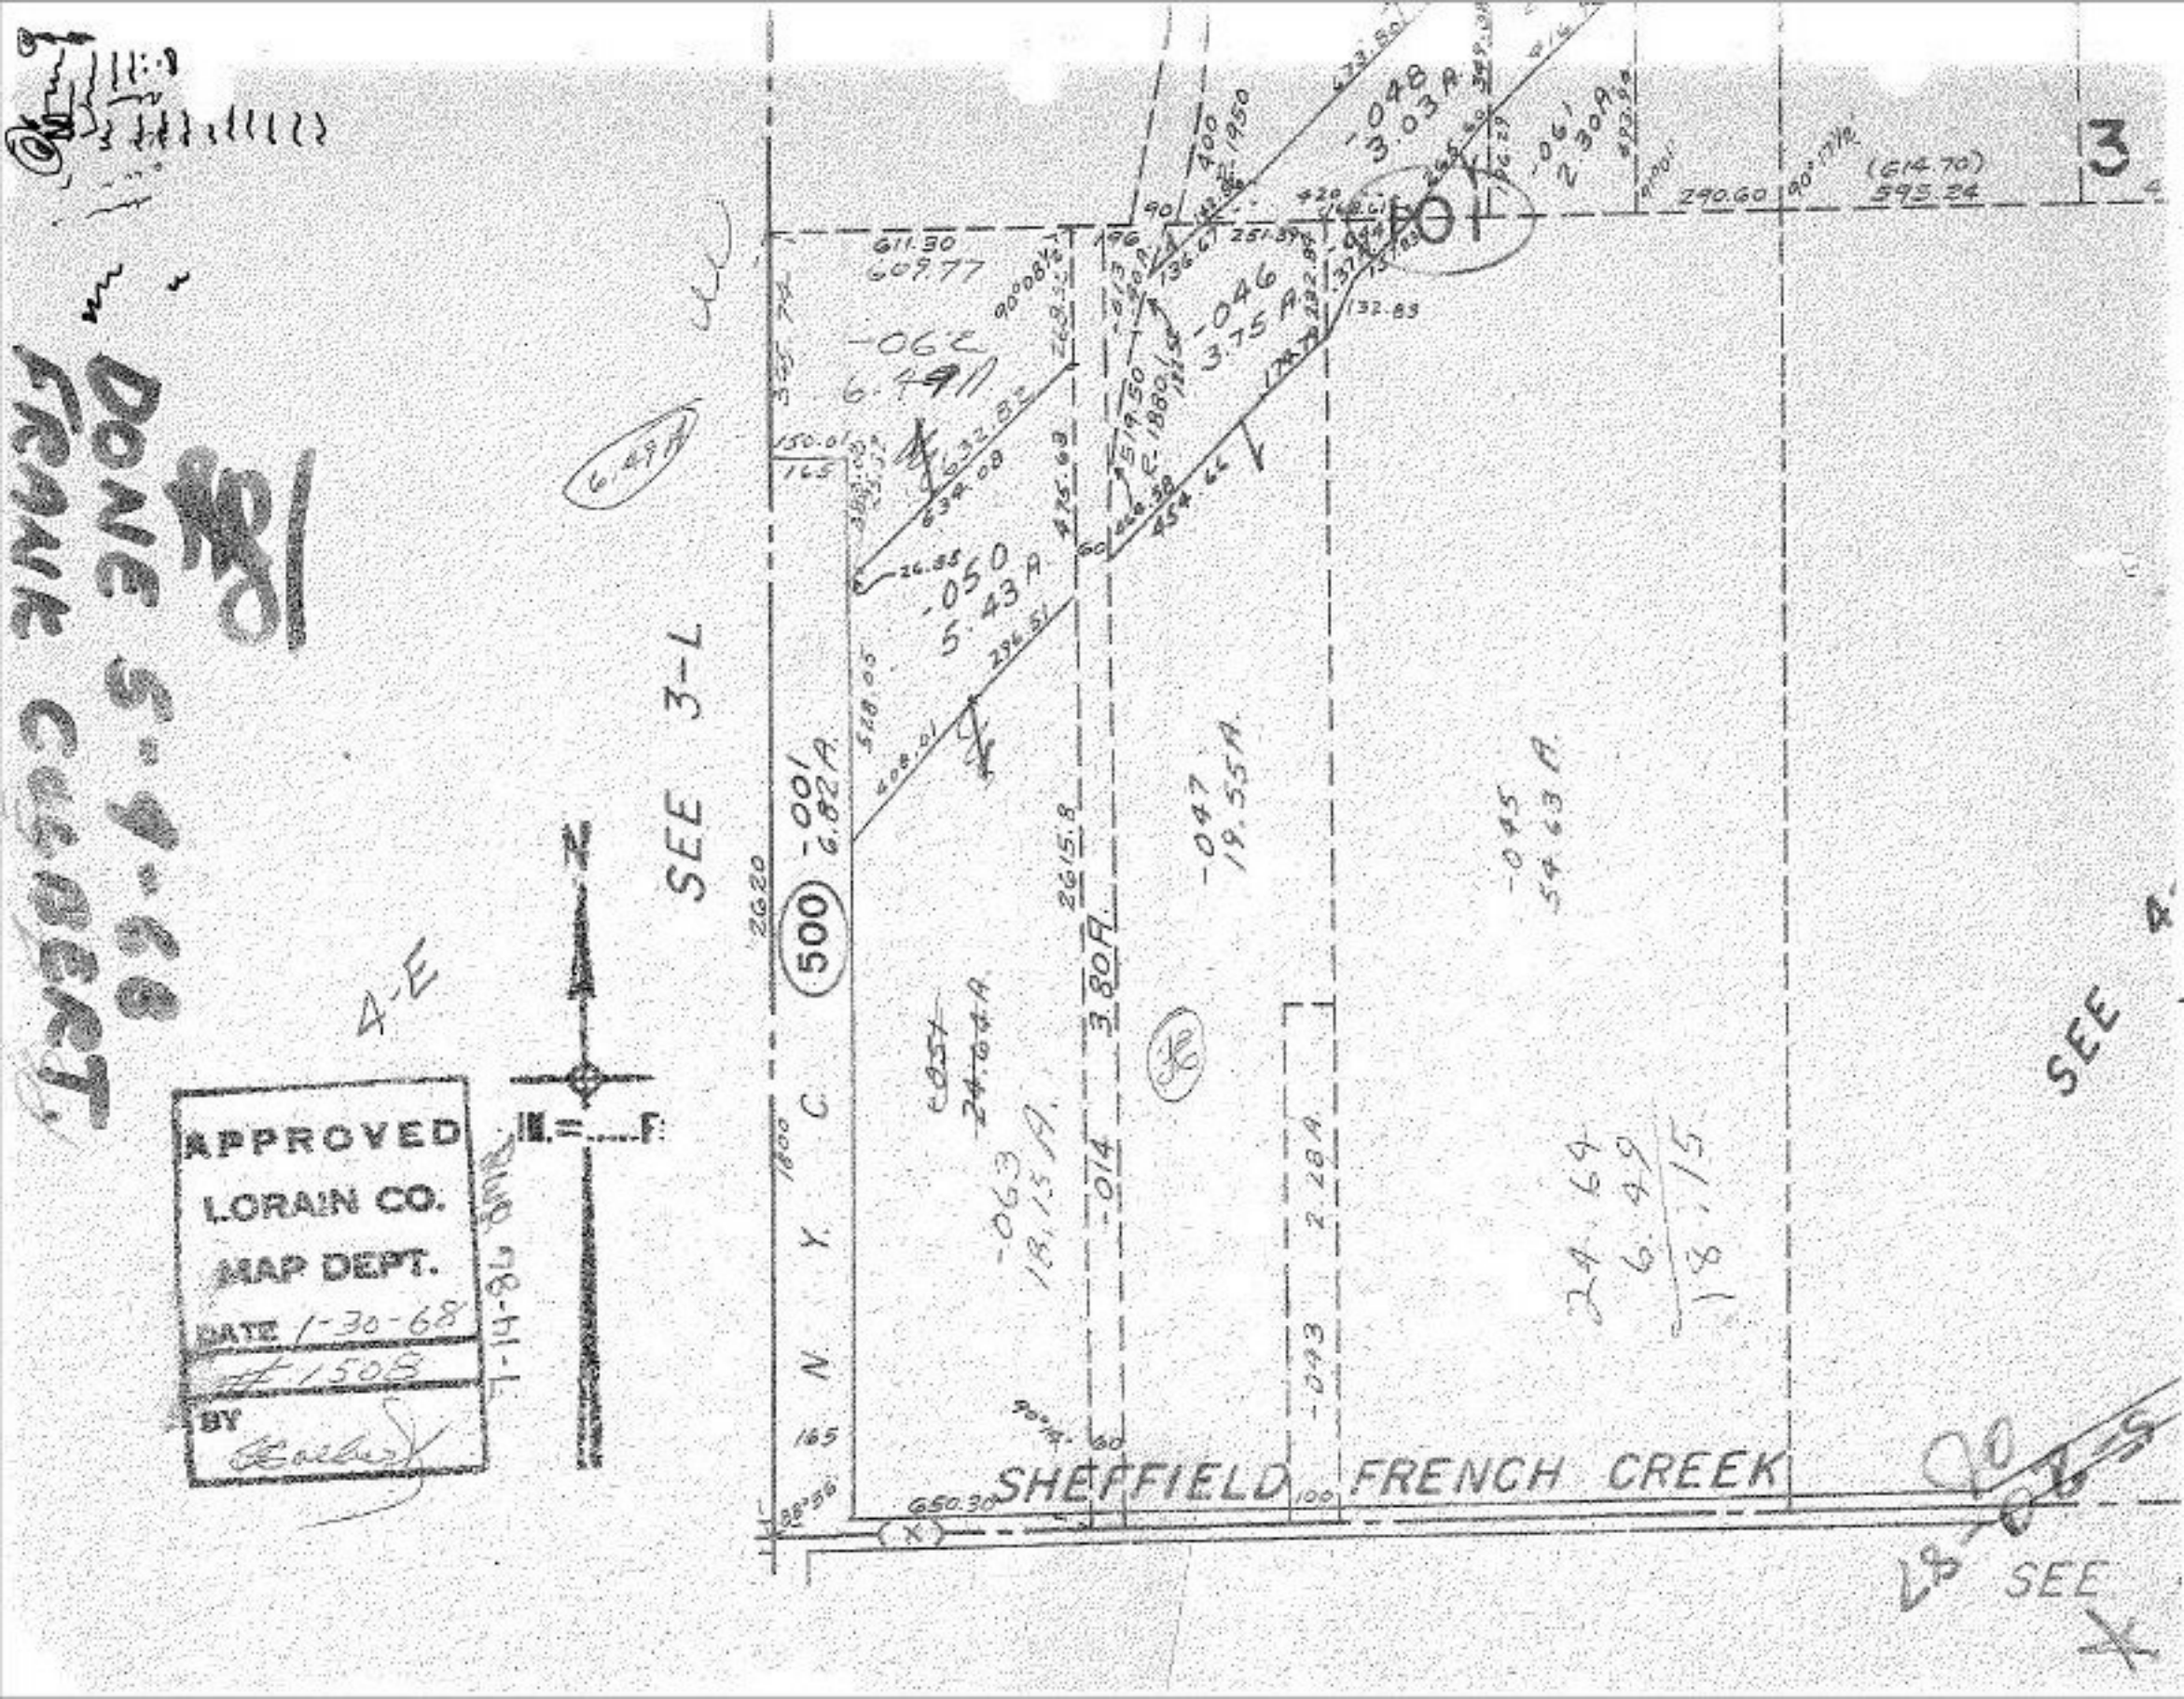

3
SEE 3-L
SEE
SEE
SHEFFIELD FRENCH CREEK
N. Y. C.
500
-001
6.82 A.
-062
6.49 A
-050
5.43 A
-046
3.75 A
-048
3.03 A
-061
2.30 A
-047
19.55 A
-045
54.63 A
-063
18.15 A
-014
3.80 A
-043
2.28 A
24.64
6.49
18.15
(614.70)
595.24
290.60
611.30
609.77
650.30
4-E
N
APPROVED
LORAIN CO.
MAP DEPT.
DATE 1-30-68
#1508
BY
DONE 5-9-68
FRANK CUSBERT