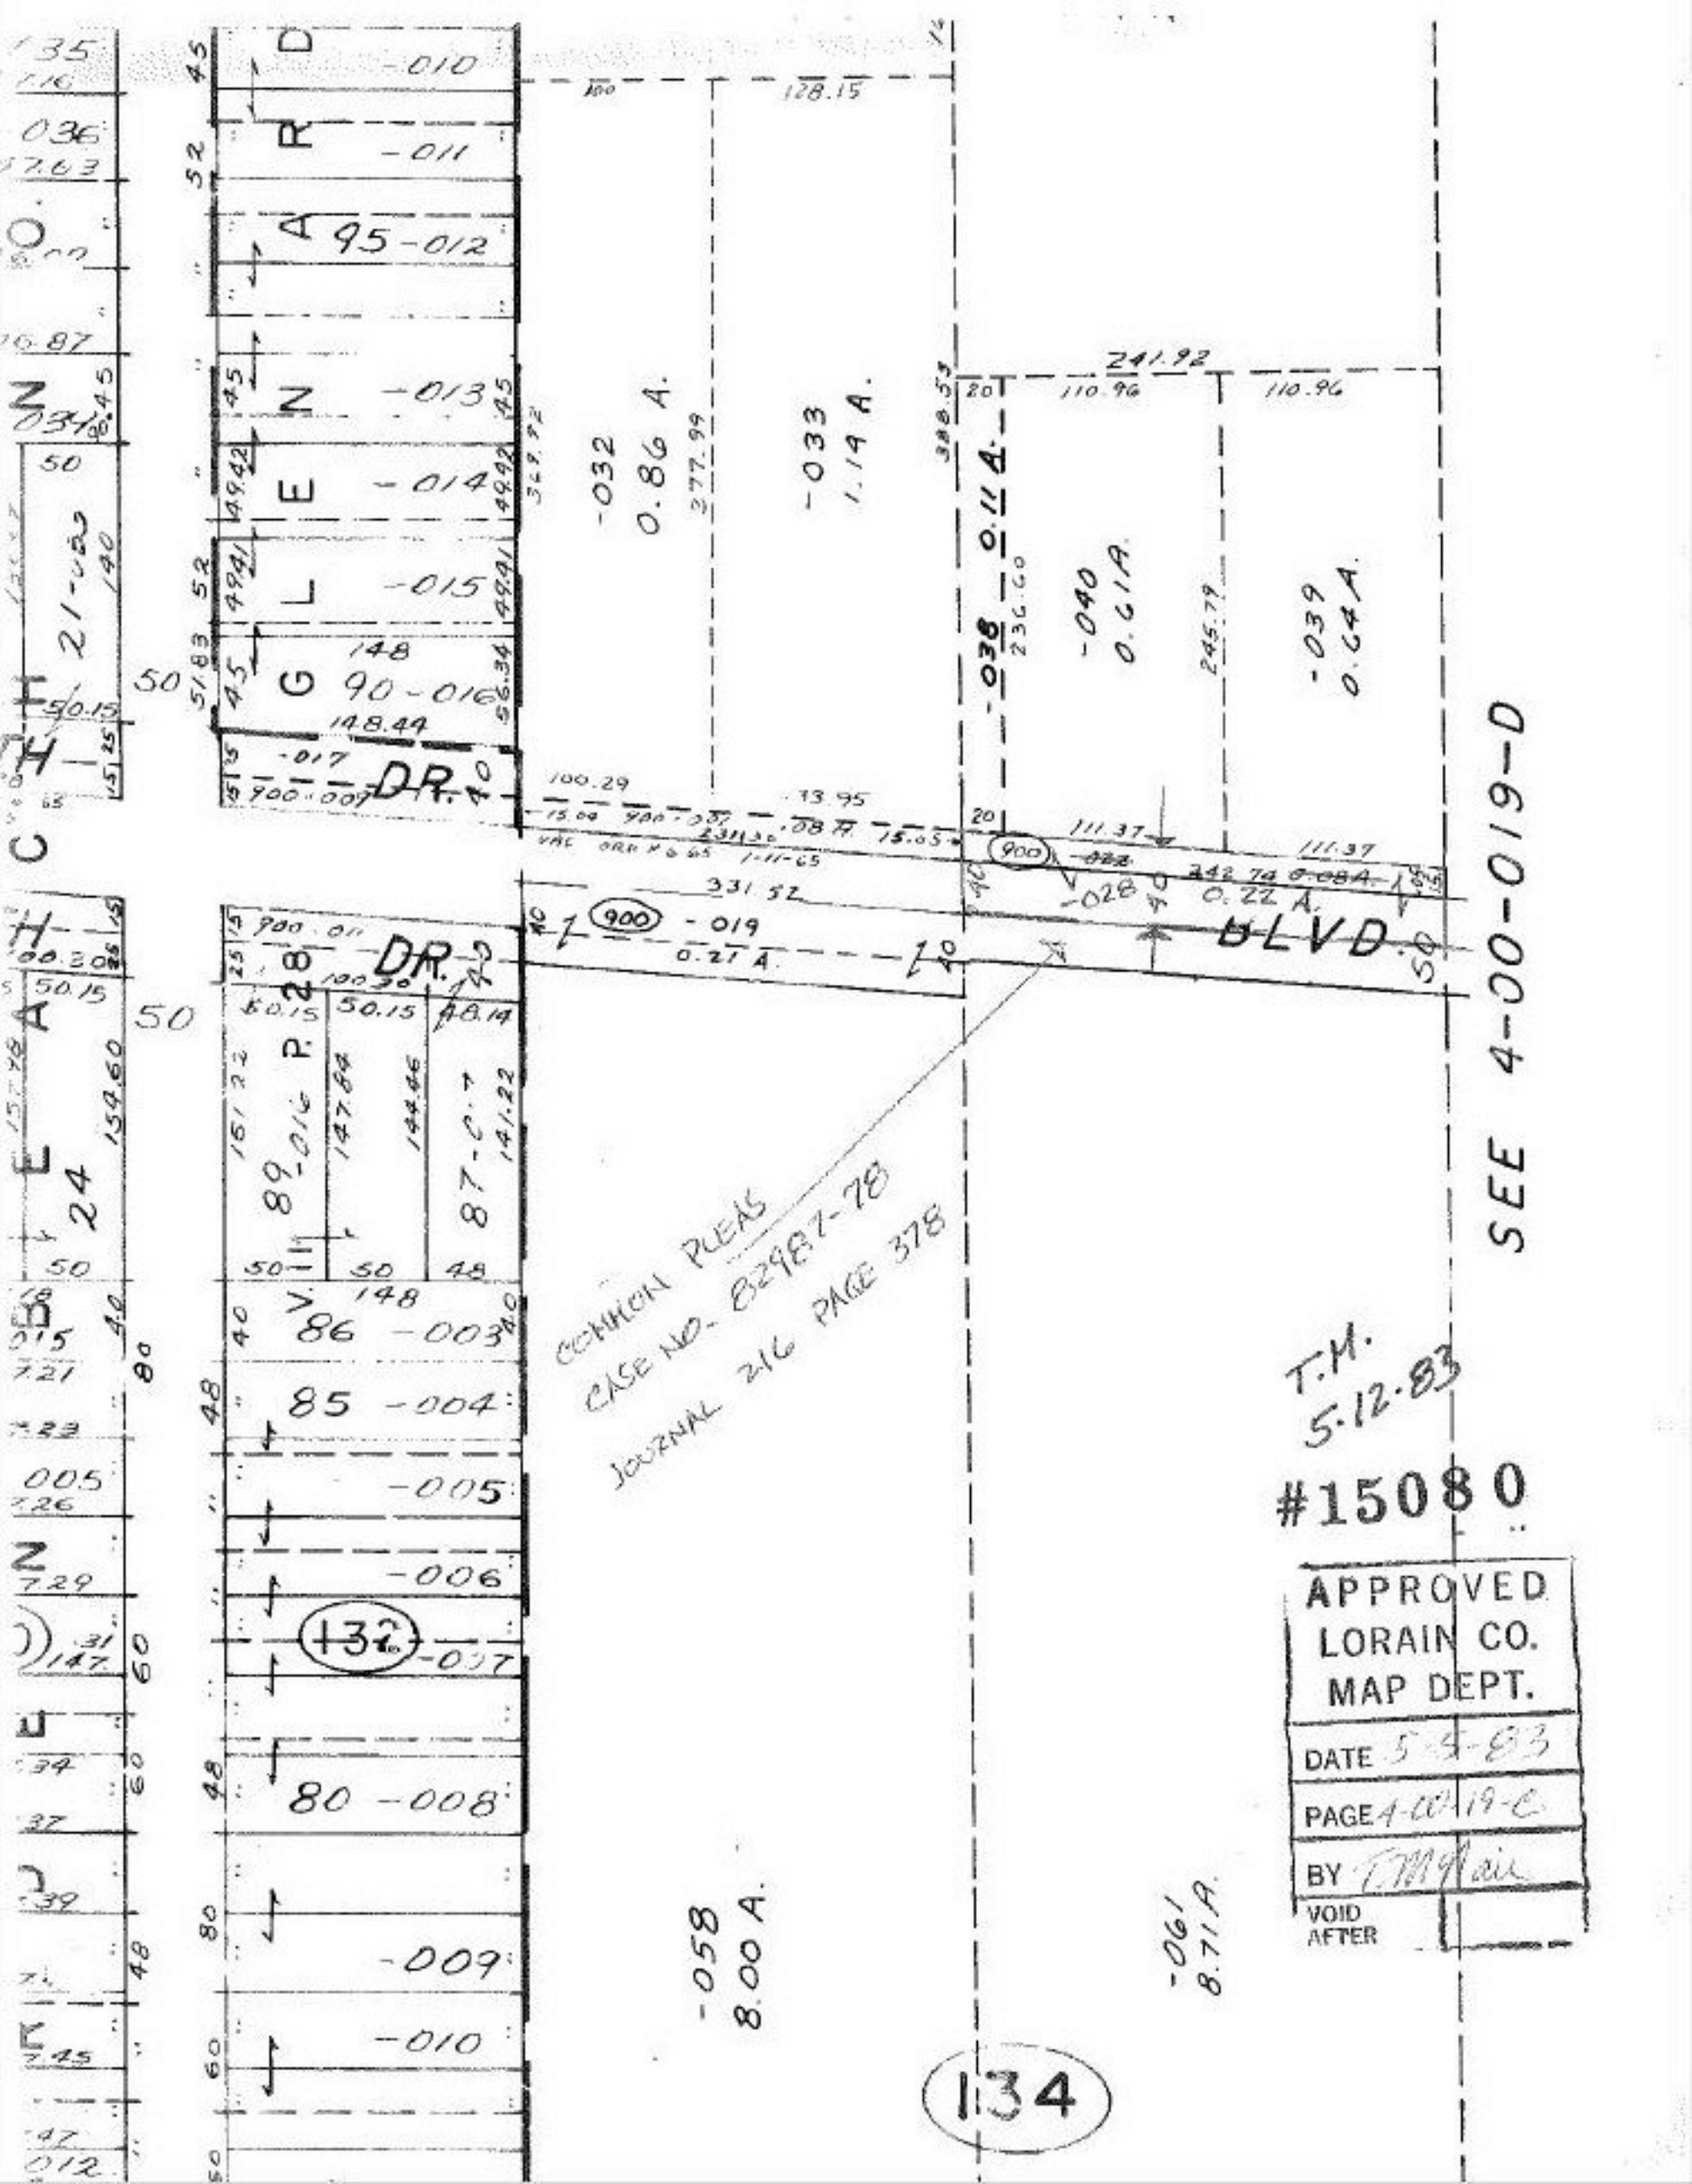

GLENARD
DR.
BLVD.
SEE 4-00-019-D
COMMON PLEAS
CASE NO. 82987-78
JOURNAL 216 PAGE 378
T.M.
5.12.83
#15080
APPROVED
LORAIN CO.
MAP DEPT.
DATE 5-5-83
PAGE 4-00-19-C
BY T.M. Nair
VOID
AFTER
-032
0.86 A.
-033
1.14 A.
-038
0.11 A.
-040
0.61 A.
-039
0.64 A.
-058
8.00 A.
-061
8.71 A.
-010
-011
95-012
-013
-014
-015
90-016
-017
-019
0.21 A.
-028
0.22 A.
86 -003
85 -004
-005
-006
-007
80 -008
-009
-010
132
134