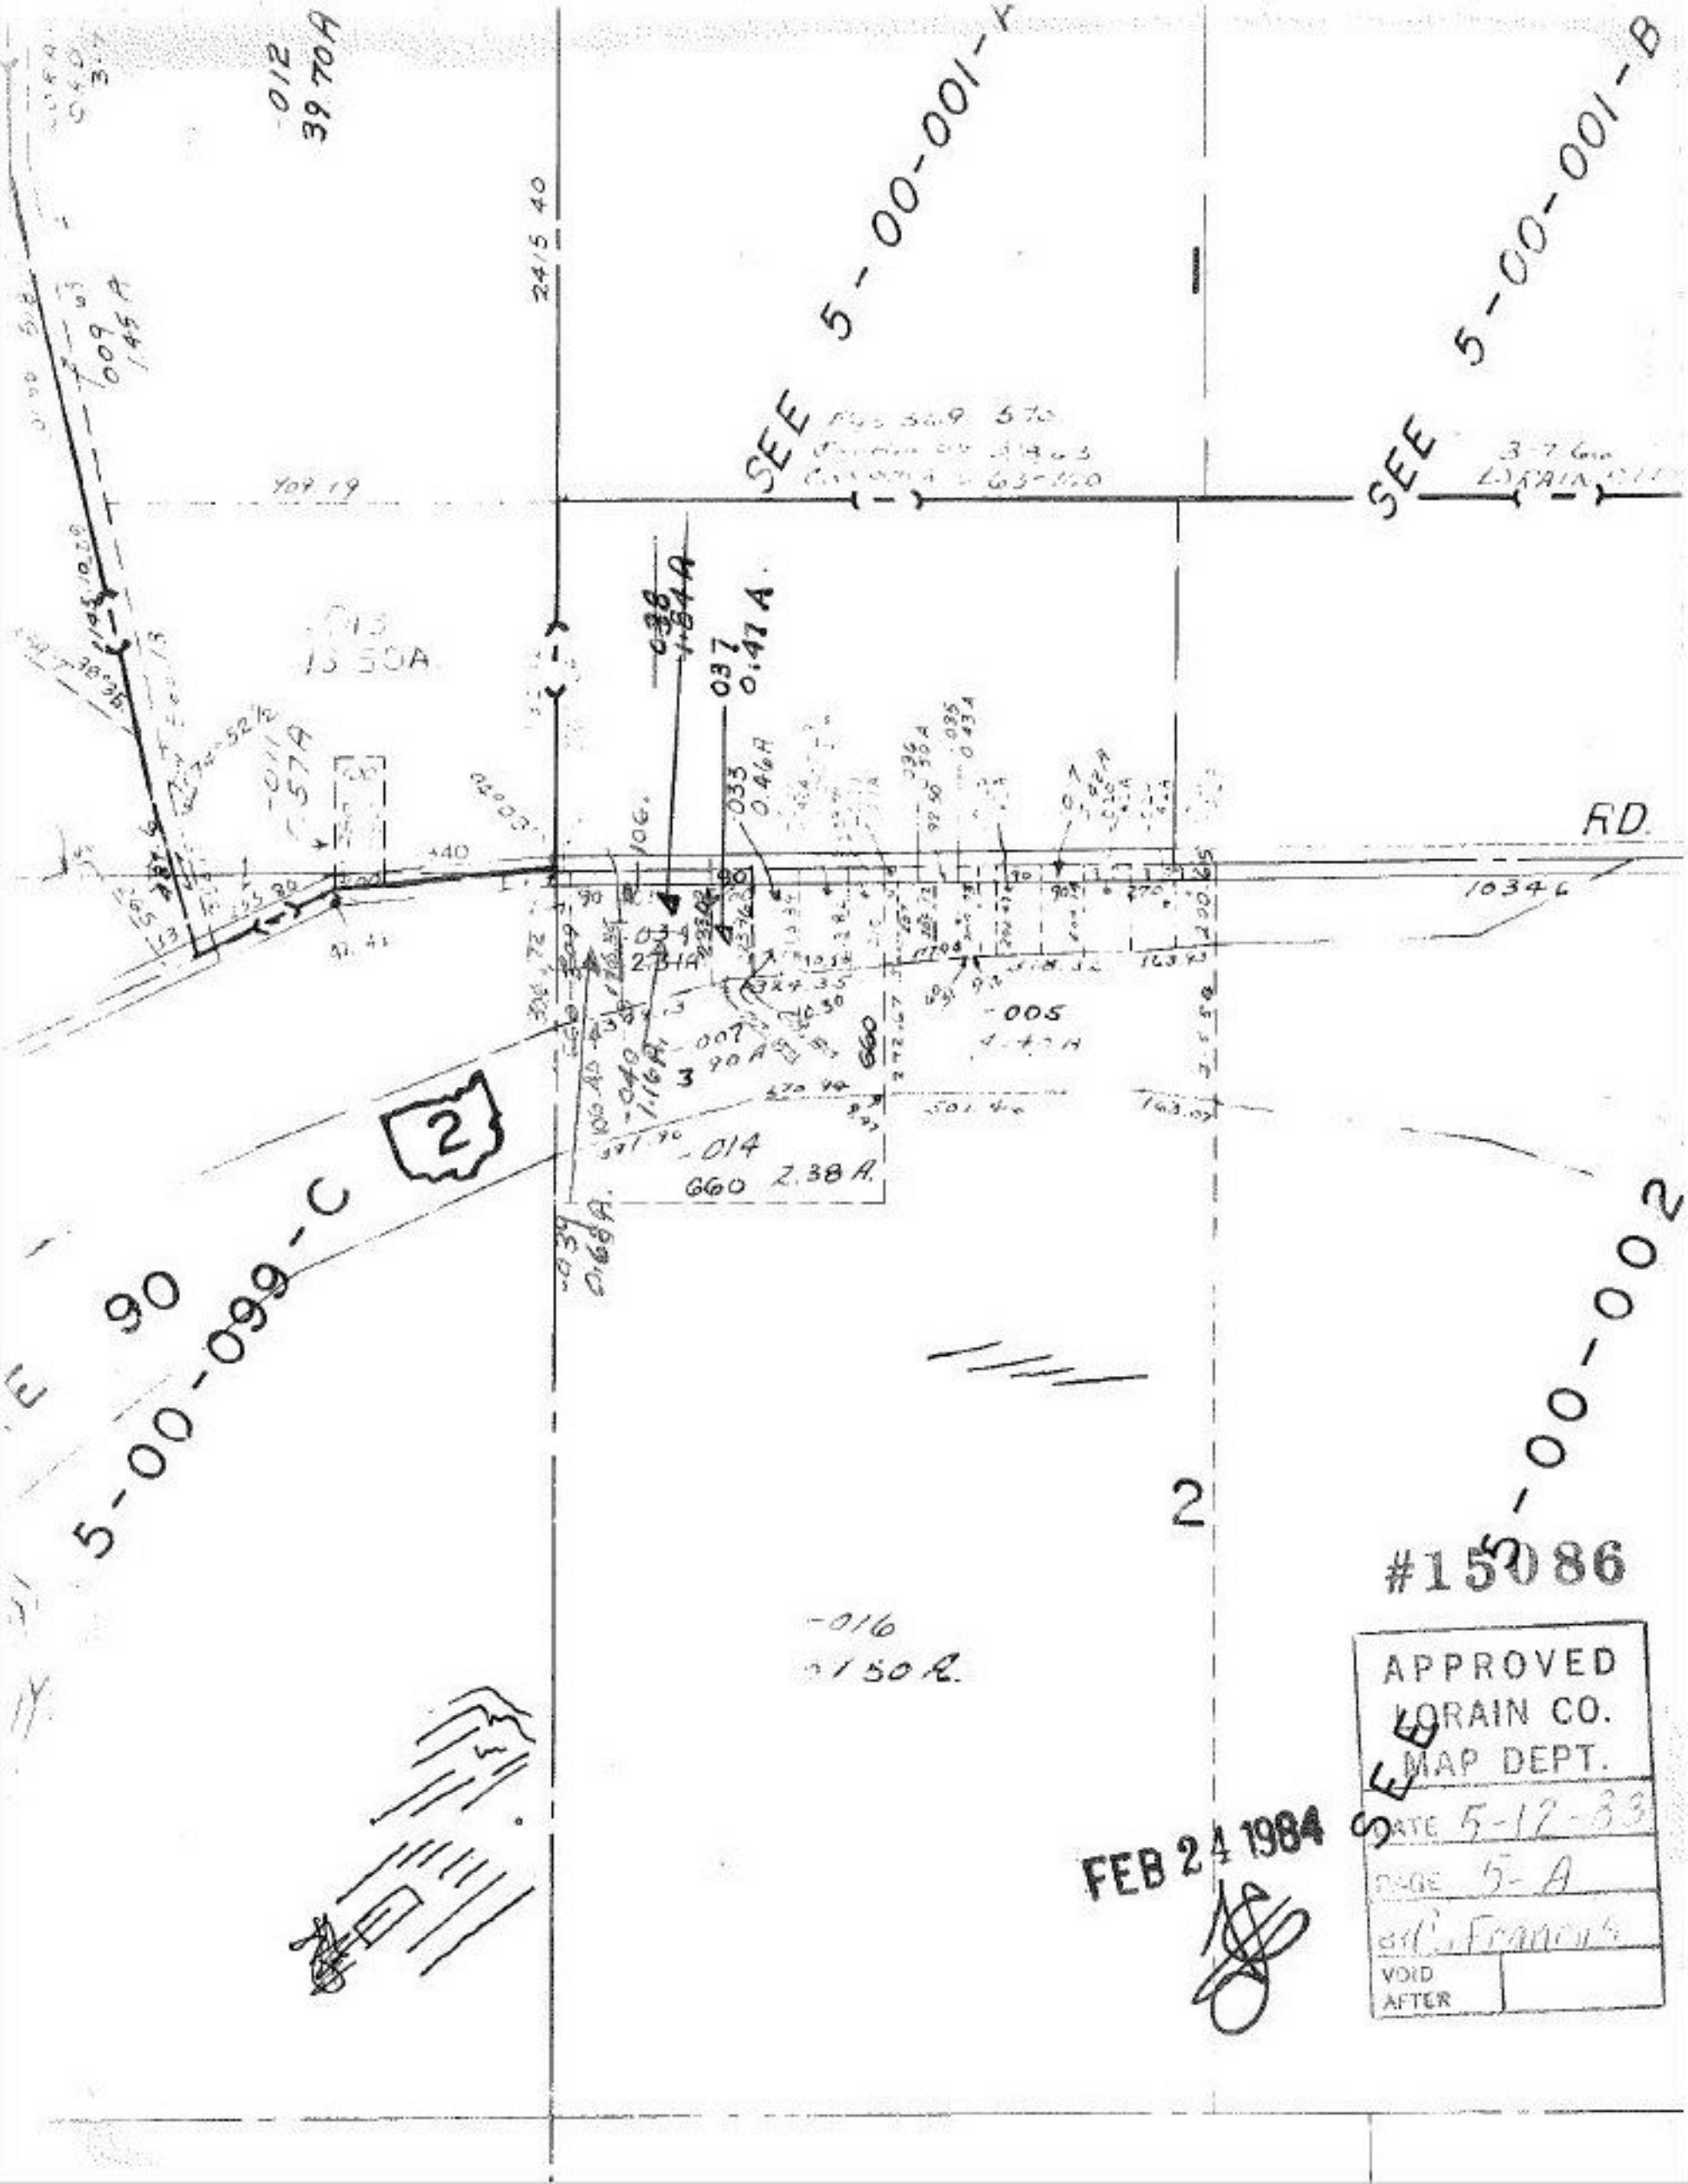

SEE 5-00-001-A
SEE 5-00-001-B
SEE 5-00-002
SEE 5-00-099-C
RD.
2
#15086
APPROVED
LORAIN CO.
MAP DEPT.
DATE 5-12-83
PAGE 5-A
BY C. Francis
VOID AFTER
FEB 24 1984