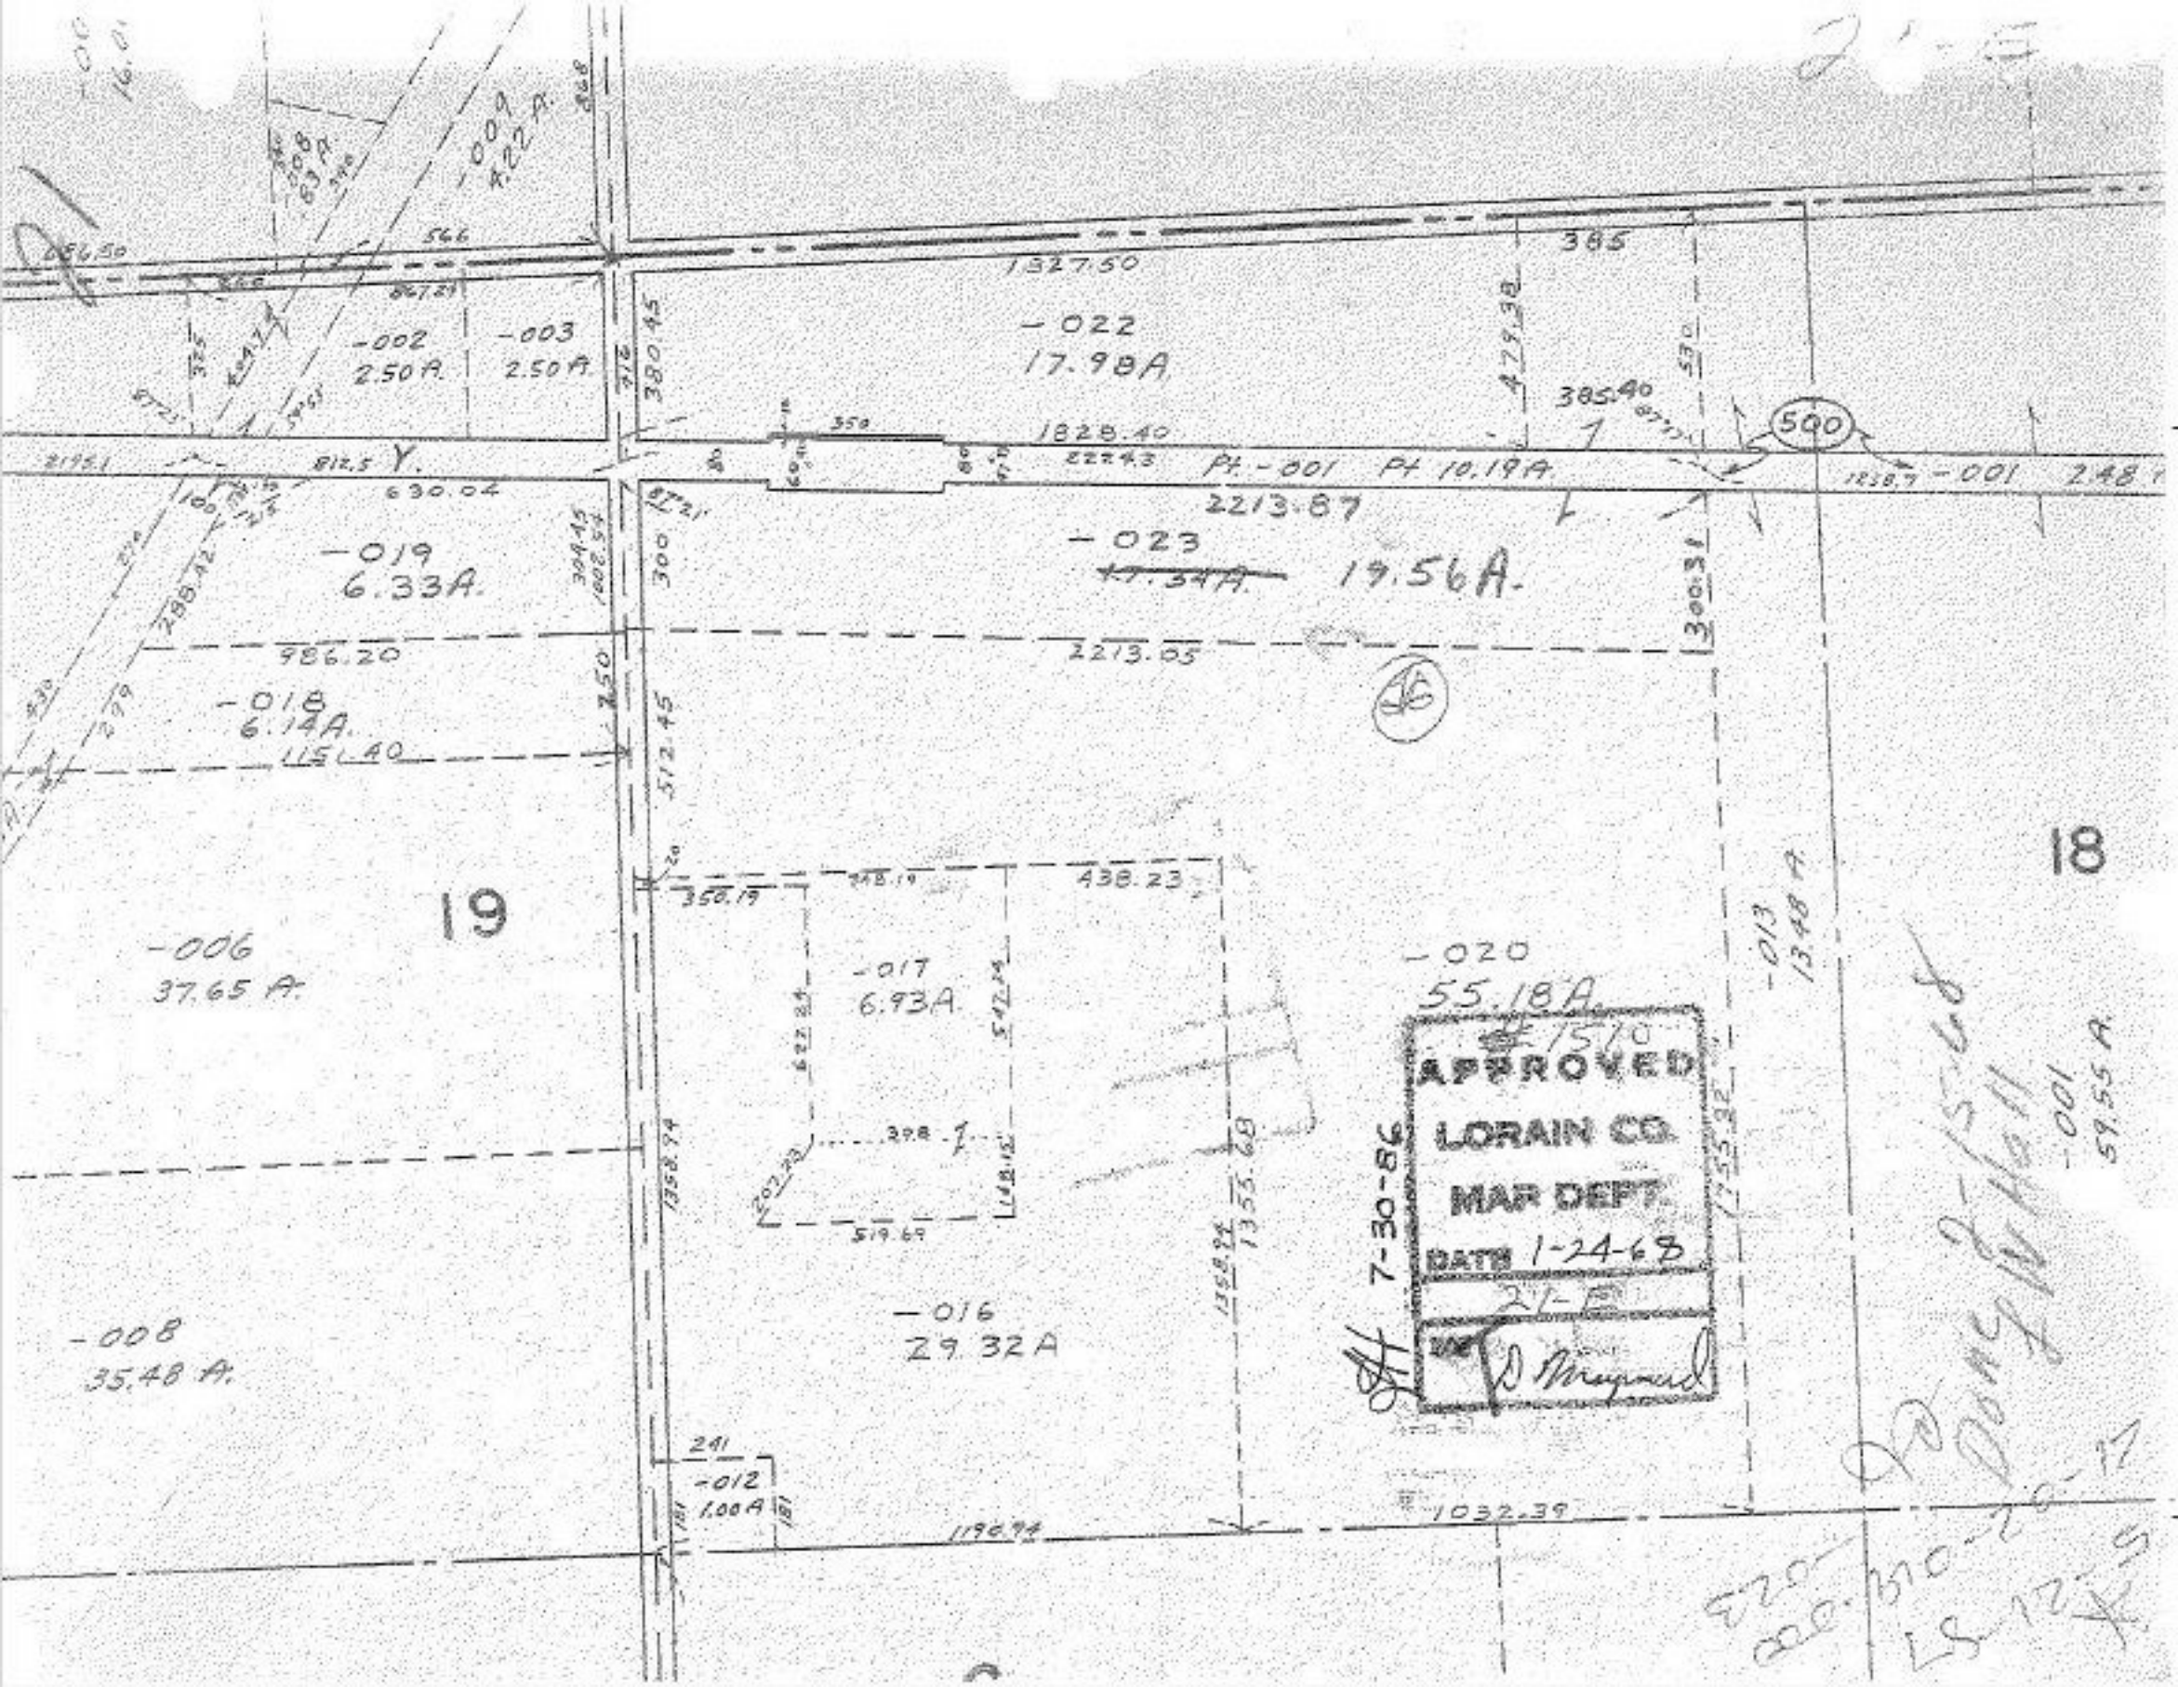
-002
2.50 A.
-003
2.50 A.
-022
17.98A.
1327.50
385
385.40
1828.40
Pt. -001 Pt. 10.19A.
2213.87
-023
19.56A.
-019
6.33A.
-018
6.14A.
986.20
2213.05
-006
37.65 A.
19
-017
6.93A.
-020
55.18A.
APPROVED
LORAIN CO.
MAR DEPT.
DATE 1-24-68
7-30-86
18
-013
13.48 A.
-001
59.55 A.
-008
35.48 A.
-016
29.32A
-012
1.00A
241
1196.94
1032.39
500