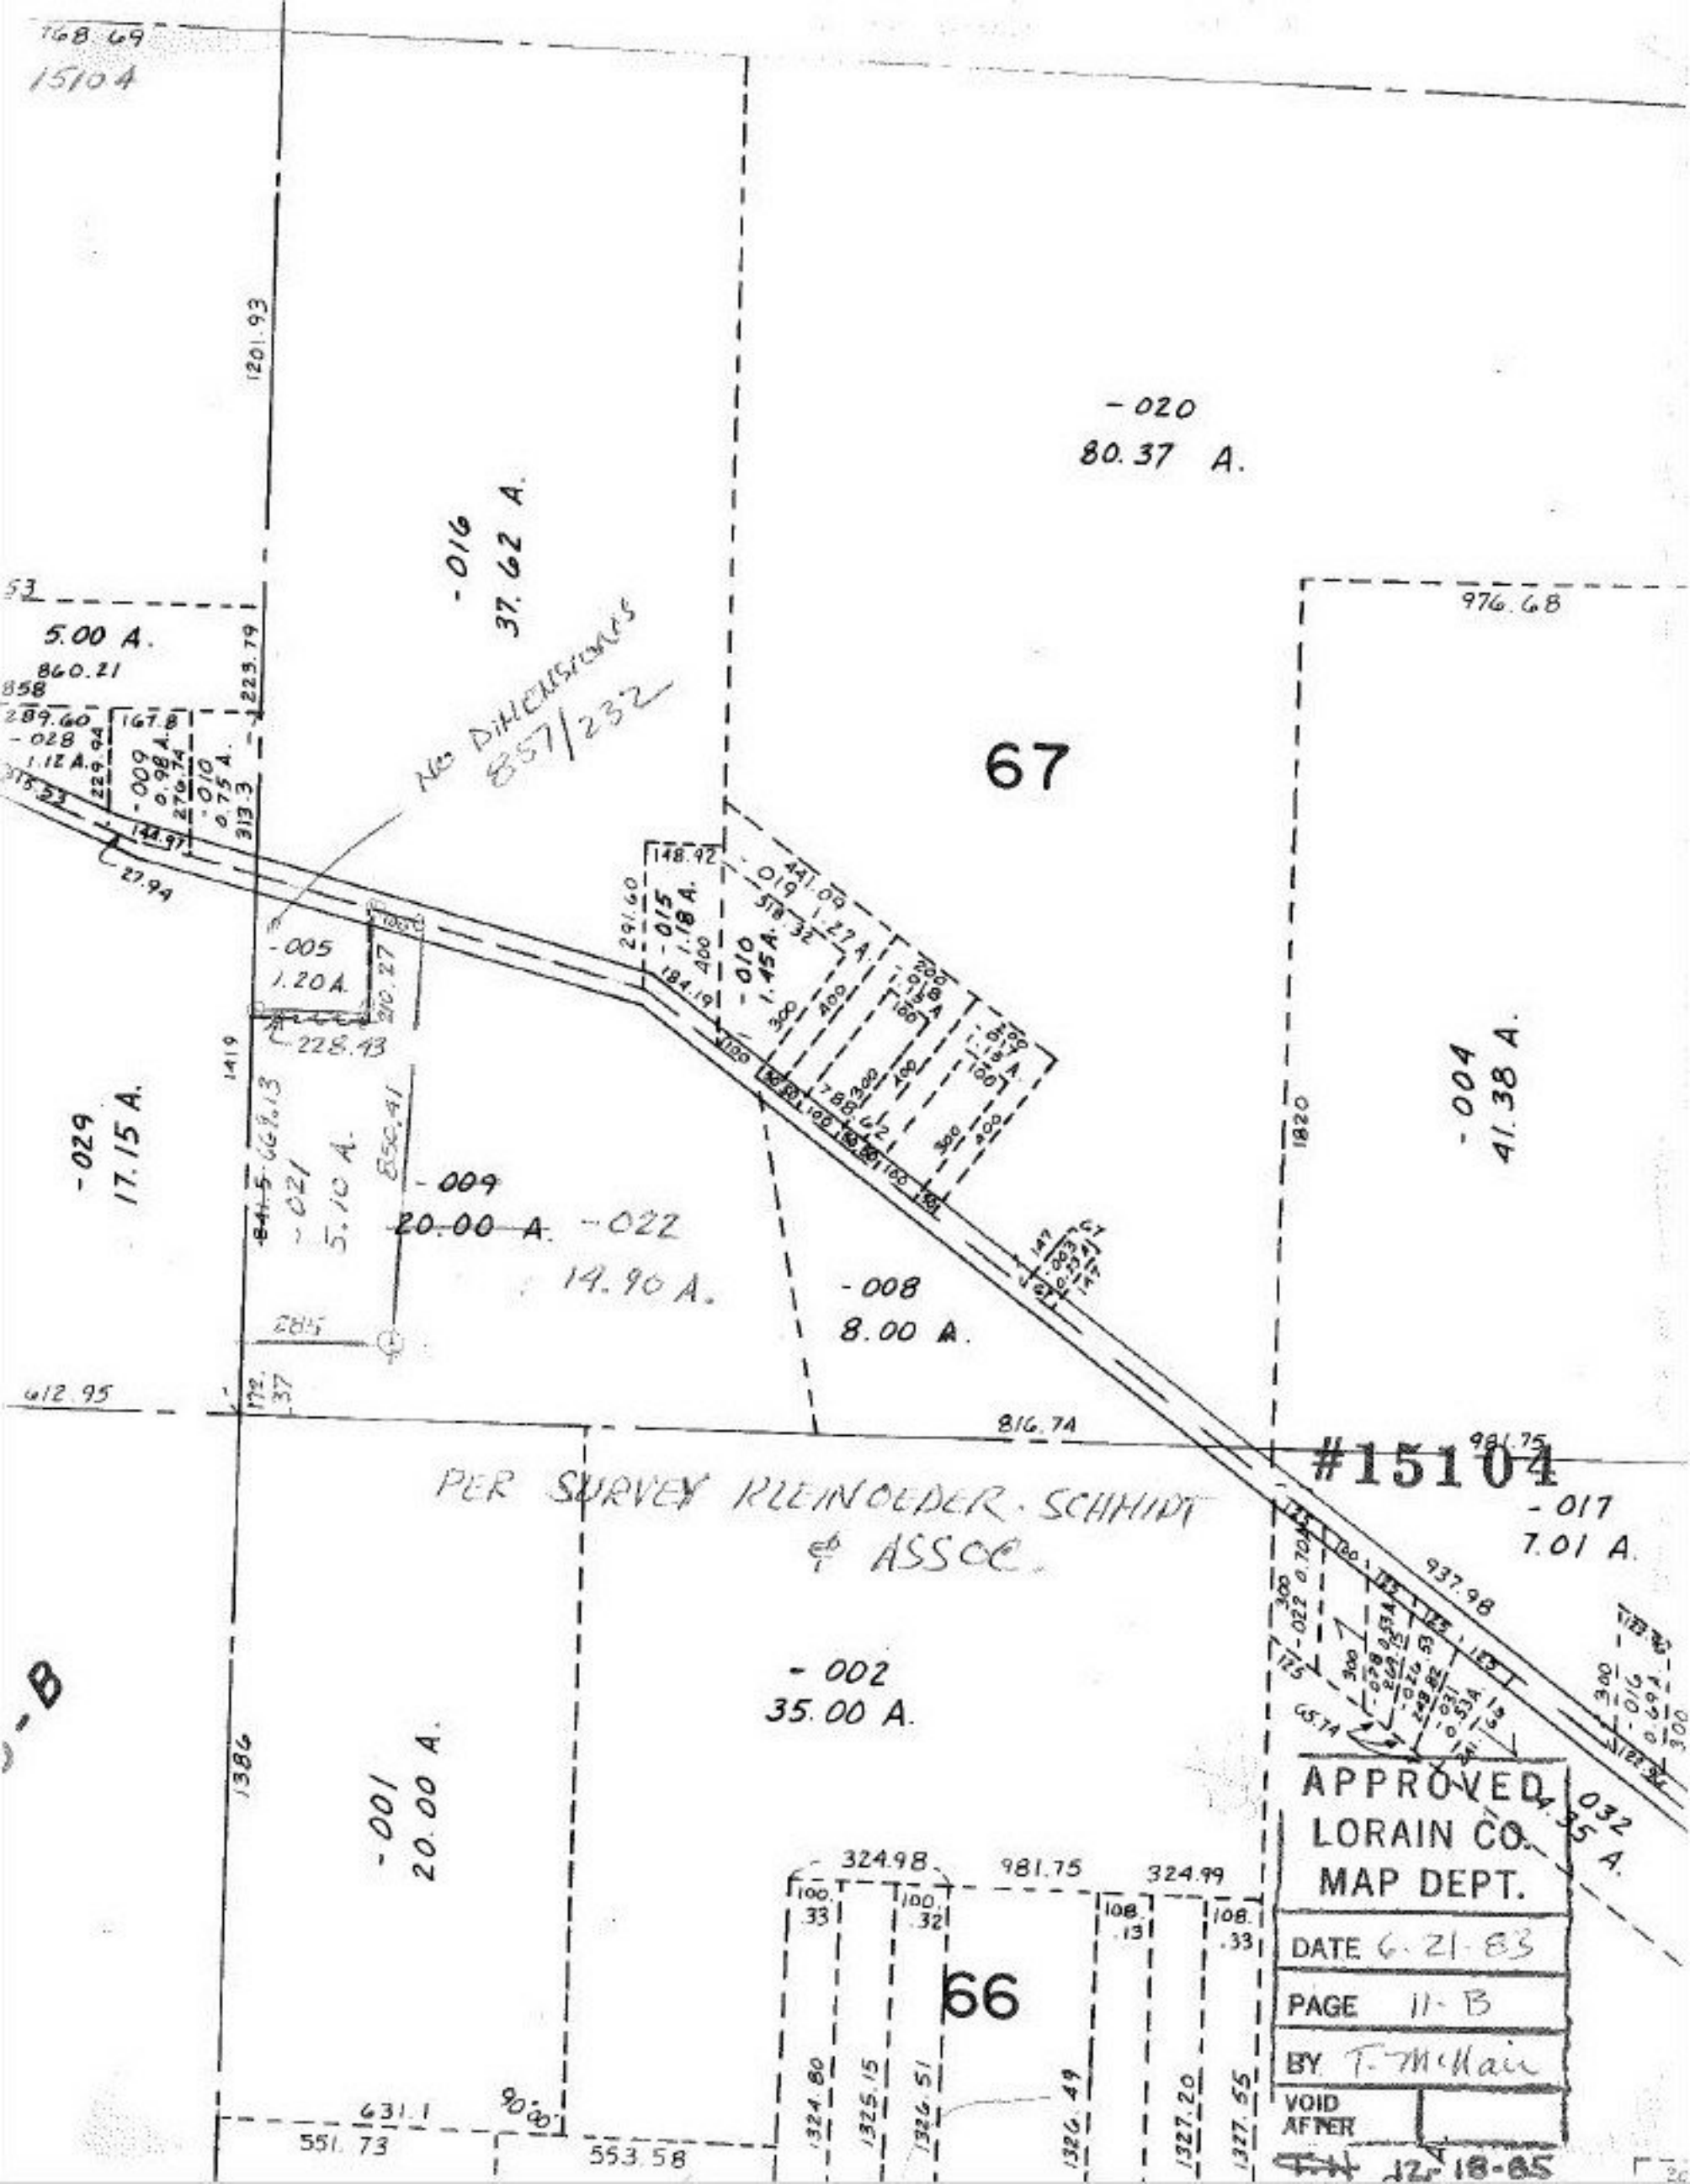

168.69
1510 A
1201.93
-020
80.37 A.
-016
37.62 A.
976.68
5.00 A.
860.21
858
289.60
-028
1.12 A.
167.8
-009
0.98 A.
-010
0.75 A.
313.3
223.79
NO DIMENSIONS
857/232
67
148.92
-015
1.18 A.
-010
1.45 A.
441.09
-019
1.27 A.
291.60
184.19
-005
1.20 A.
210.27
228.43
1419
-029
17.15 A.
-021
5.10 A.
850.41
-009
20.00 A.
-022
14.90 A.
-008
8.00 A.
-004
41.38 A.
1820
285
612.95
816.74
981.75
#15104
PER SURVEY KLEINOEDER-SCHMIDT & ASSOC.
-017
7.01 A.
937.98
-002
35.00 A.
-001
20.00 A.
1386
-B
032
4.35 A.
324.98
981.75
324.99
100.33
100.32
108.13
108.33
66
1324.80
1325.15
1326.51
1326.49
1327.20
1327.55
631.1
551.73
90°00'
553.58
APPROVED
LORAIN CO.
MAP DEPT.
DATE 6-21-83
PAGE 11-B
BY T. McNair
VOID AFTER
12-18-85