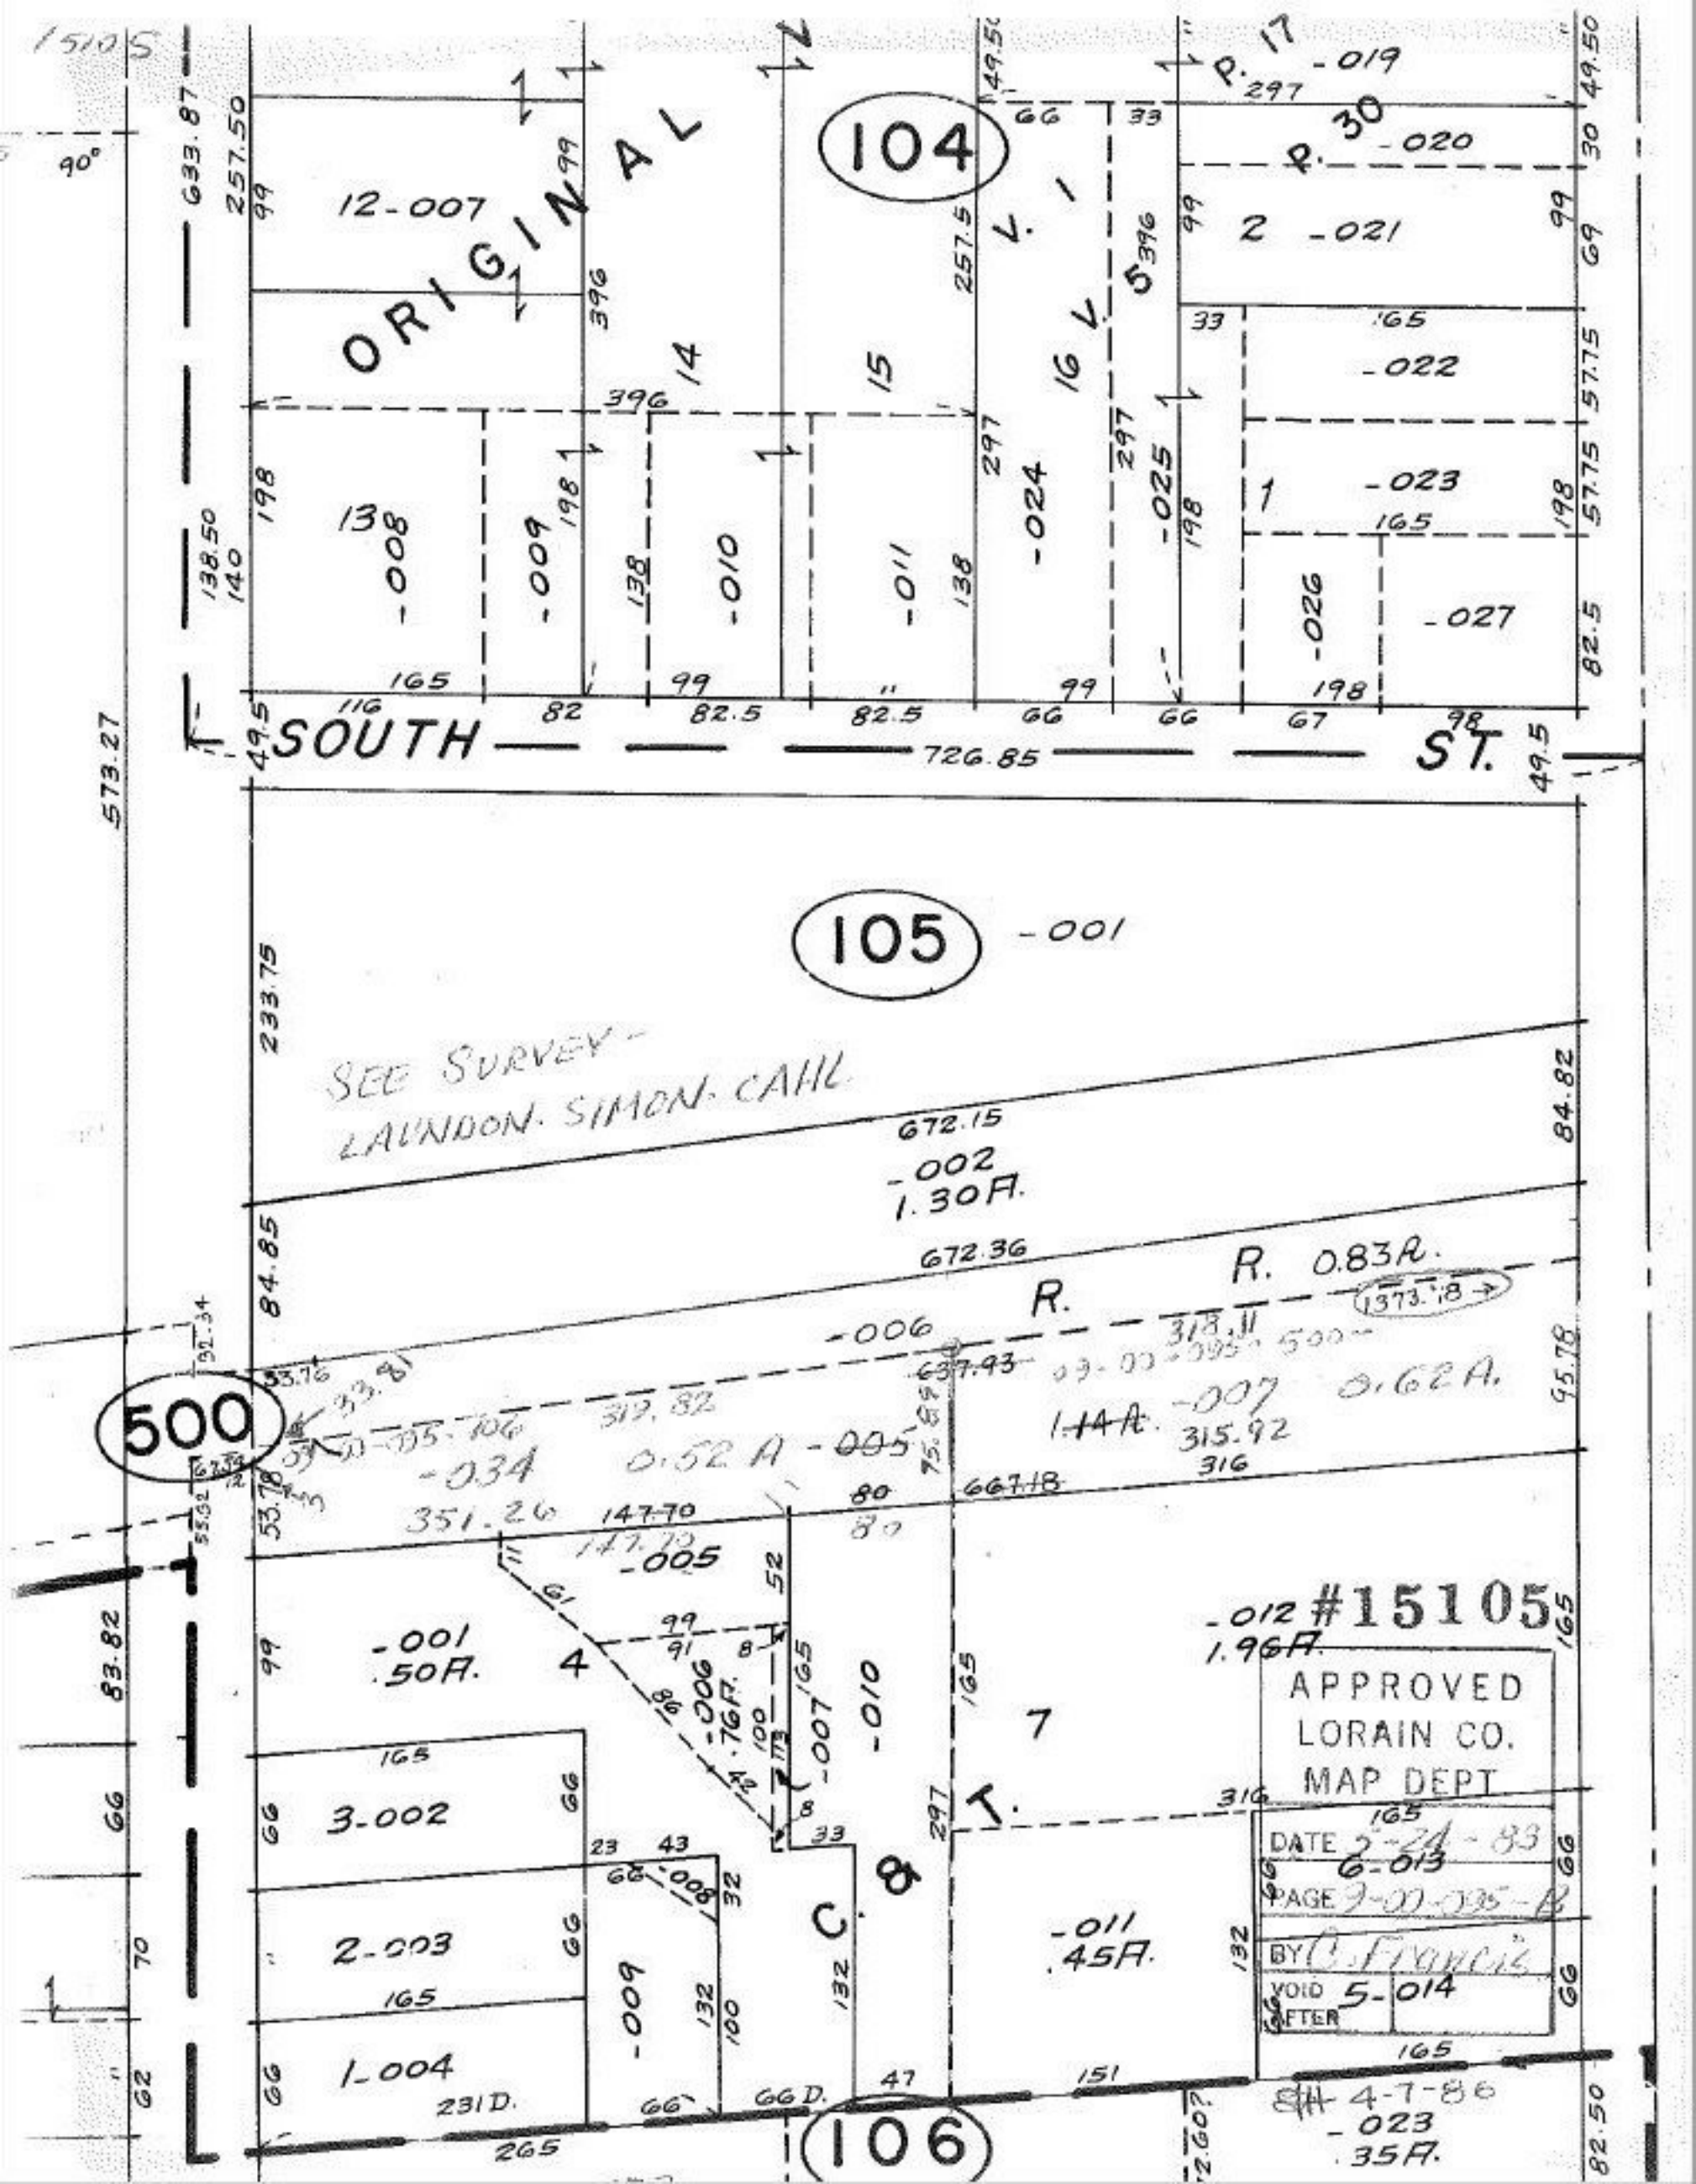

104
ORIGINAL
V. 1
V. 5
P. 17
P. 30
12-007
13
-008
-009
14
-010
15
-011
16
-024
-025
2
-021
-019
-020
-022
1
-023
-026
-027
SOUTH
ST.
726.85
105
-001
SEE SURVEY -
LAUNDON. SIMON. CAHL
672.15
-002
1.30A.
672.36
R.
R. 0.83A.
-006
500
-034
0.52 A
-005
1.14A.
-007
0.62A.
315.92
-005
-001
.50A.
4
-006
.76A.
-007
-010
7
-012
1.96A.
#15105
APPROVED
LORAIN CO.
MAP DEPT
DATE 5-24-83
6-013
PAGE 9-00-095-B
BY C. Francis
VOID AFTER 5-014
3-002
2-003
1-004
-009
-008
C. & T.
-011
.45A.
231D.
66D.
106
4-7-86
-023
.35A.