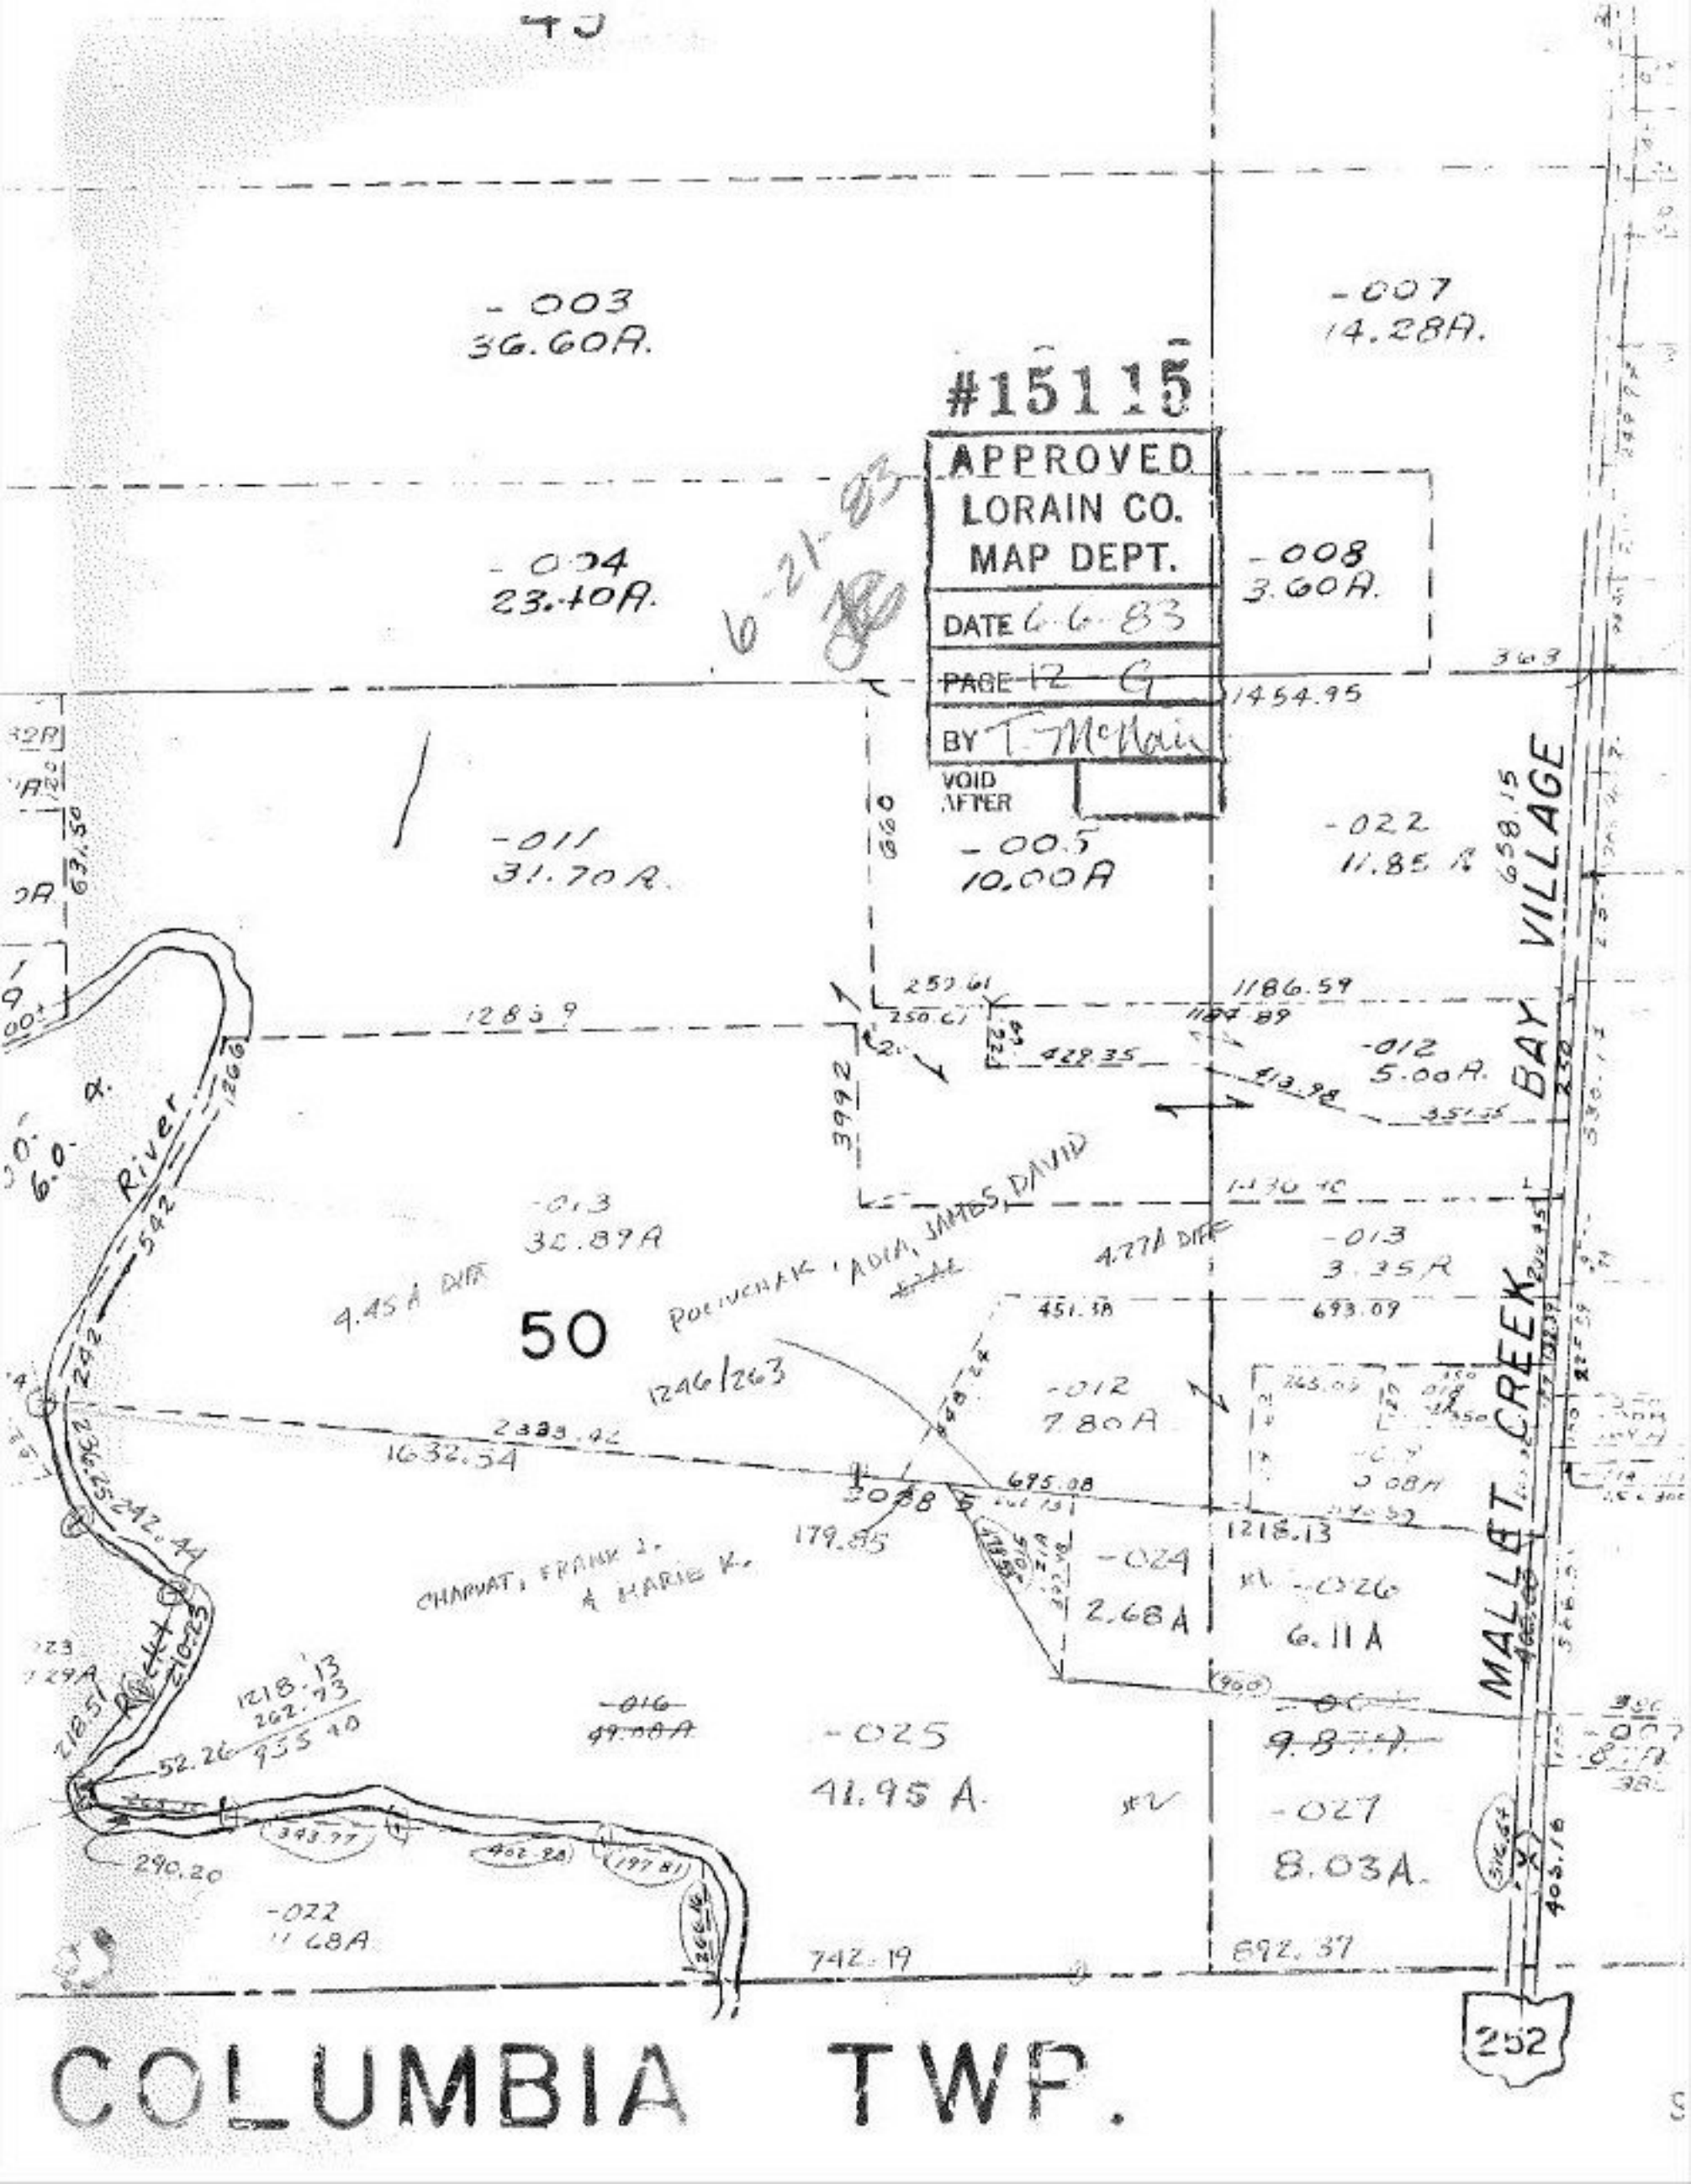

#15115
APPROVED
LORAIN CO.
MAP DEPT.
DATE 6-6-83
PAGE 12 G
BY T. McNair
VOID AFTER
6-21-83
-003
36.60A.
-007
14.28A.
-004
23.40A.
-008
3.60A.
-011
31.70A.
-005
10.00A
-022
11.85 A
-012
5.00A.
-013
32.89A
-013
3.35A
-012
7.80A
-024
2.68A
-026
6.11A
-025
41.95 A.
-027
8.03A.
-022
11.68A
50
POCIUCHAK, ADIA, JAMES, DAVID
CHARVAT, FRANK J. & MARIE K.
MALLET CREEK
BAY VILLAGE
River
252
COLUMBIA TWP.