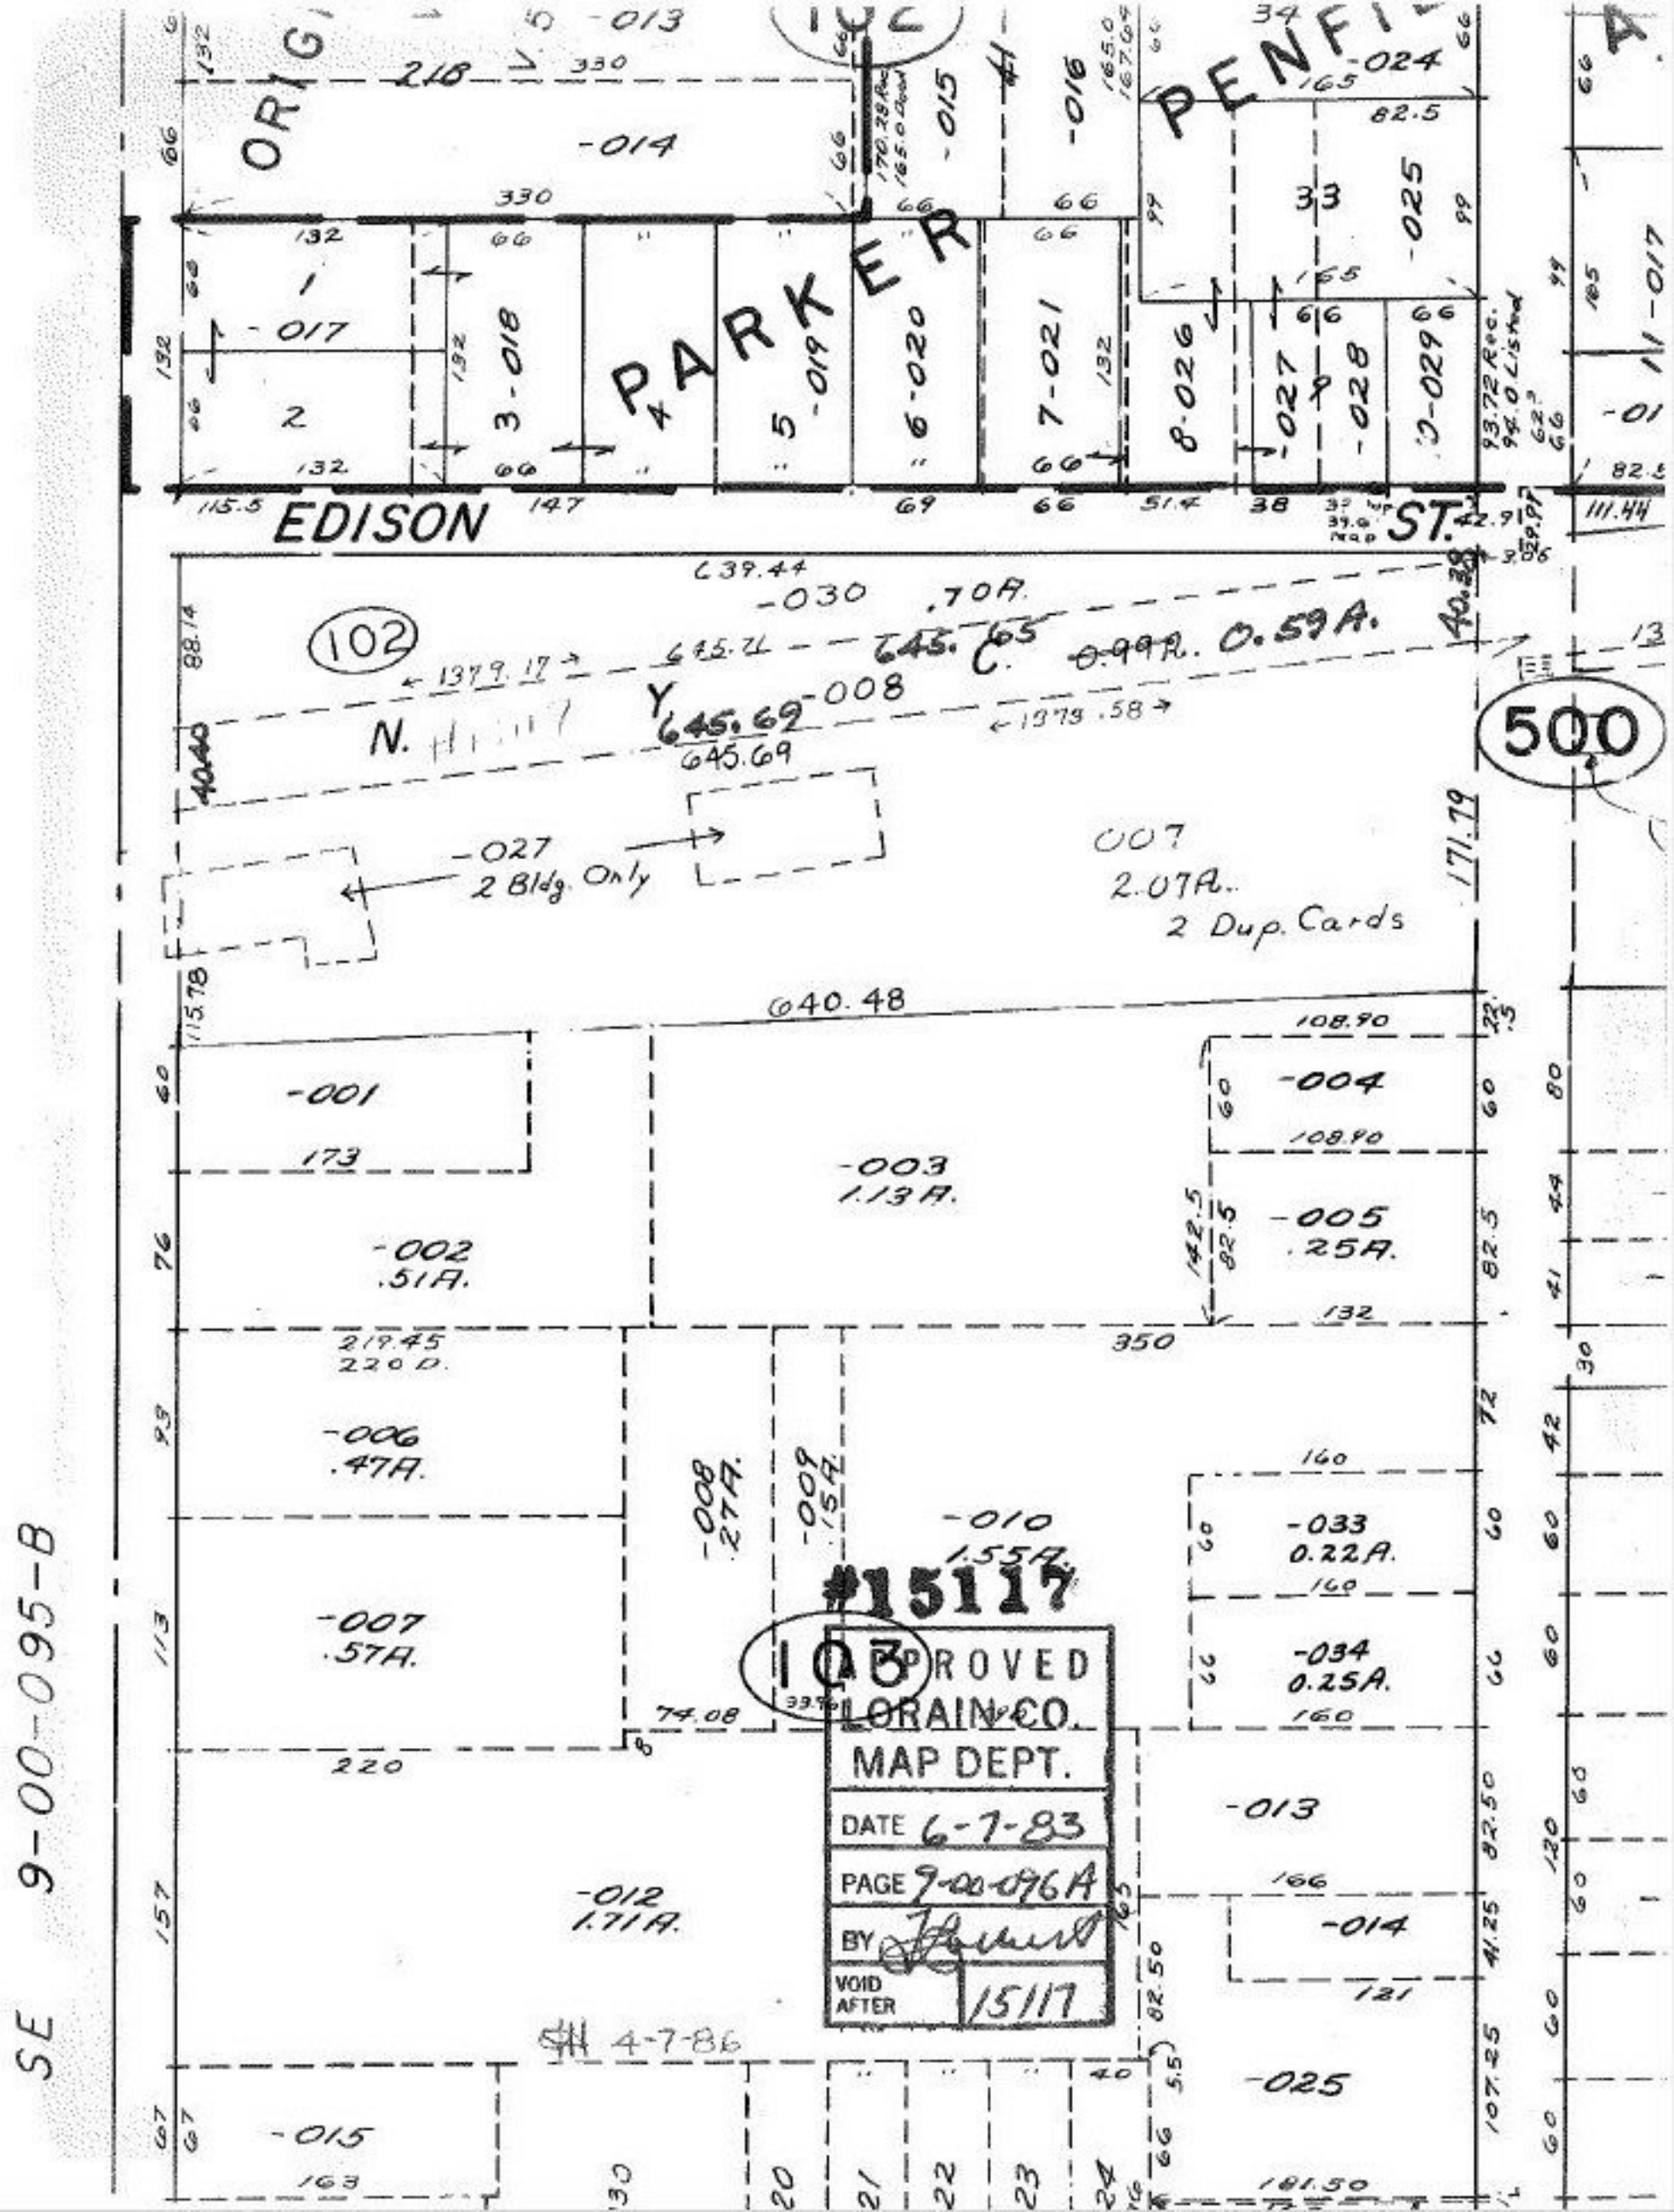

ORIG
PENFIE
PARKER
EDISON
ST.
102
500
N.
Y
C.
-013
-014
-015
-016
-017
-018
-019
-020
-021
-024
-025
-027
-028
-029
-030
-008
-027
2 Bldg. Only
007
2.07A.
2 Dup. Cards
640.48
-001
-002
.51A.
-003
1.13A.
-004
-005
.25A.
-006
.47A.
-007
.57A.
-008
.27A.
-009
.15A.
-010
1.55A.
-033
0.22A.
-034
0.25A.
-012
1.71A.
-013
-014
-015
-025
#15117
103
APPROVED
LORAIN CO.
MAP DEPT.
DATE 6-7-83
PAGE 9-00-096A
BY
VOID AFTER 15117
4-7-86
SE 9-00-095-B