

BRACE TRACT PT. LOT 16
WEST OF RIVER
PT. LOTS 30 & 31

CLYRIA
SCALE: 1" = 100'


SEE 6-64

#1512
APPROVED
LORAIN CO.
MAP DEPT.
DATE 1-30-68
6-46
BY D. Maynard

PT. ~~1512~~ 050
PT. 2 ~~5110A~~
231-15A-



-039
5.53A.

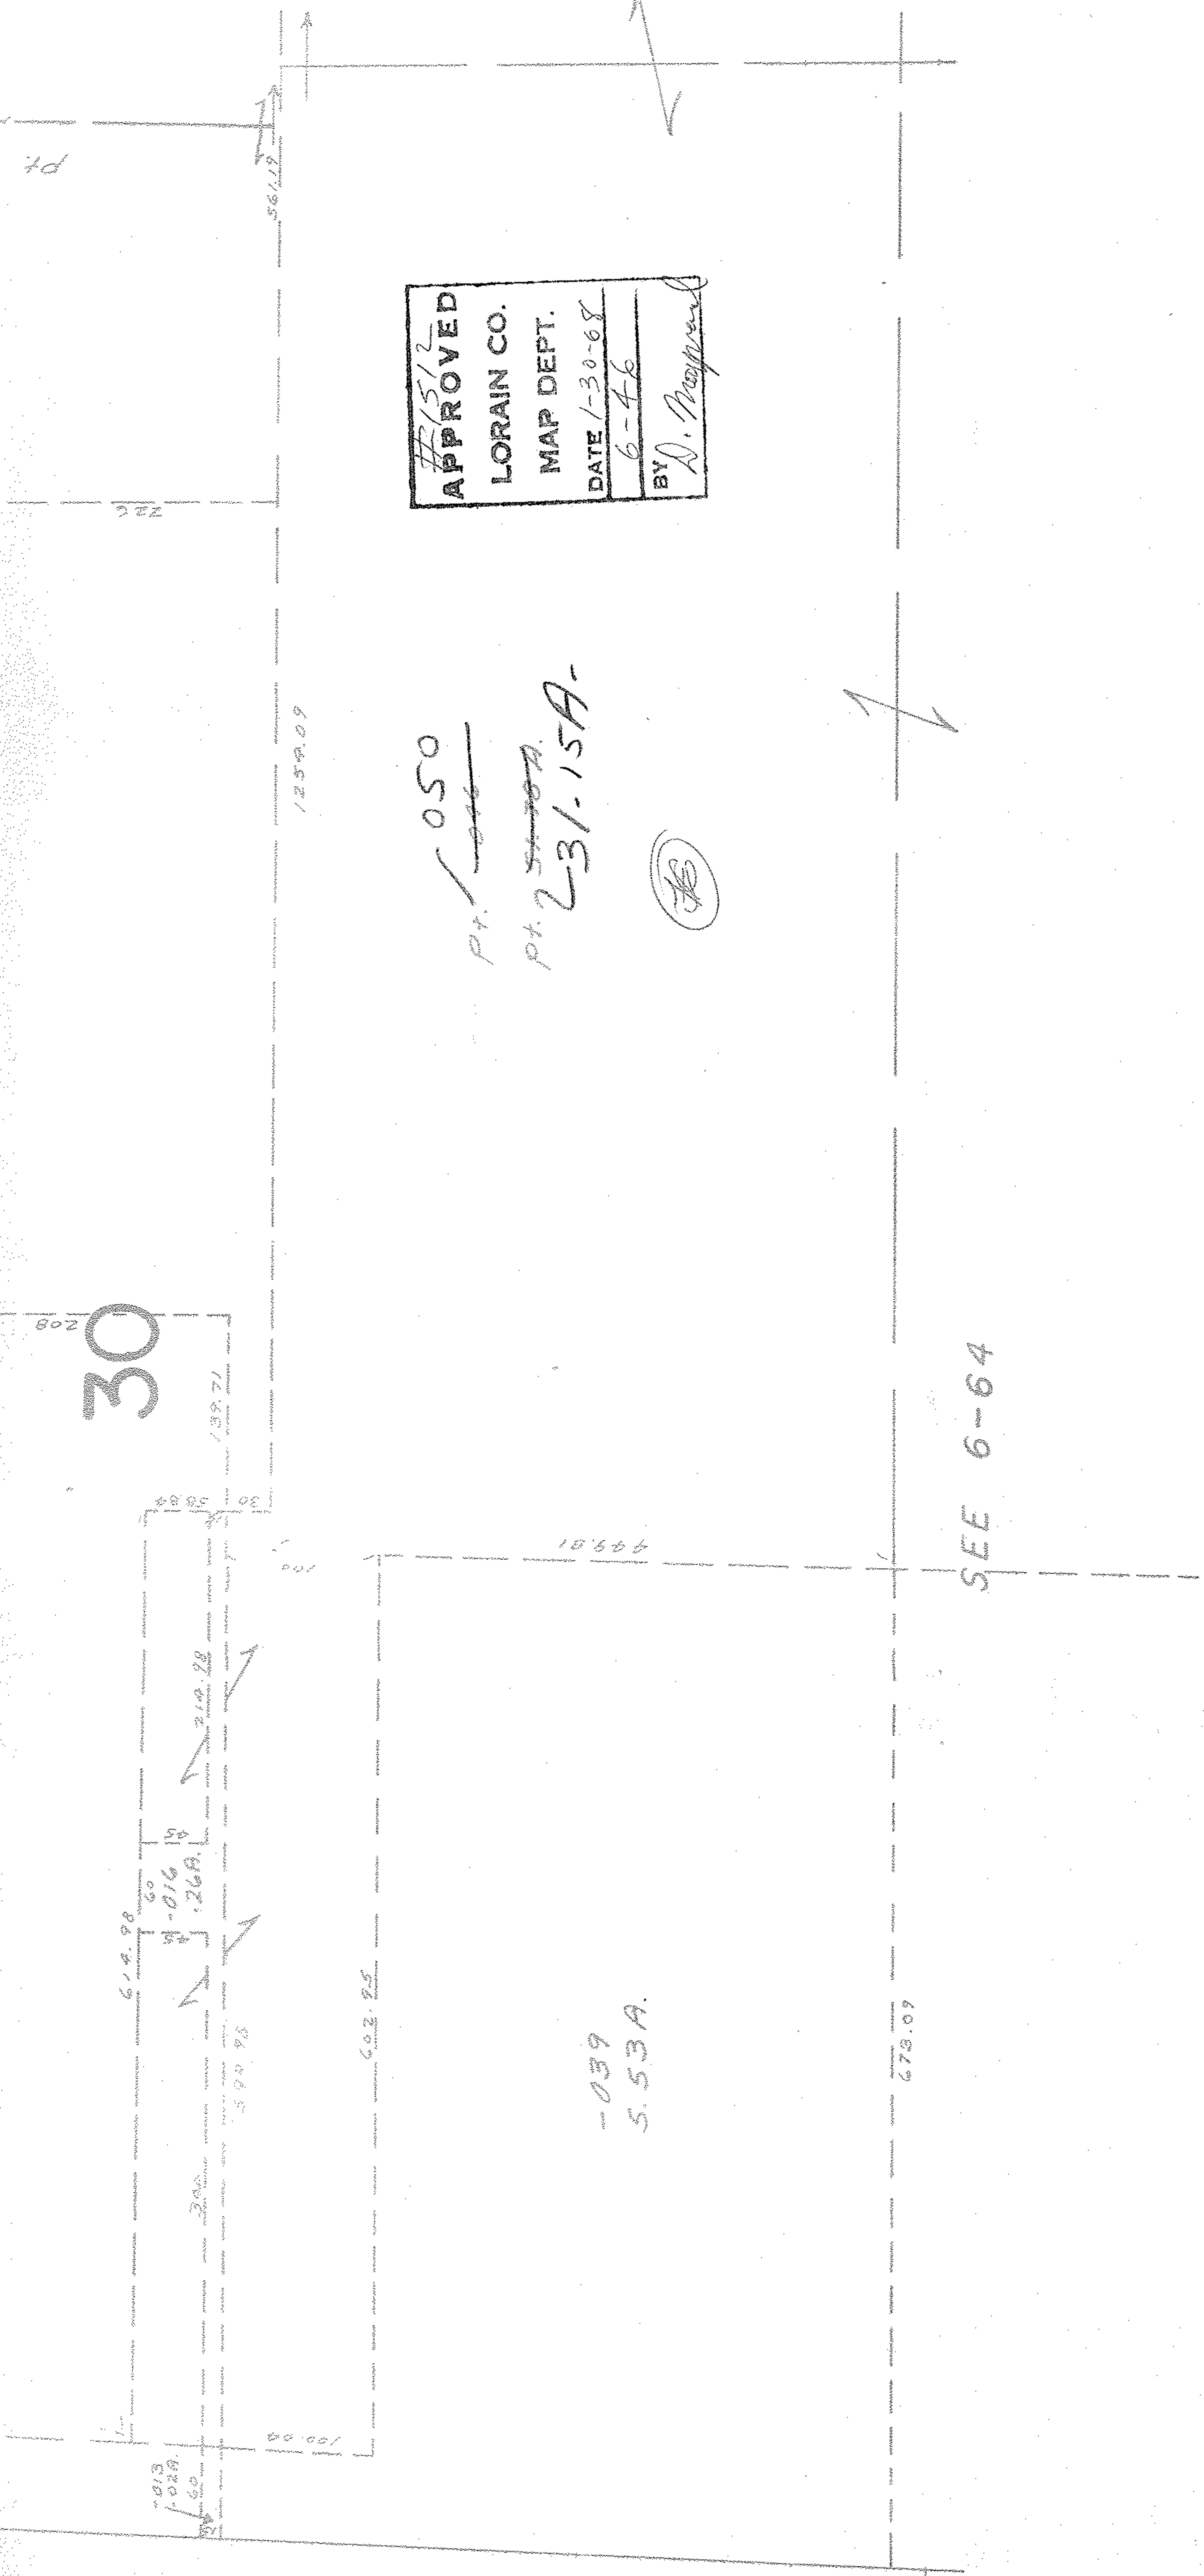

1013
1020
1030

619.98

91-016 18
268

219.28

138.71

1259.09

602.95

449.81

678.07

100.00

300

594.95

240.47

LORAIN
144.29

96.19