DICK, ALAN & REGINA M. 6.16.83

1321/ 849 - ~~[illegible]~~

S.B. No. 119-WD

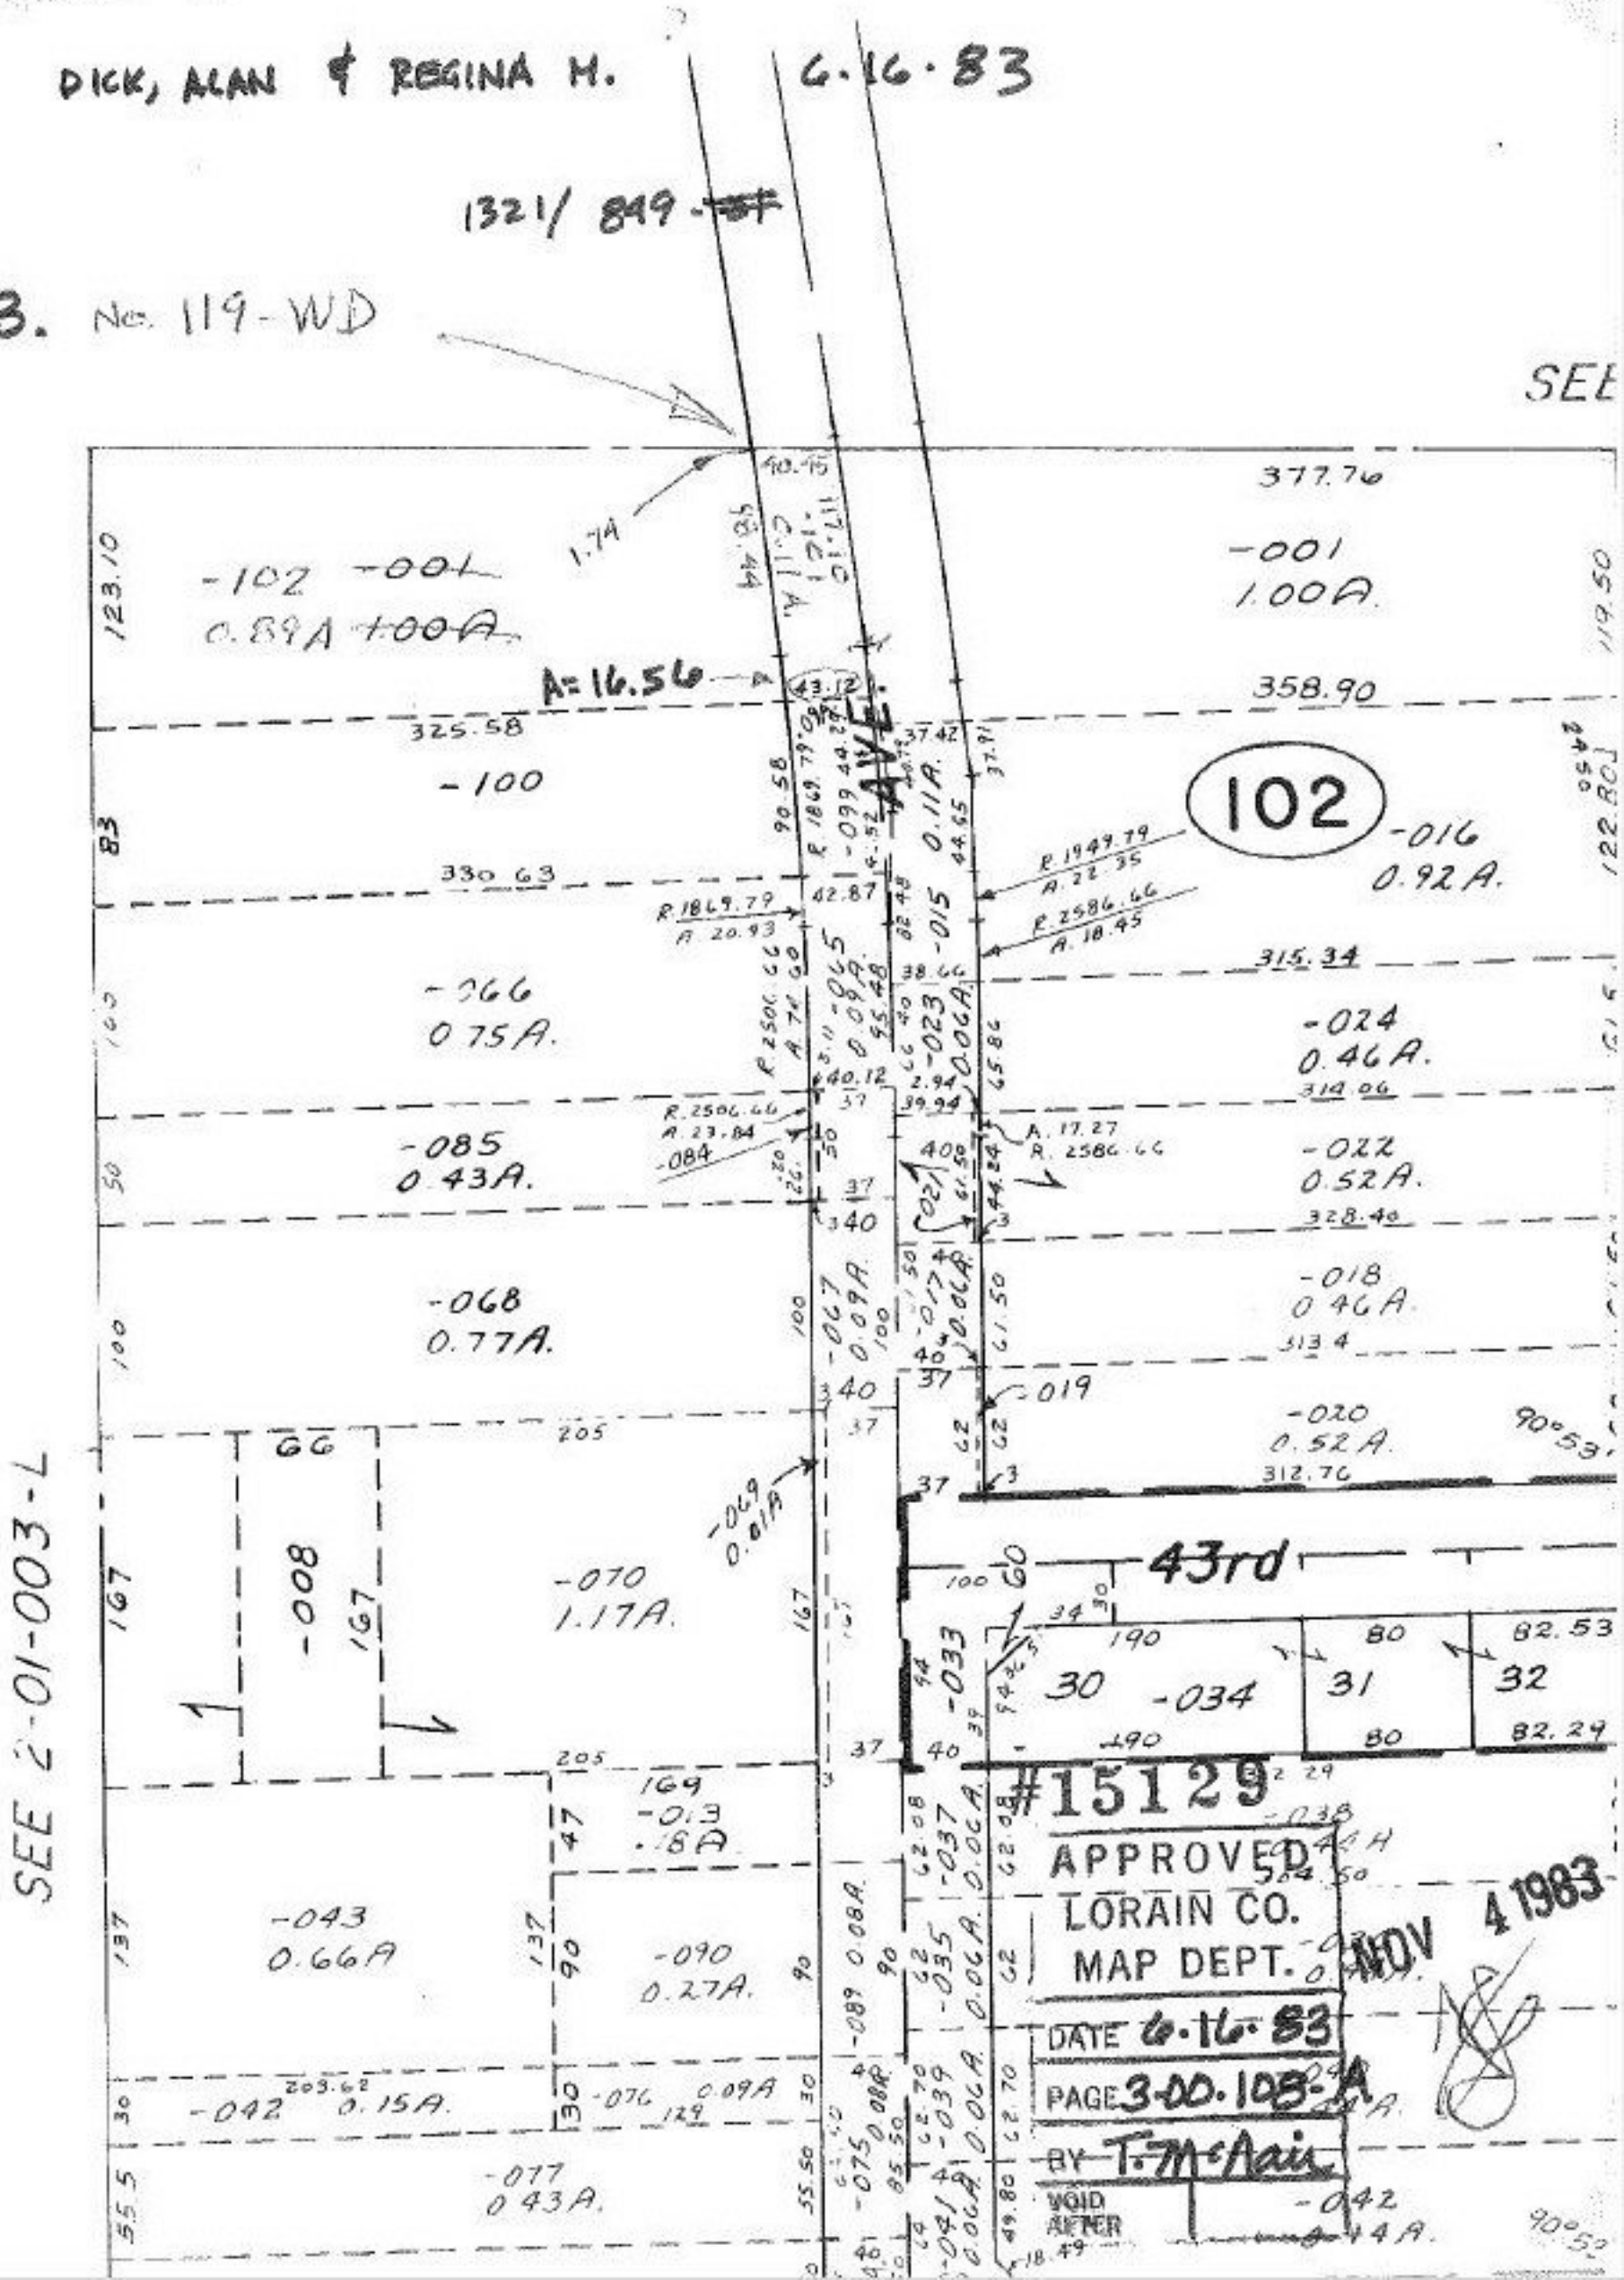

#15129

APPROVED
LORAIN CO.
MAP DEPT.
DATE 6.16.83
PAGE 3-00.108-A
BY T. McAair
VOID AFTER

NOV 4 1983