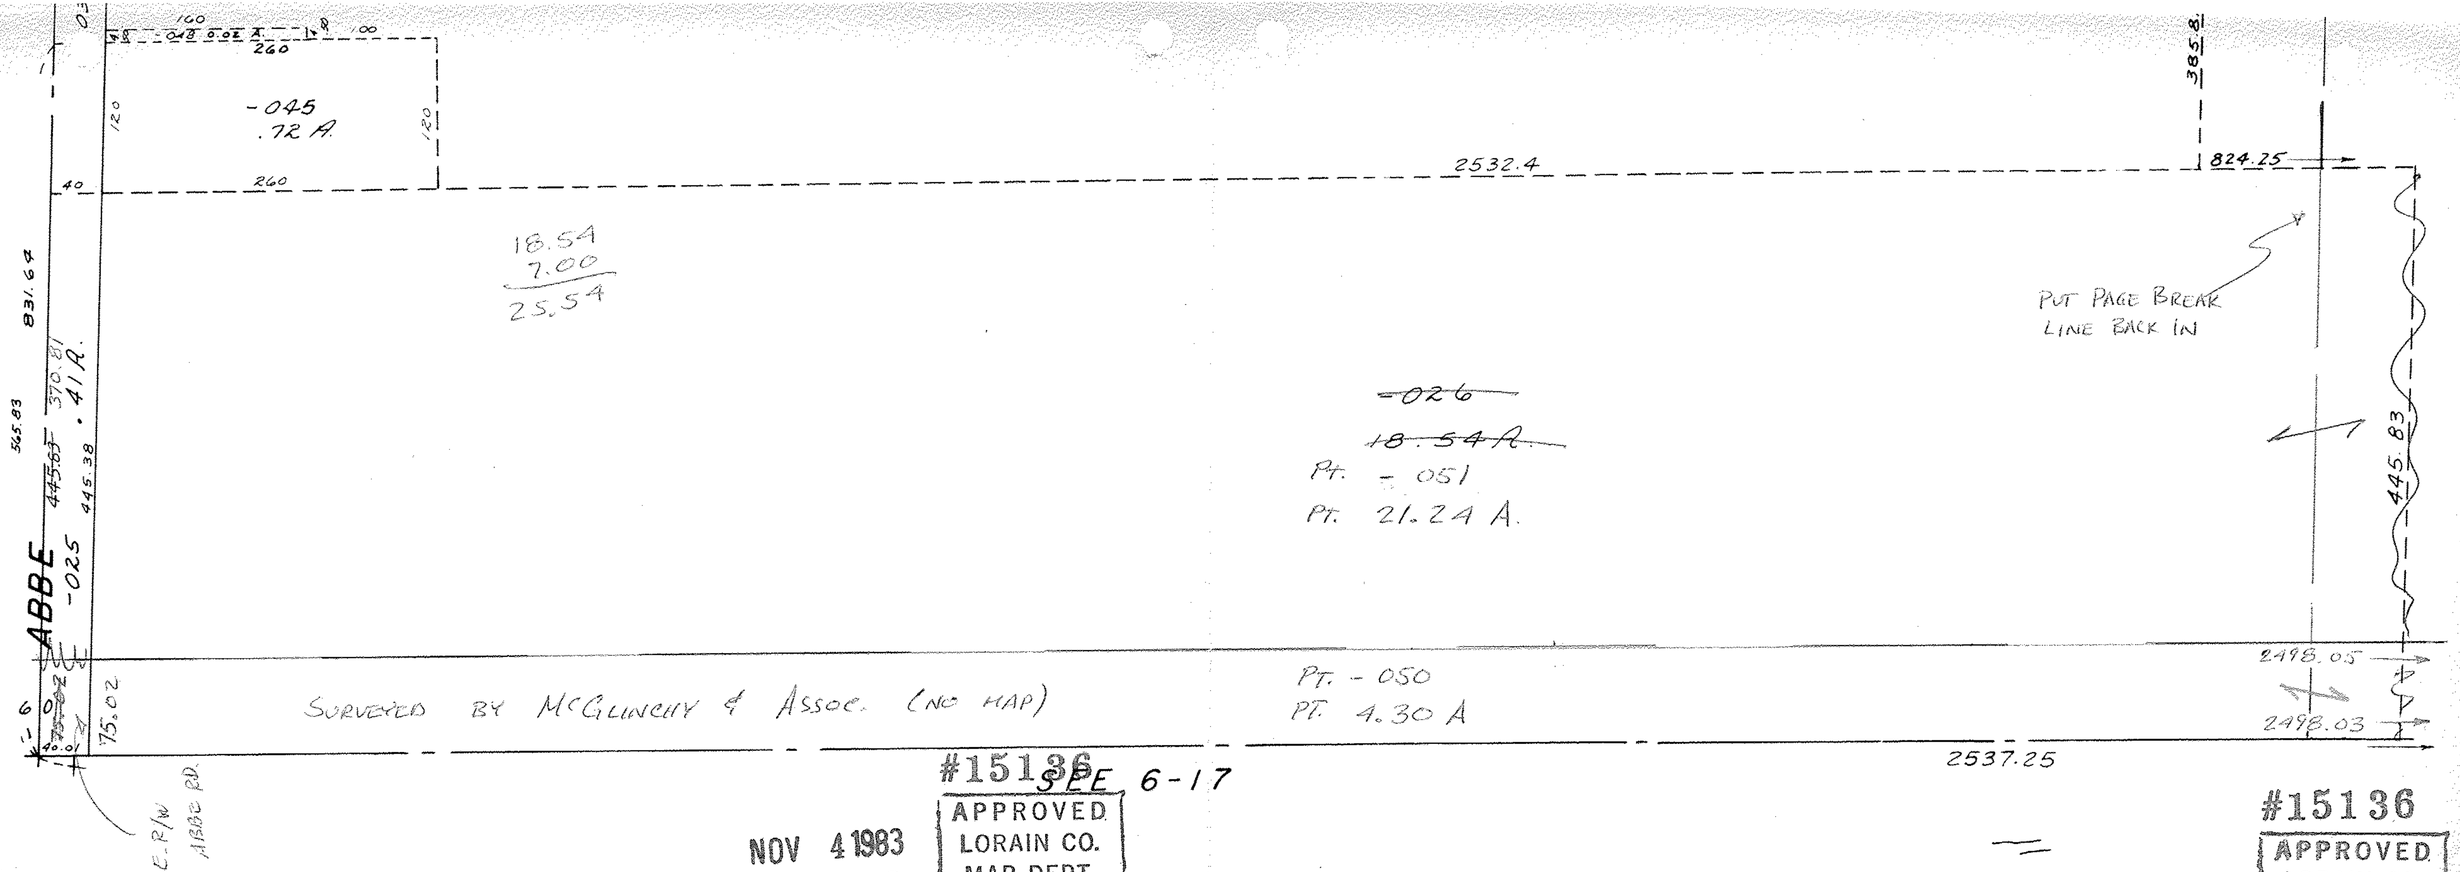

#15136 SEE 6-17

NOV 4 1983

APPROVED
LORAIN CO.
MAP DEPT.
DATE 6.20.83
PAGE 3.00-001-A
BY T. McMain
VOID AFTER

SHEFFIELD TWP.

W PT LOT 1

#15136

APPROVED
LORAIN CO.
MAP DEPT.
DATE 6.20.83
PAGE 3.00.001-A
BY T. McMain
VOID AFTER