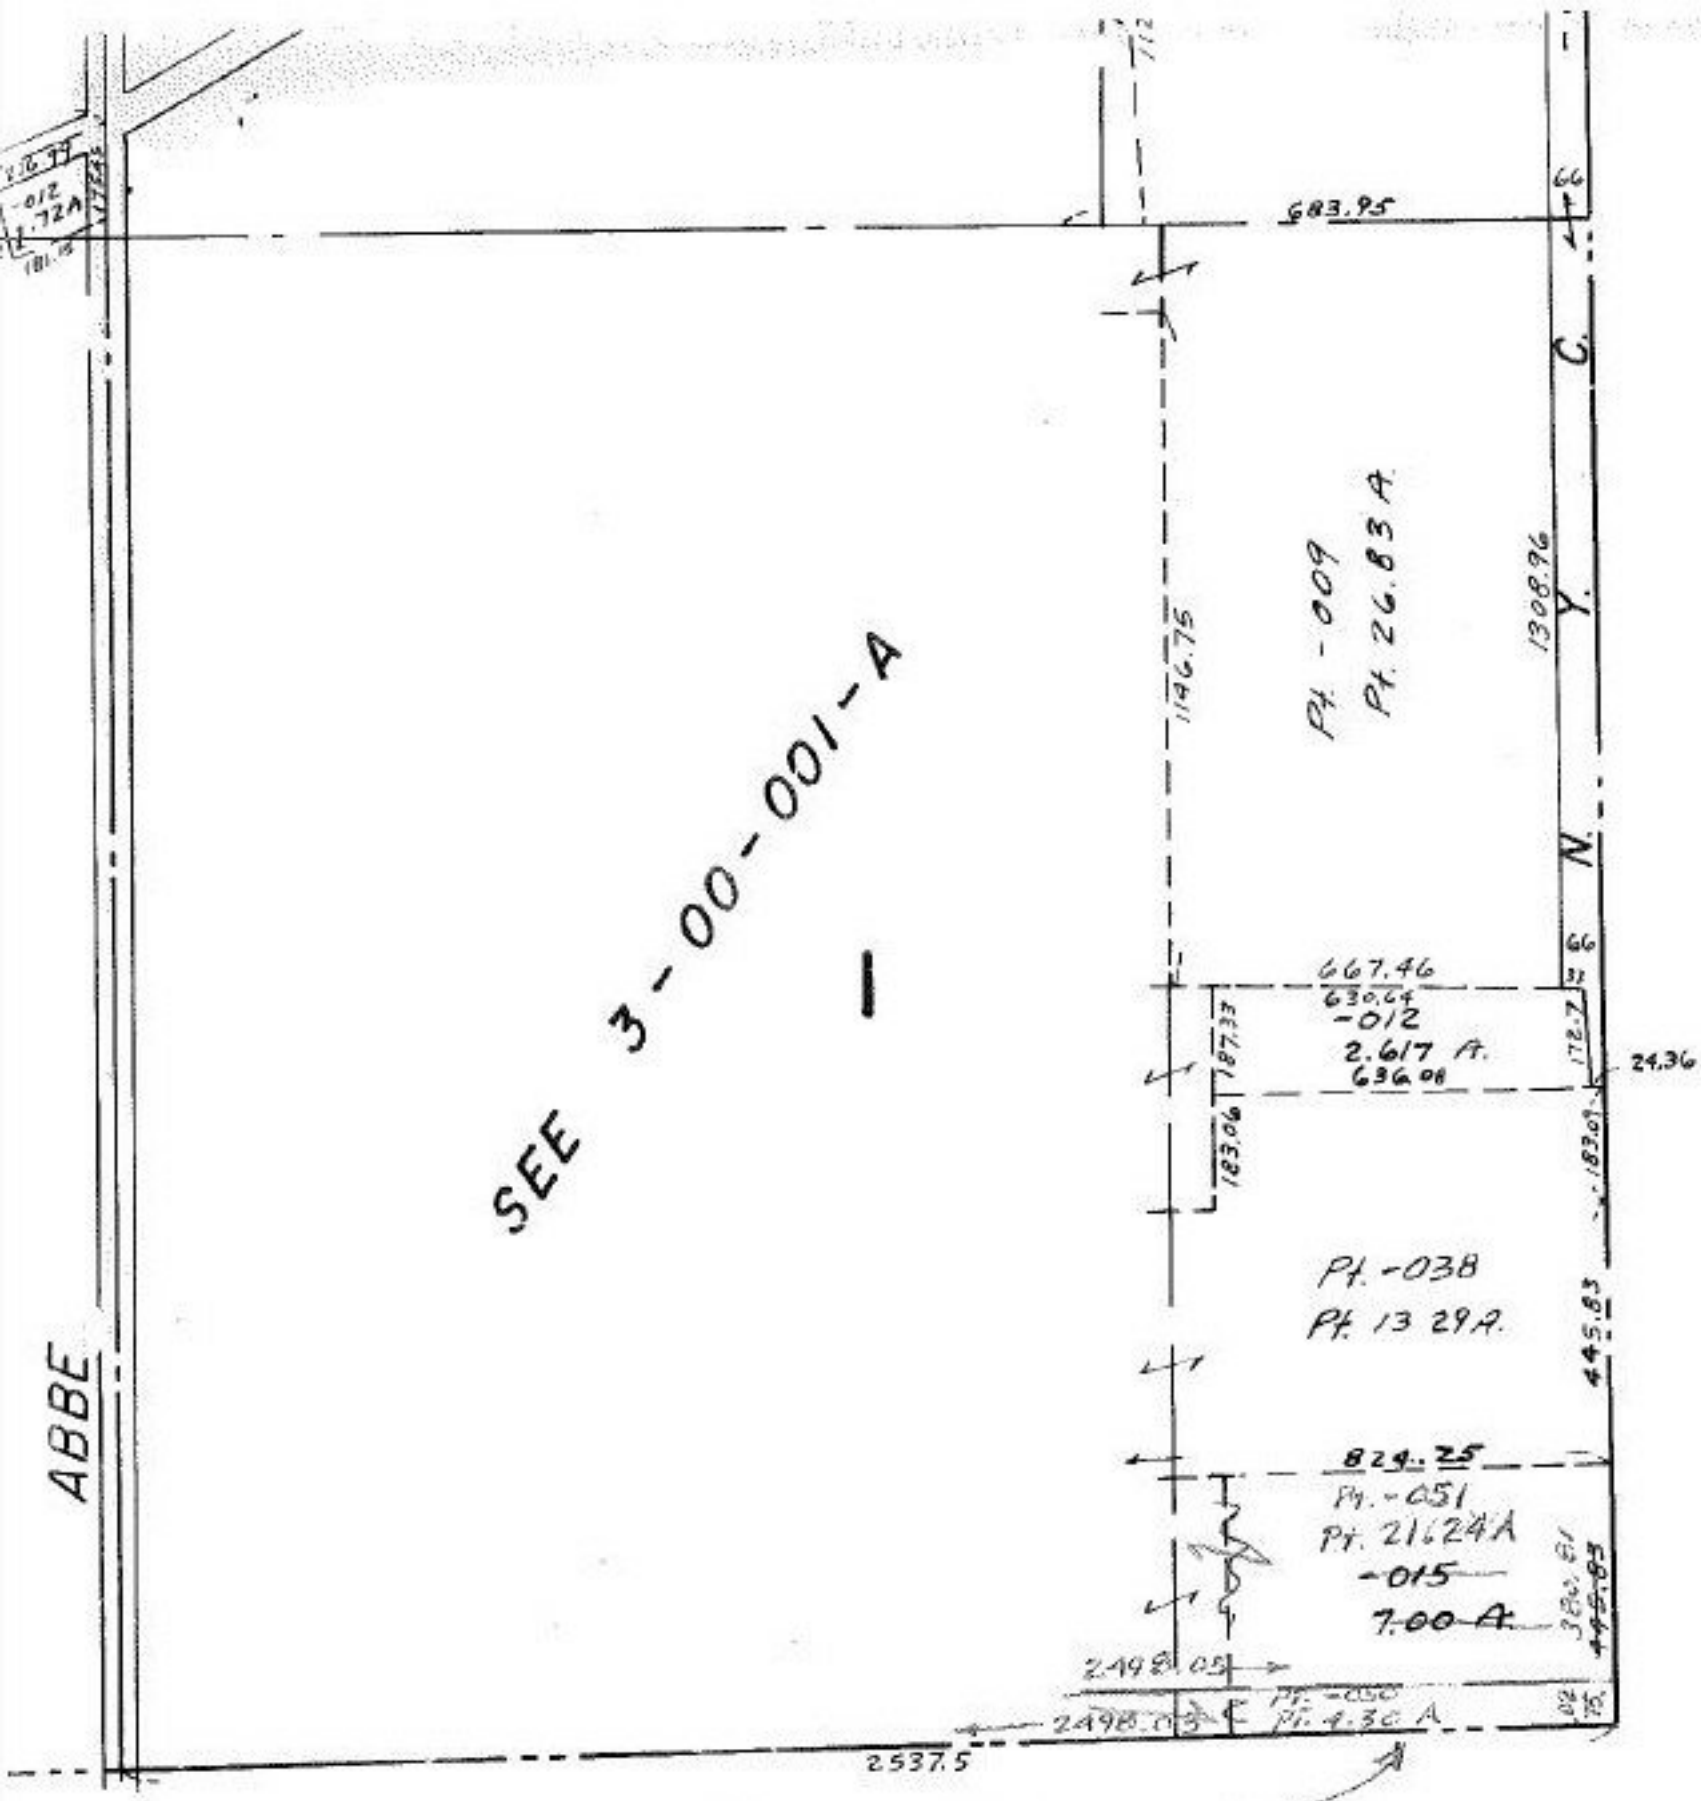

SURVEYED BY
McGUINCHY & ASSOC.
(NO MAP)

#15136

NOV 4 1983

APPROVED
LORAIN CO.
MAP DEPT.
DATE 6-20-83
PAGE 3-L
BY T.M'Nair
VOID
AFTER

LOTS 1 THRU 5
& 11 15