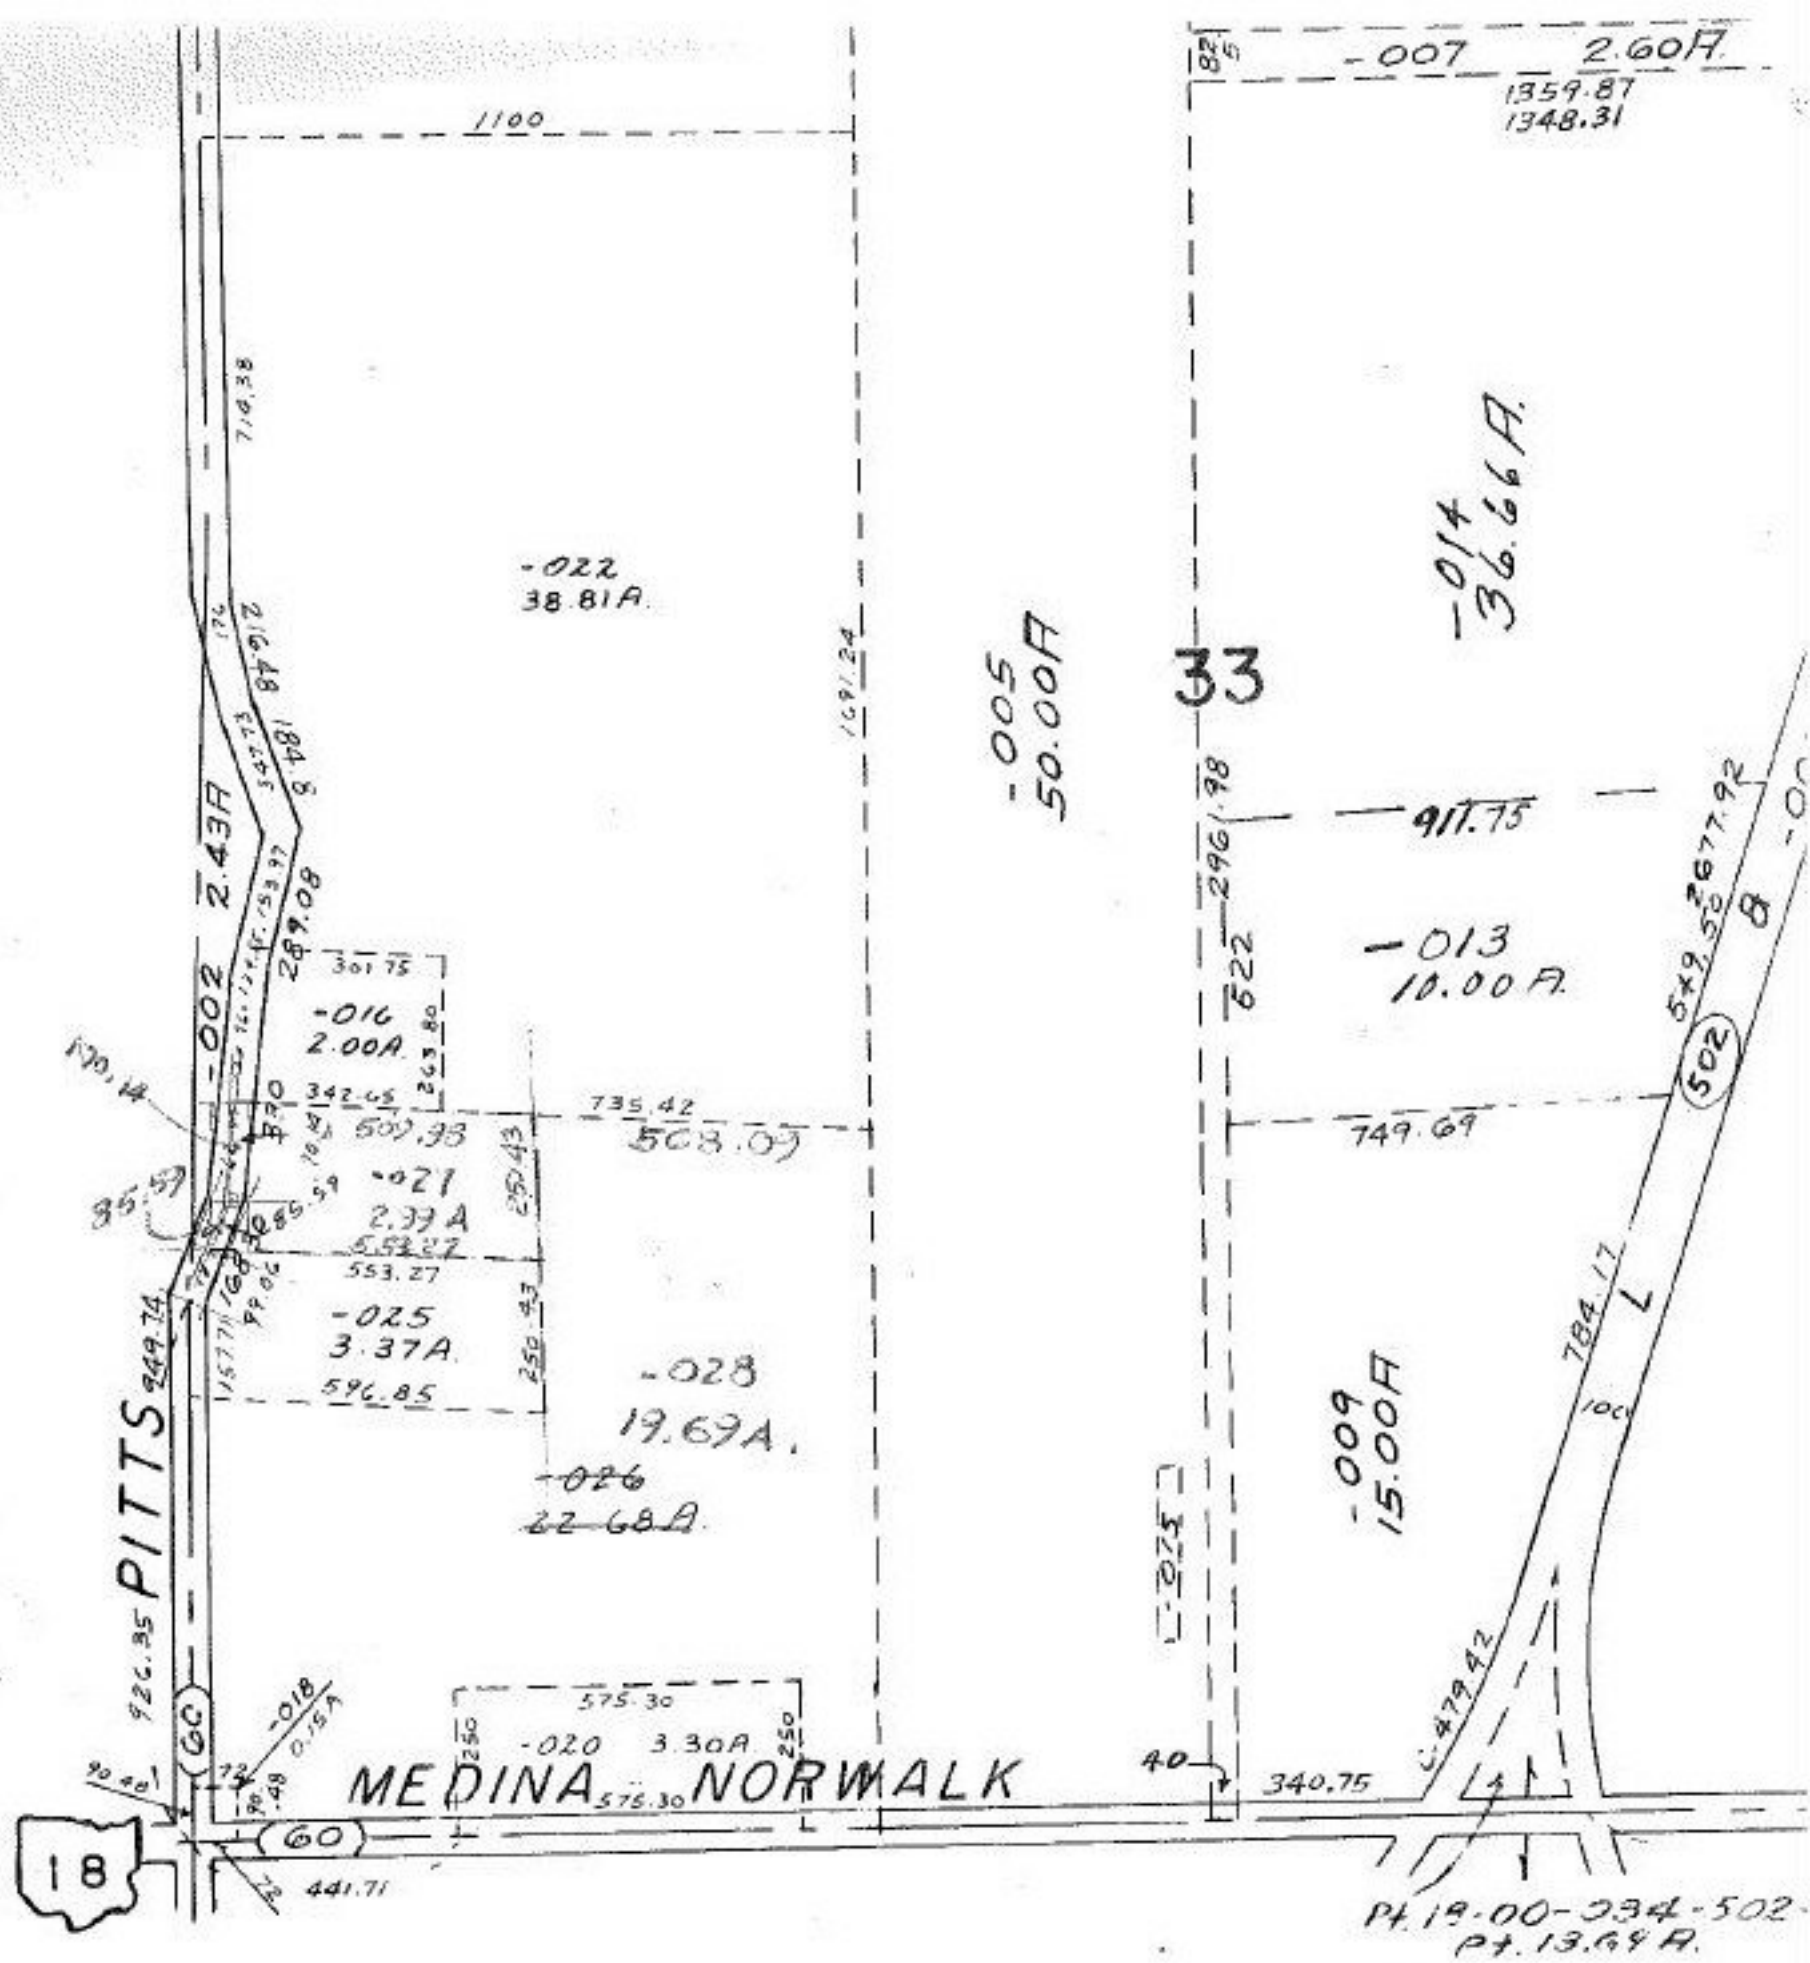

Surveyed by Laundoni, Simon, Cahl & Assoc, Inc.
C = 18 142, 357 & 1429

T. H.
7/5/84

#15147

APPROVED
LORAIN CO.
MAP DEPT.
DATE 6-29-83
PAGE 18-B
BY C.F.
VOID AFTER

WELLINGTON TWP.

SCALE: 1" = 400'