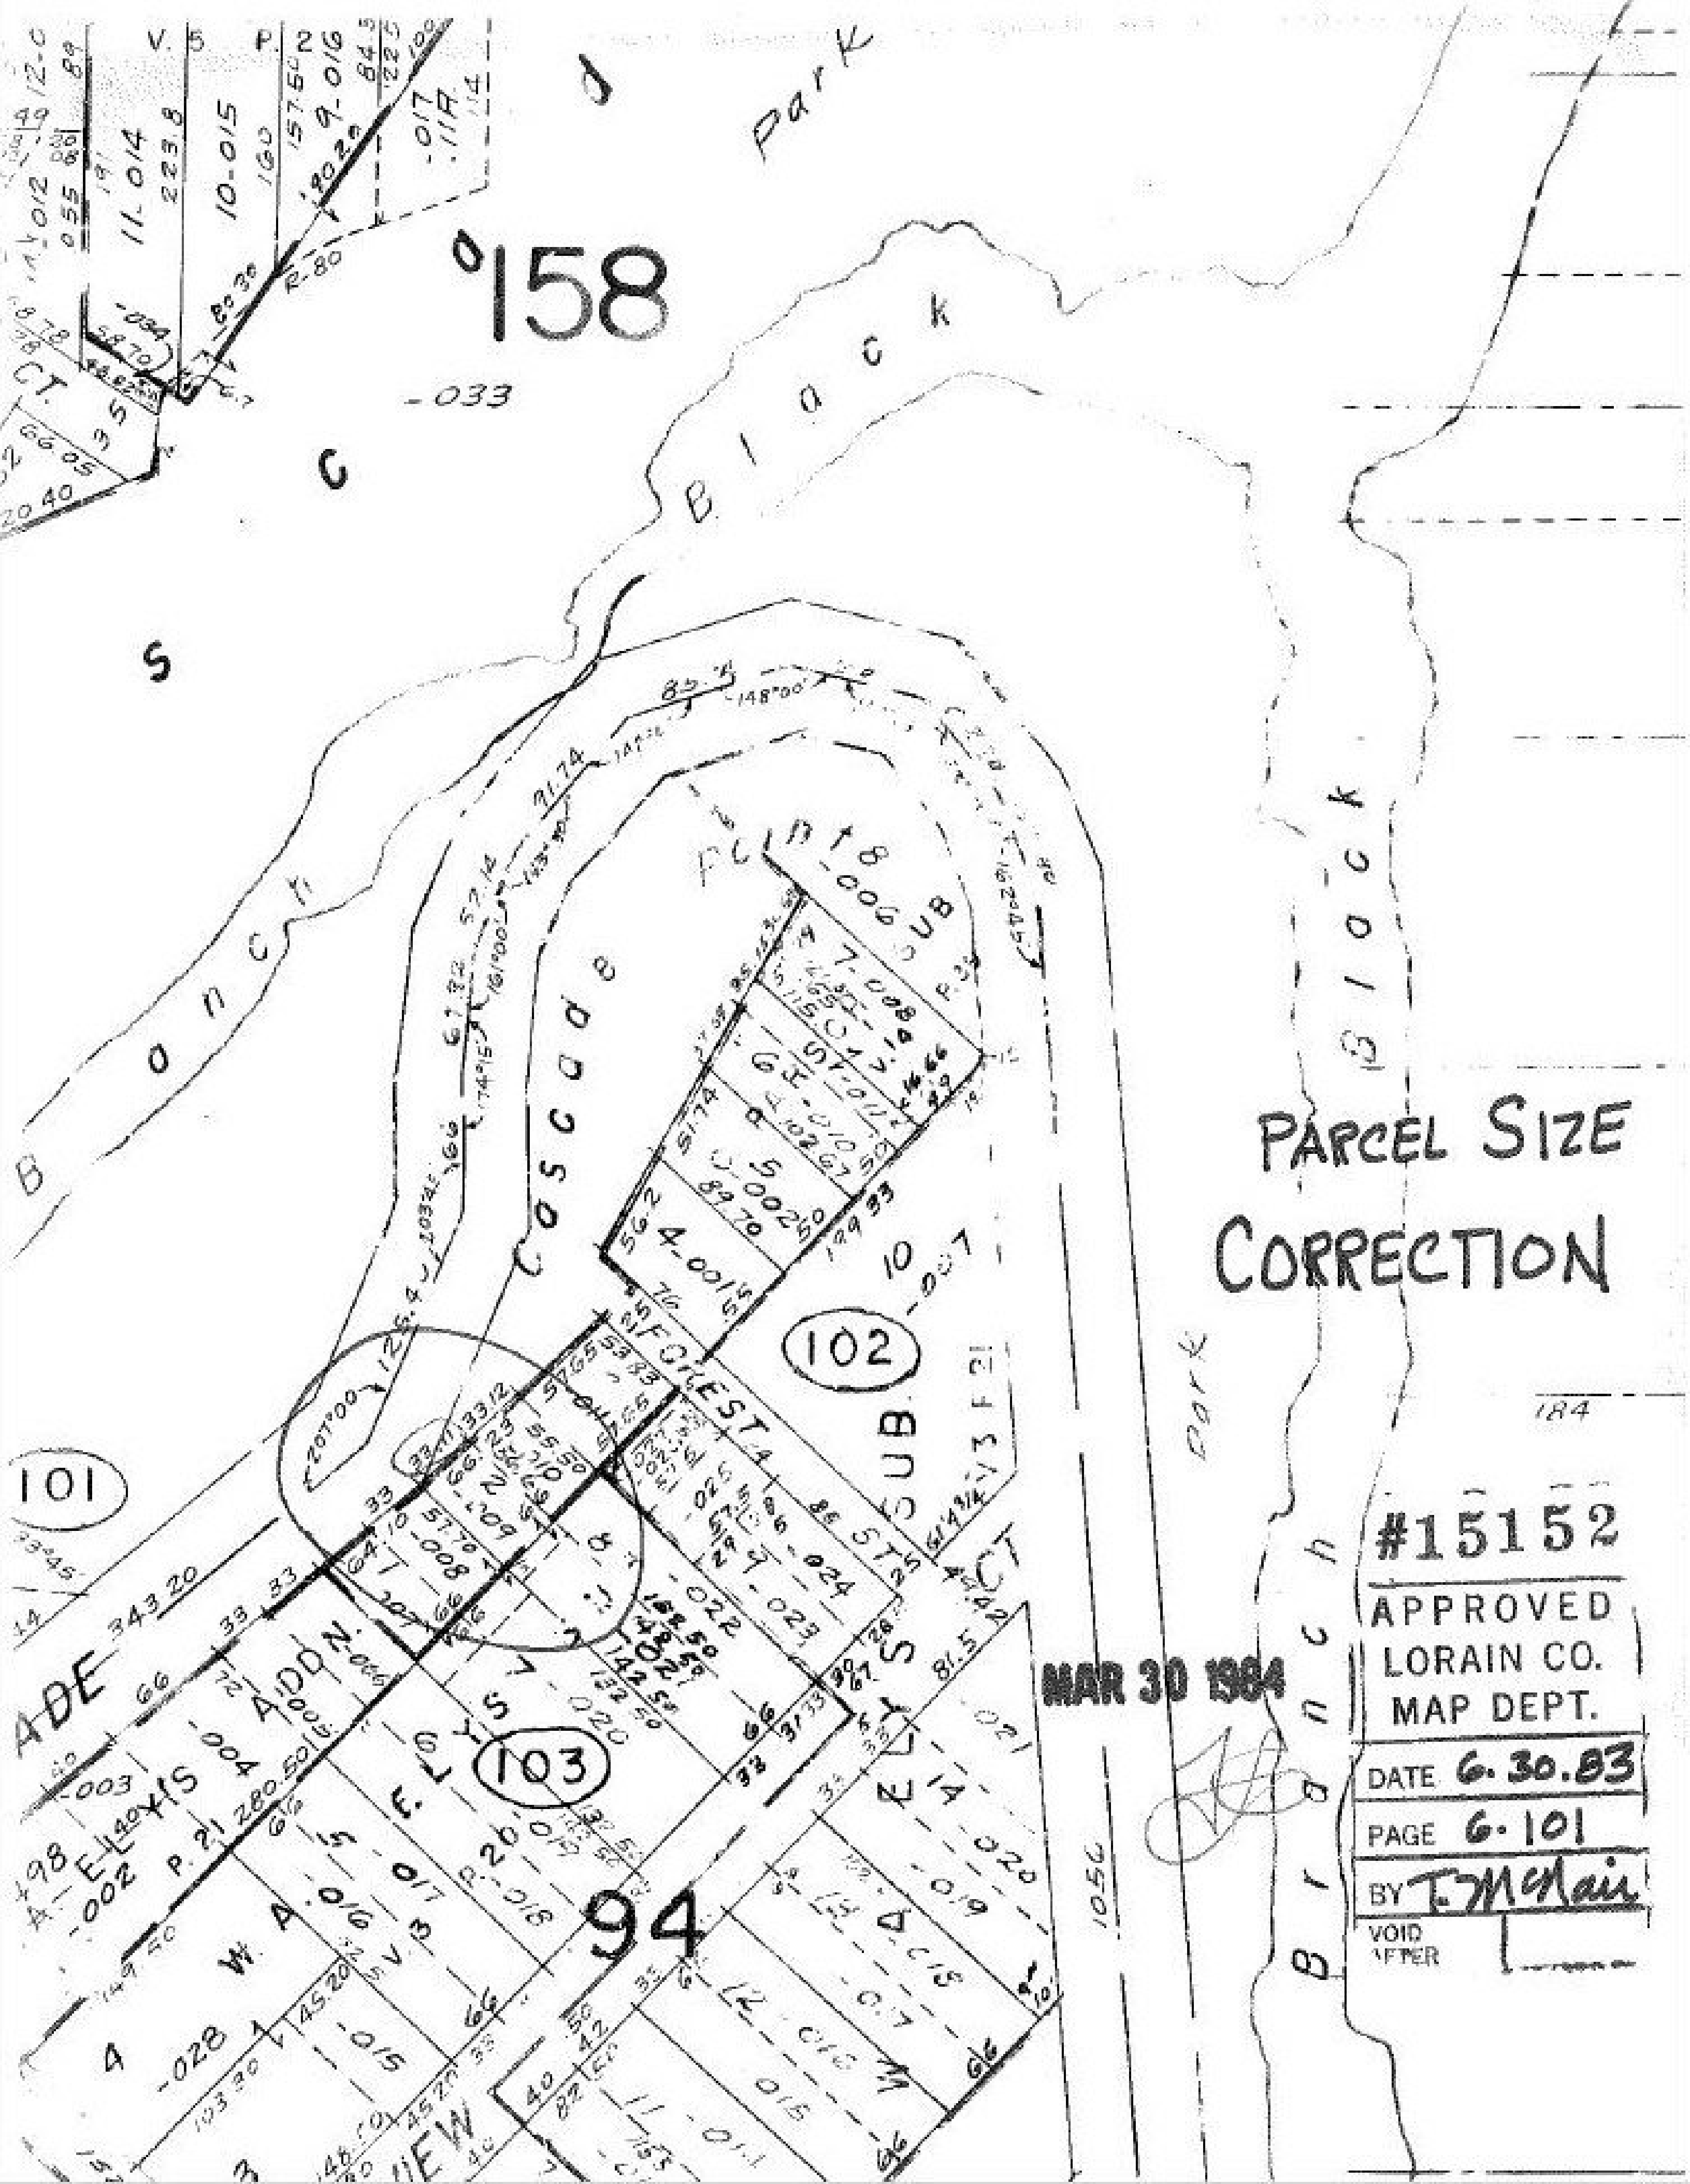

158
-033
Park
Black
Branch
Cascade Pointe
Forest
101
102
103
94
184
PARCEL SIZE
CORRECTION
MAR 30 1984
#15152
APPROVED
LORAIN CO.
MAP DEPT.
DATE 6.30.83
PAGE 6.101
BY T. McLain
VOID AFTER