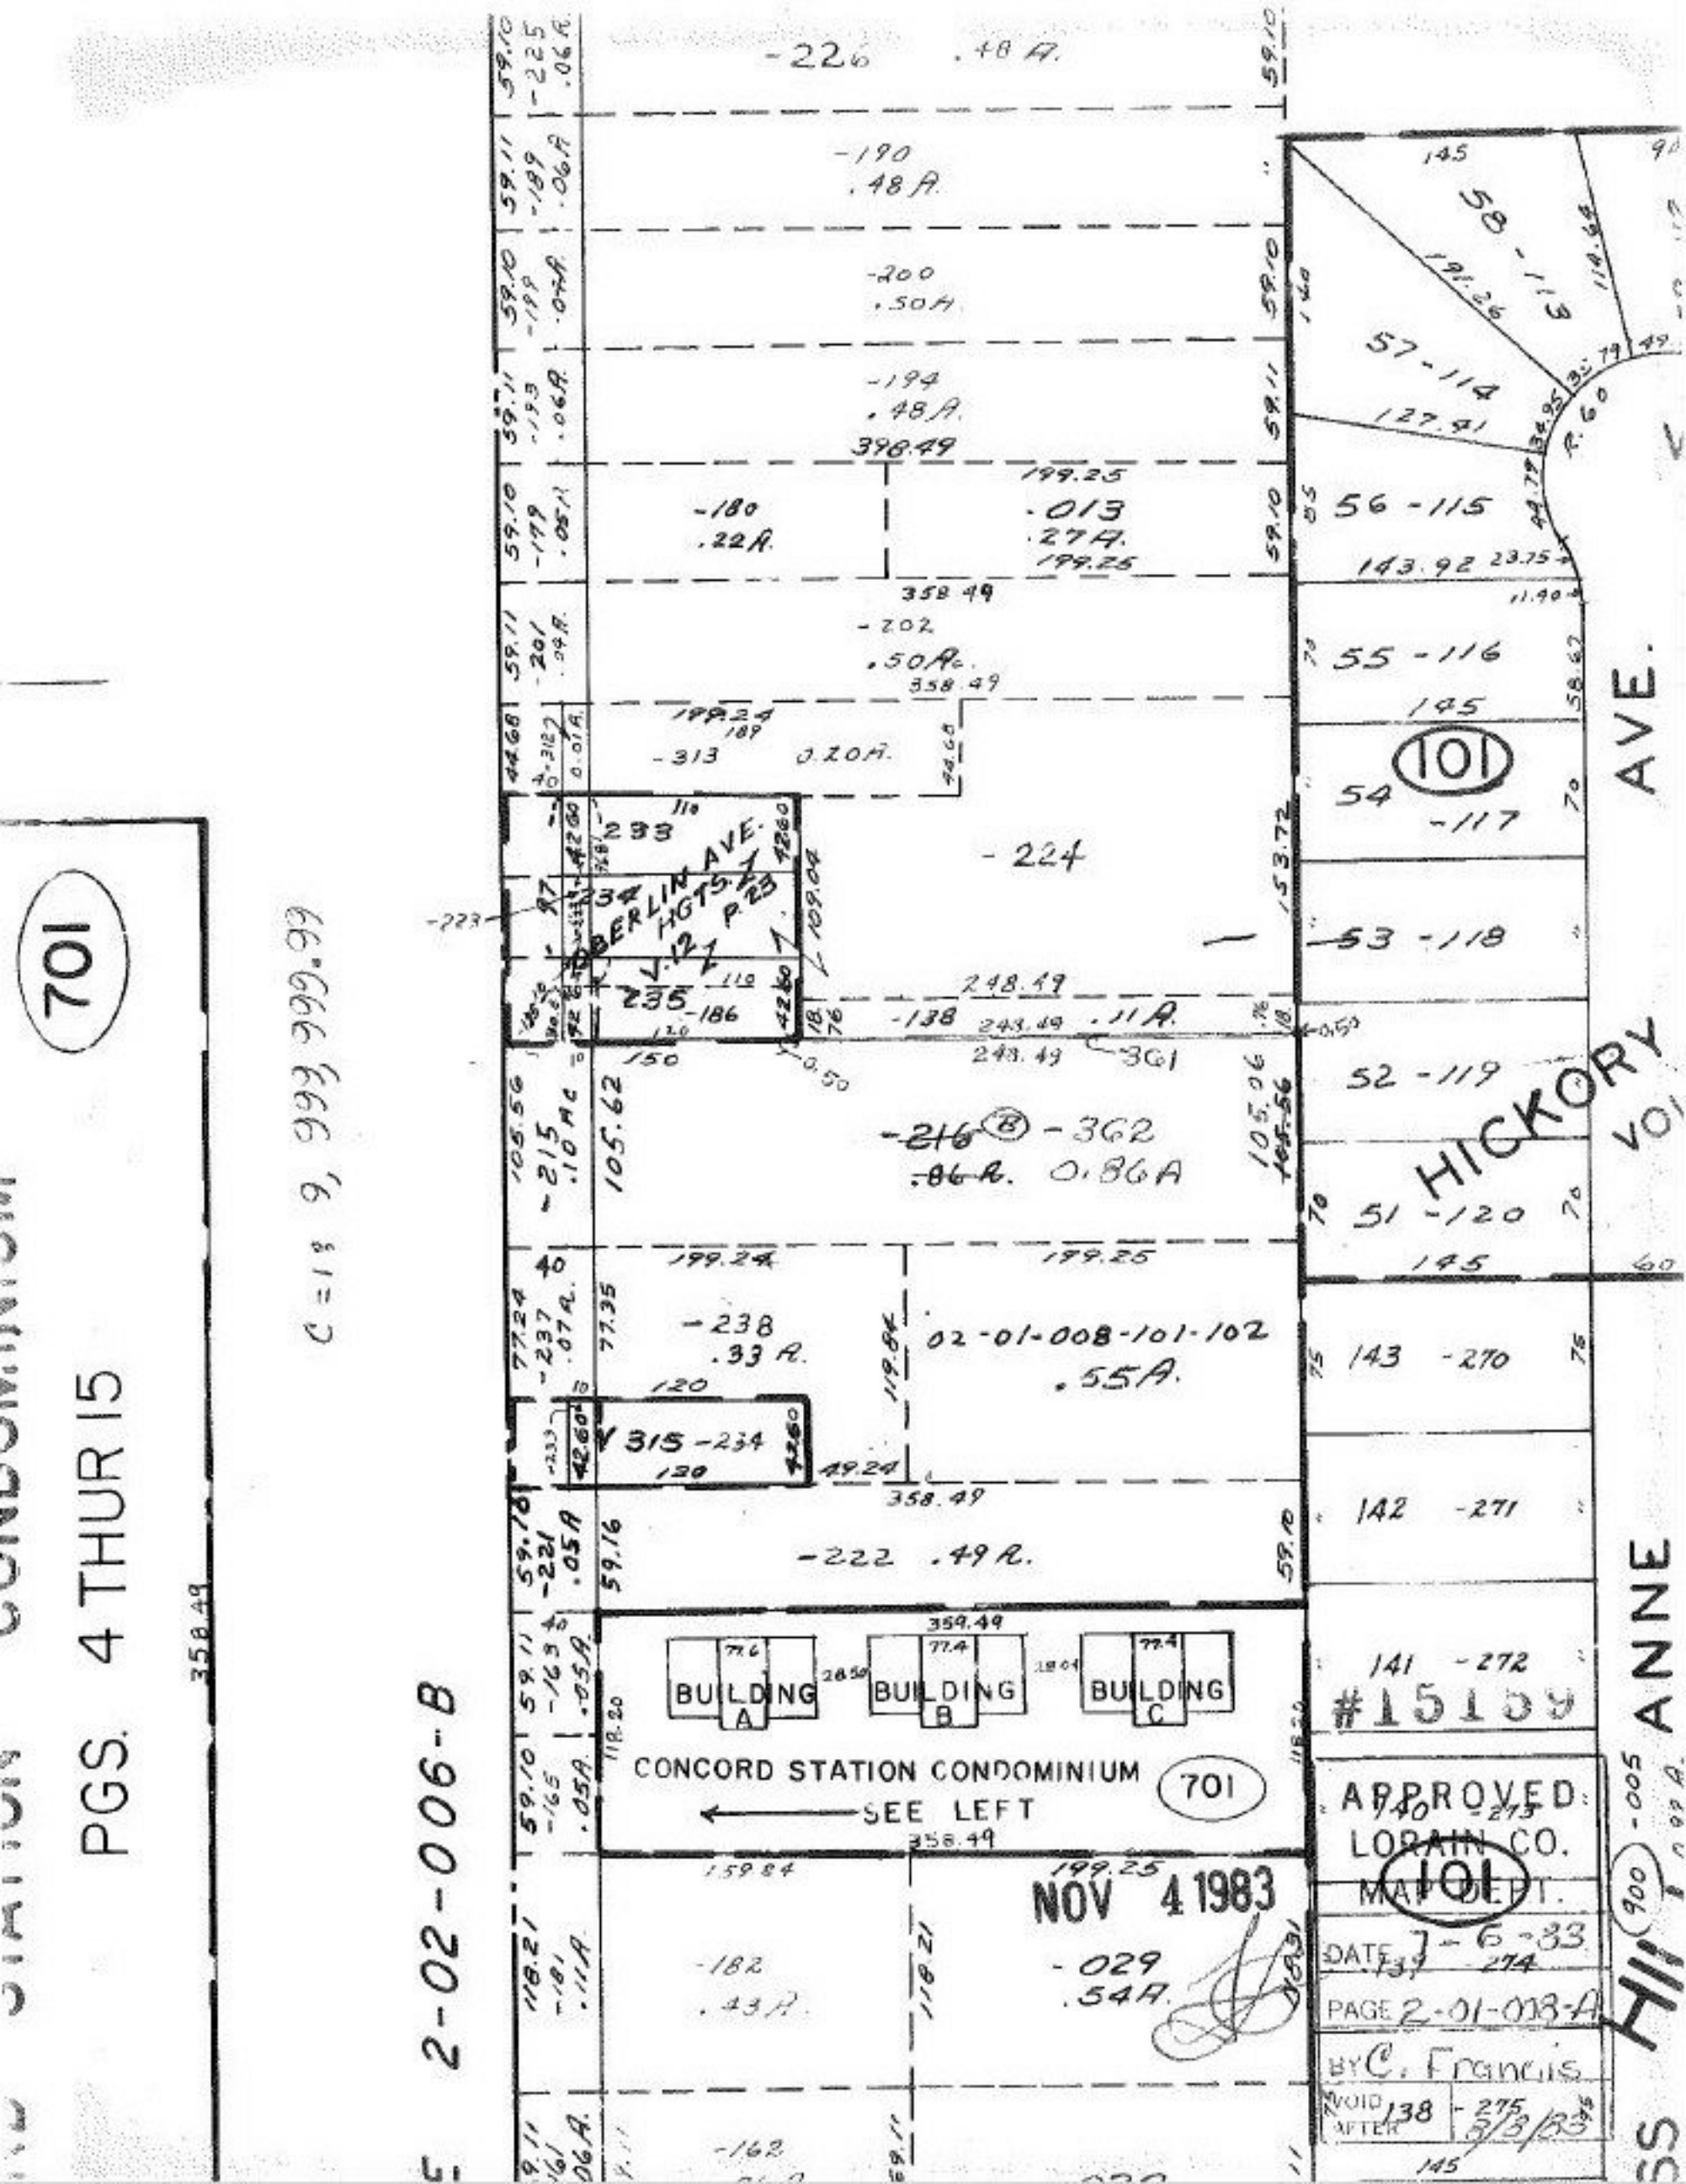

CONCORD STATION CONDOMINIUM
PGS. 4 THUR 15
701
C = 1: 9,999,999.99
2-02-006-B
BUILDING A
BUILDING B
BUILDING C
CONCORD STATION CONDOMINIUM
SEE LEFT
701
OBERLIN AVE. HGTS. V.12 P.23
HICKORY AVE.
ANNE
101
#15159
APPROVED
LORAIN CO.
MAP DEPT.
101
DATE 7-6-83
PAGE 2-01-008-A
BY C. Francis
VOID AFTER 8/8/83
NOV 4 1983