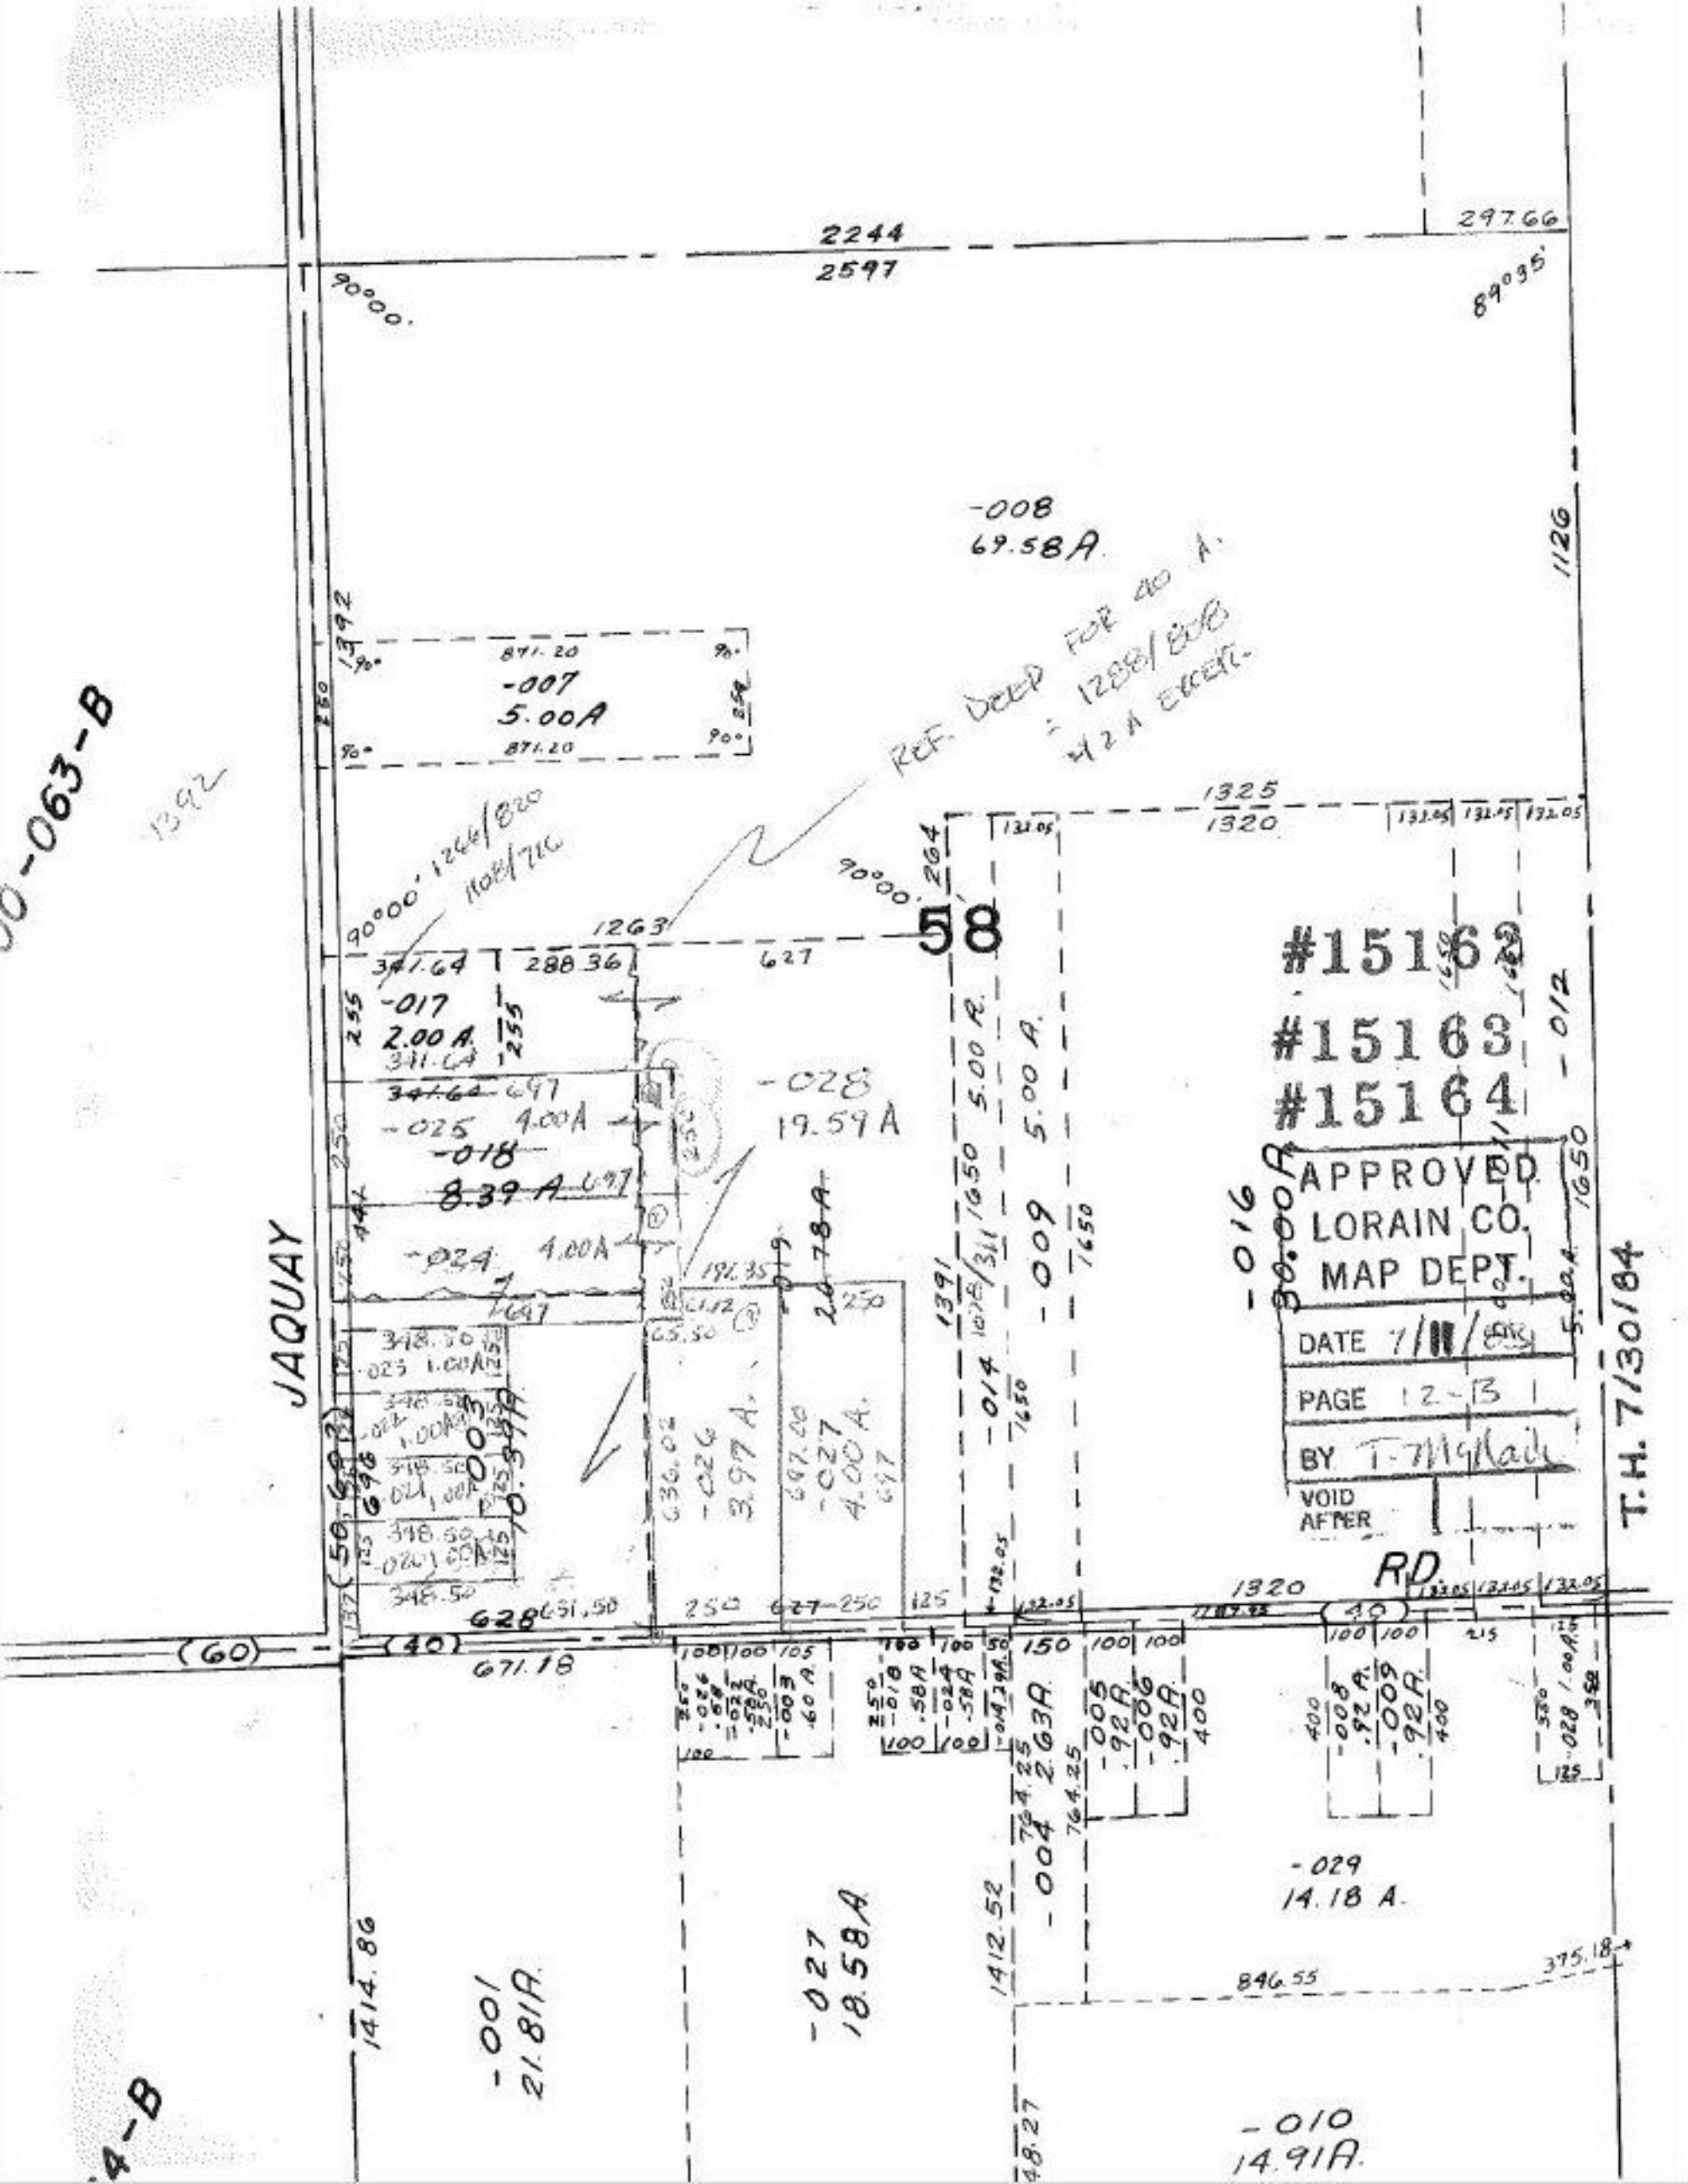


APPROVED
LORAIN CO.
MAP DEPT.
DATE 7/11/85
PAGE 12-13
BY T. McNair
VOID AFTER