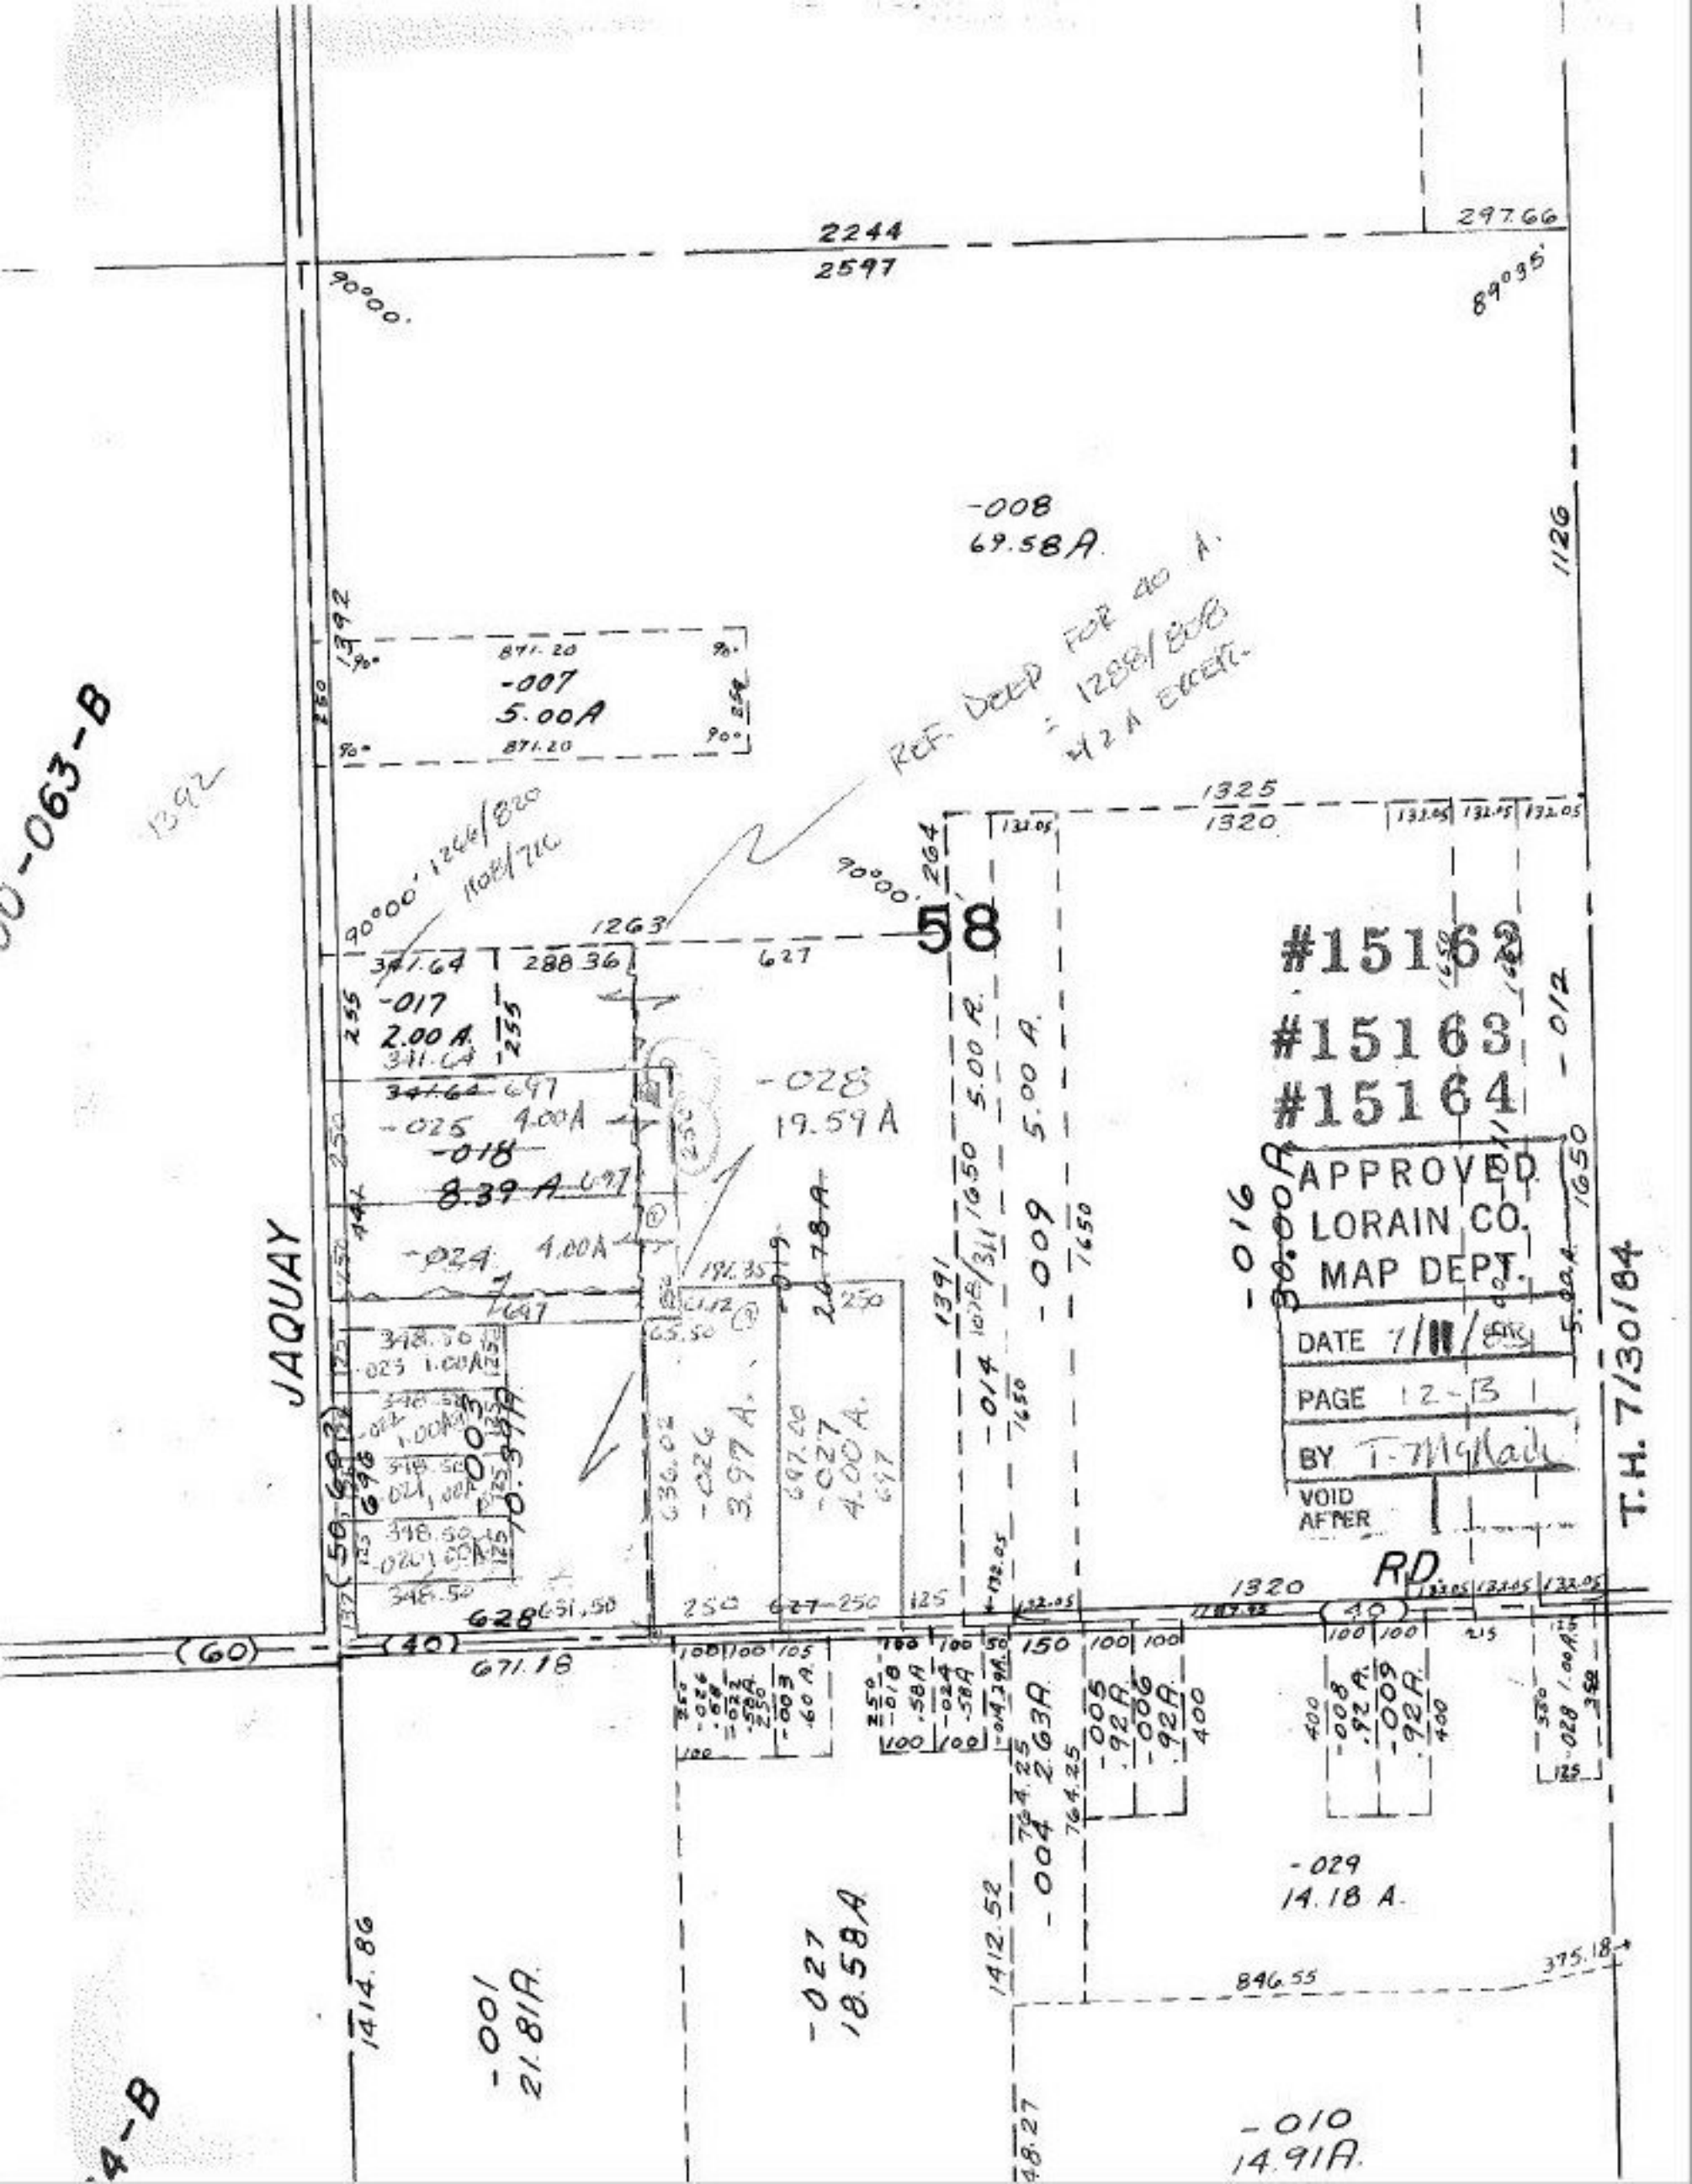

2244
2597
297.66
89°35'
90°00'
-008
69.58A
1126
1392
-007
5.00A
871.20
REF. DEED FOR 40 A.
= 1288/808
42 A EXCEPT.
-063-B
1392
1325
1320
90°00'
1266/820
1108/716
1263
58
627
341.64
288.36
-017
2.00 A.
-028
19.59 A
-025
4.00A
-018
8.39 A
-024
4.00A
JAQUAY
-016
30.00A
-009
5.00 A.
-014
-012
#15162
#15163
#15164
APPROVED
LORAIN CO.
MAP DEPT.
DATE 7/11/83
PAGE 12-13
BY T. McNair
VOID
AFTER
T.H. 7/30/84
RD
1320
628
671.18
(60)
(40)
-004
2.63A
-005
.92A
-006
.92A
-008
.92A
-009
.92A
-029
14.18 A.
846.55
375.18
1414.86
-001
21.81A
-027
18.58A
1412.52
-010
14.91A