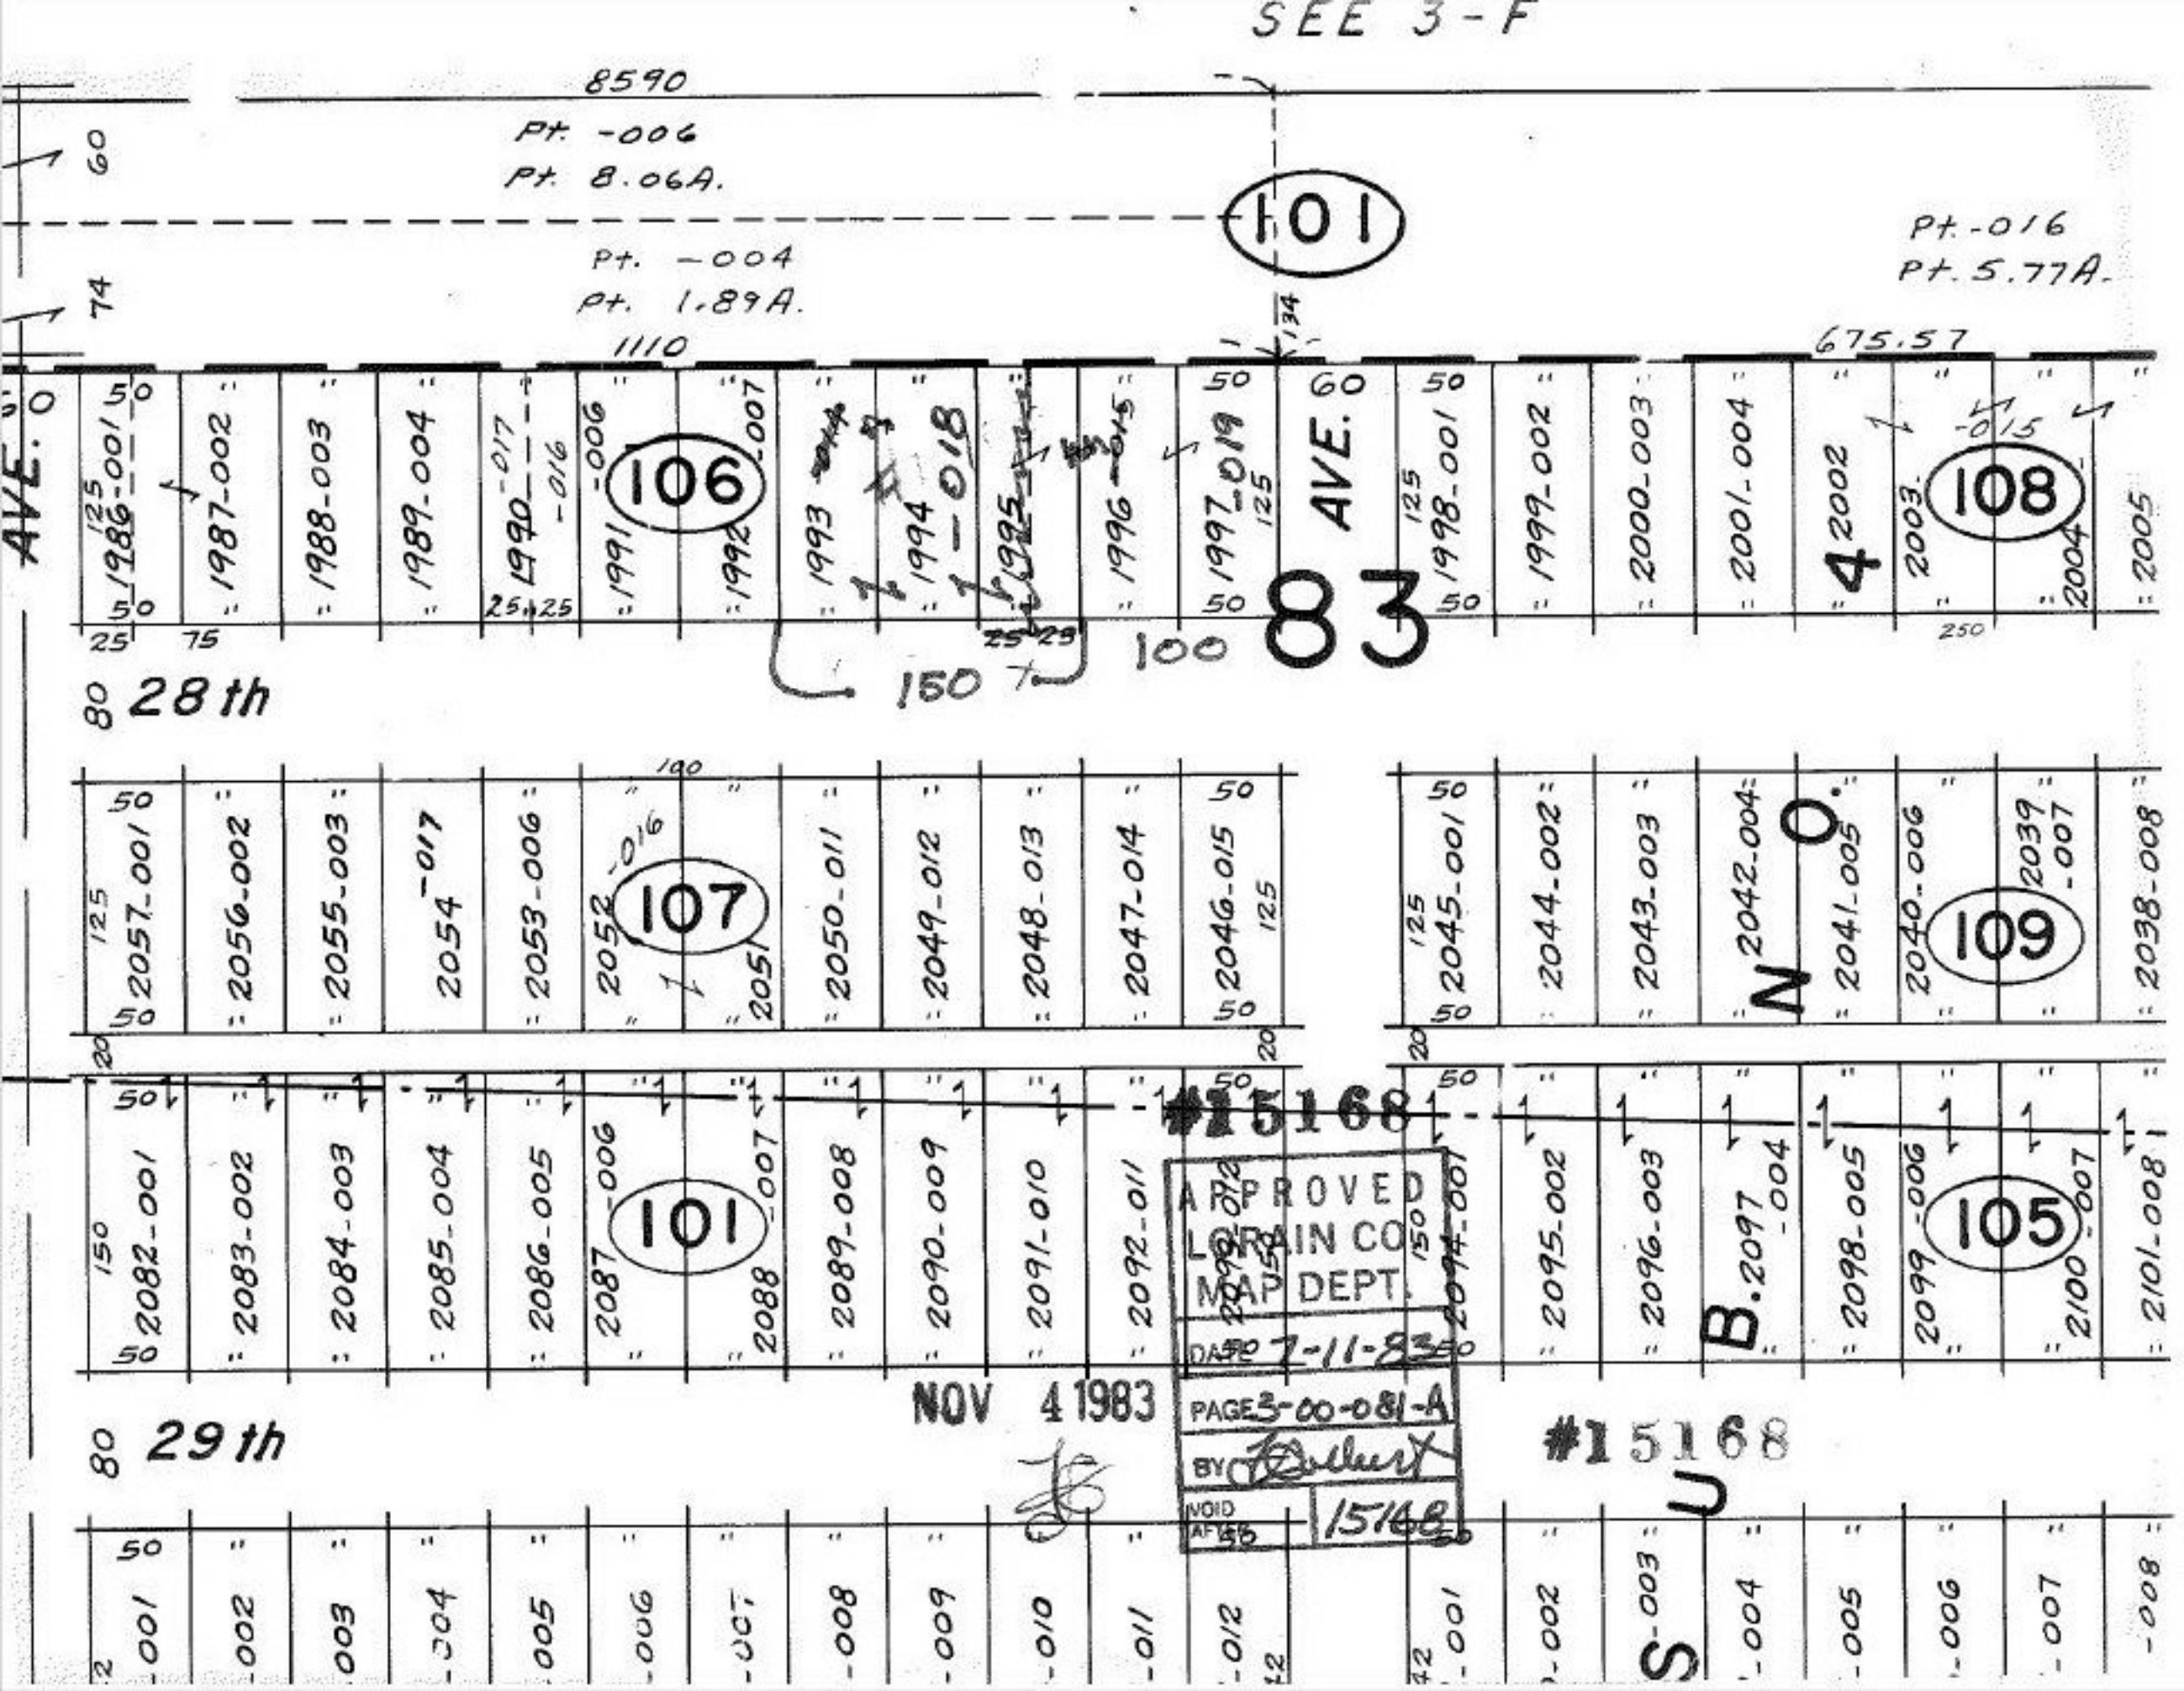
SEE 3-F
8590
Pt. -006
Pt. 8.06A.
Pt. -004
Pt. 1.89A.
Pt. -016
Pt. 5.77A.
101
106
107
108
109
105
AVE.
AVE.
83
28th
29th
#15168
APPROVED
LORAIN CO
MAP DEPT.
DATE 7-11-83
PAGE 3-00-081-A
BY
VOID AFTER 15168
NOV 4 1983
#15168