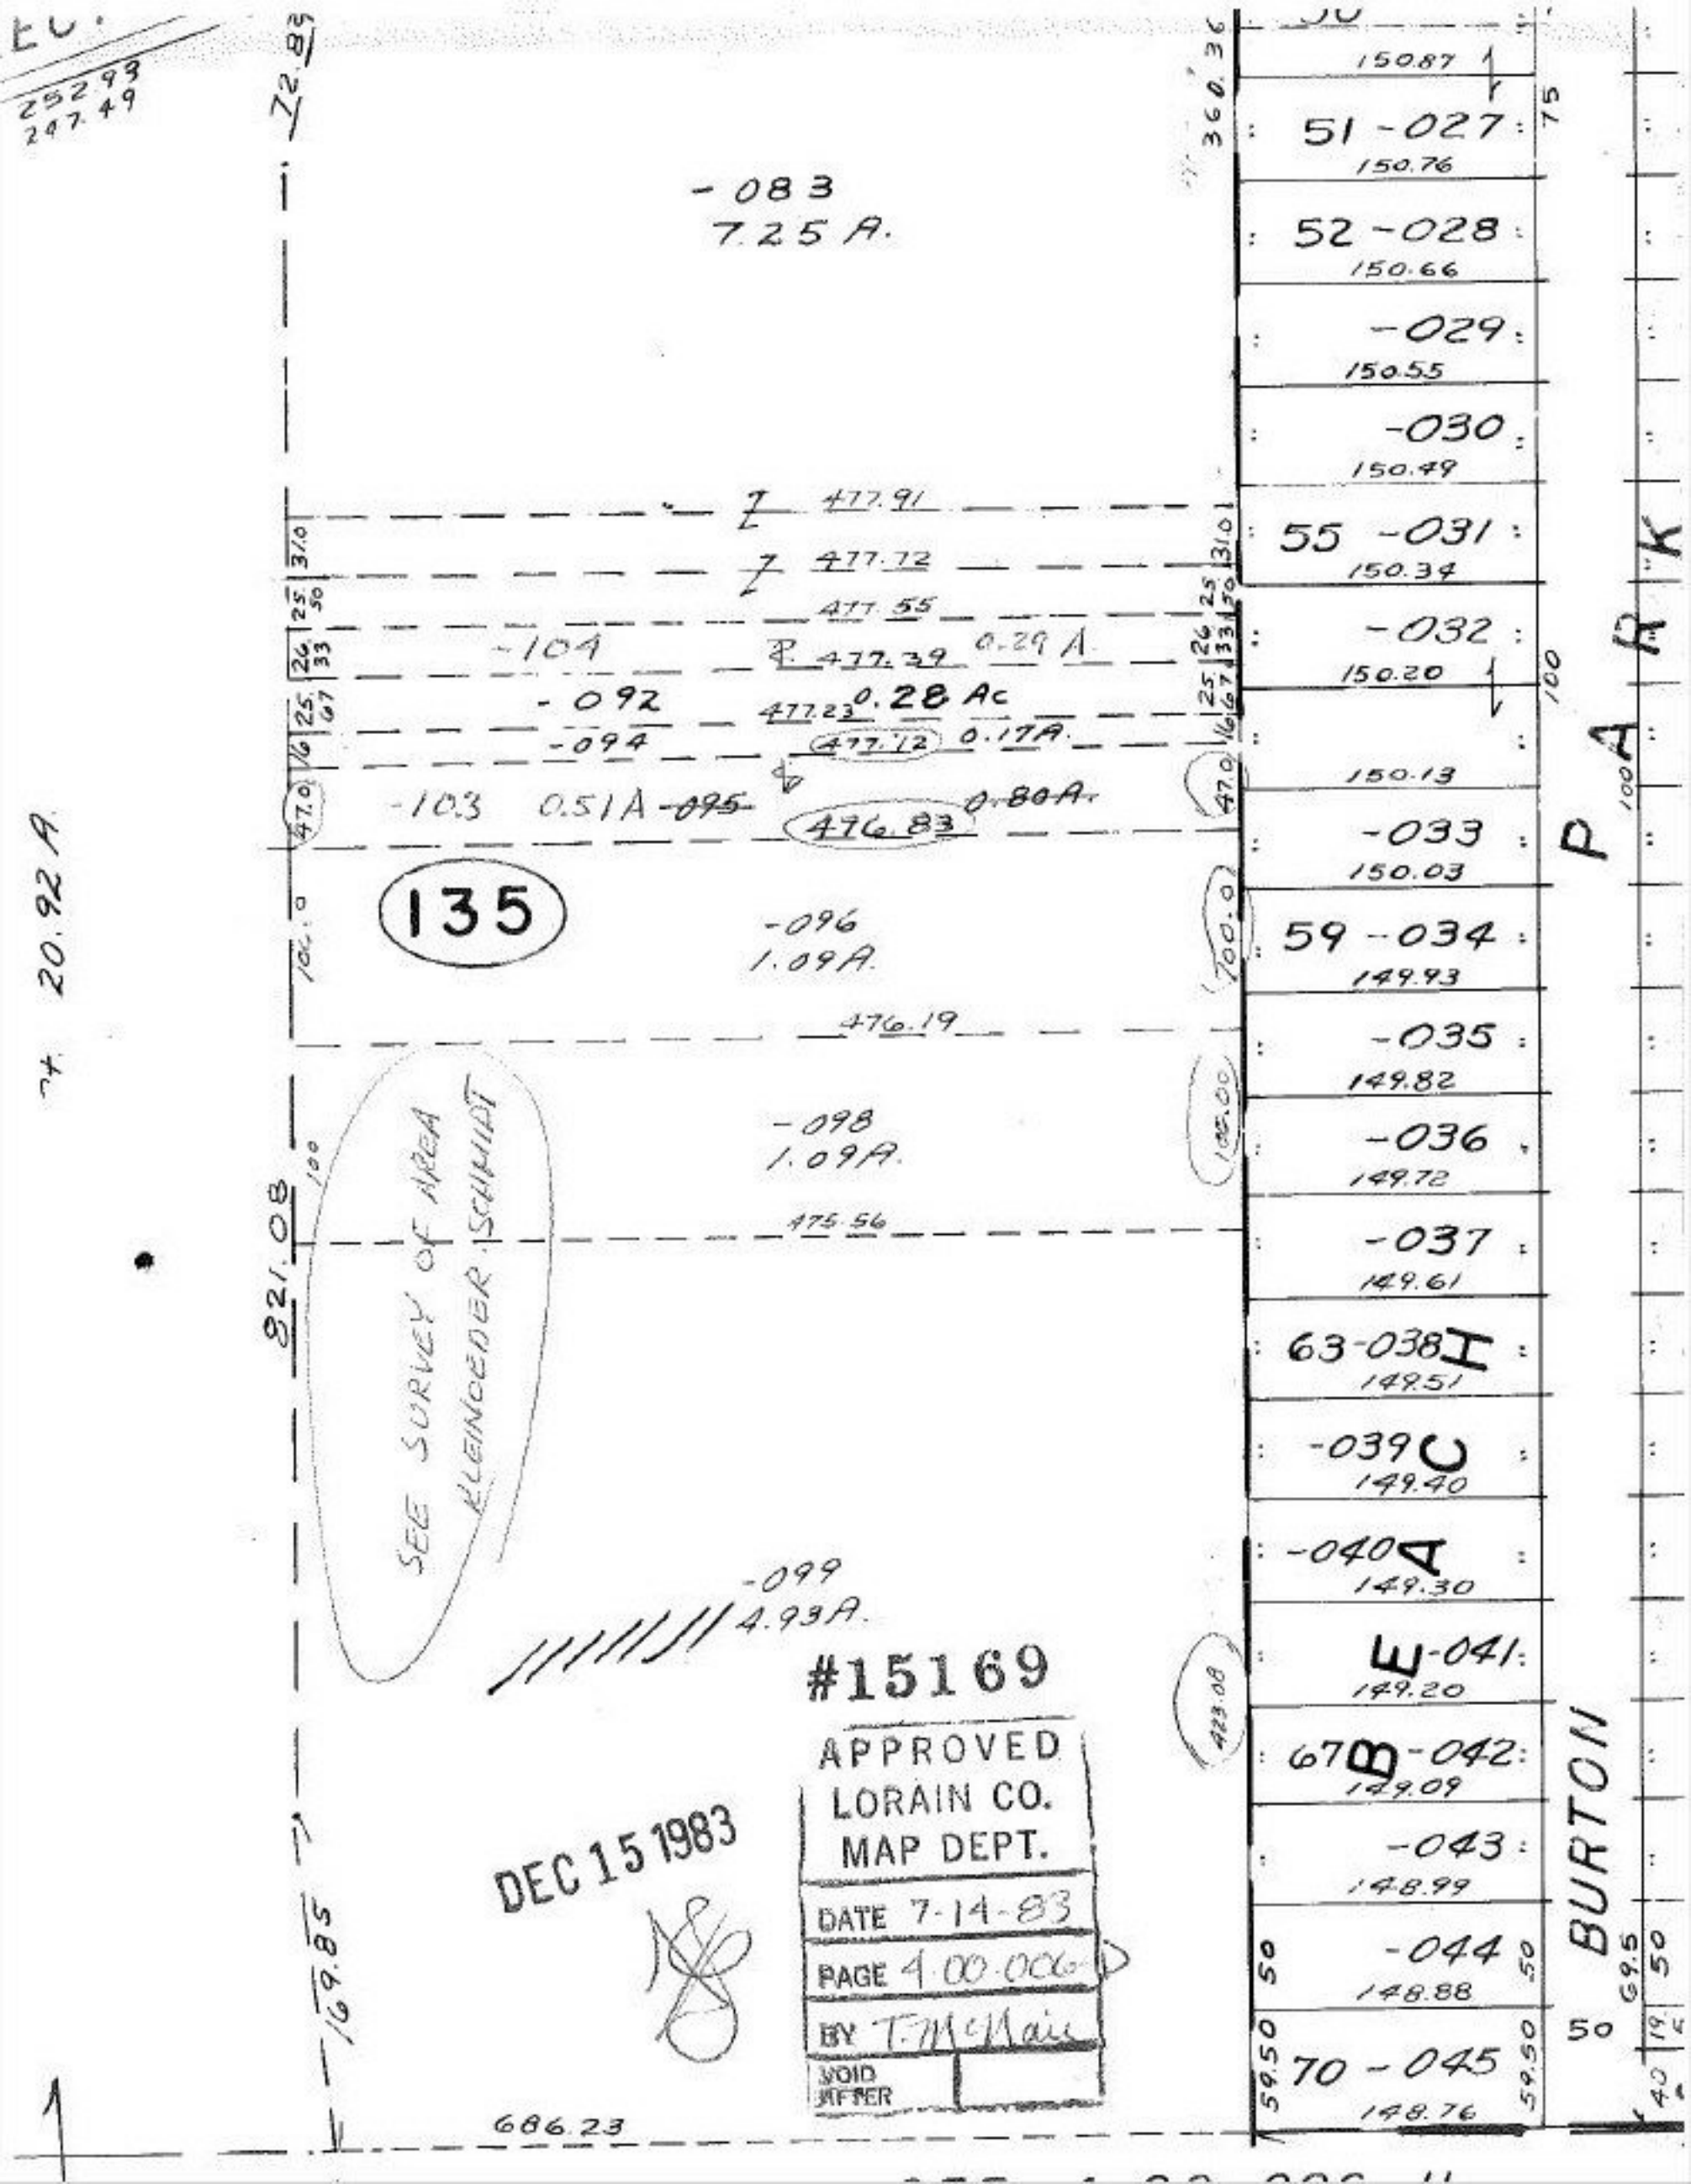

252.93
247.49
72.89
-083
7.25 A.
477.91
477.72
477.55
-104
477.39
0.29 A
-092
477.23
0.28 Ac
-094
477.12
0.17A.
-103
0.51A
476.83
0.80A.
135
-096
1.09A.
476.19
-098
1.09A.
475.56
821.08
SEE SURVEY OF AREA
KLEINOEDER SCHMIDT
-099
4.93A.
#15169
APPROVED
LORAIN CO.
MAP DEPT.
DATE 7-14-83
PAGE 4.00.006
BY T. McNair
VOID AFTER
DEC 15 1983
169.85
686.23
20.92 A
360.36
150.87
51-027
150.76
52-028
150.66
-029
150.55
-030
150.49
55-031
150.34
-032
150.20
150.13
-033
150.03
59-034
149.93
-035
149.82
-036
149.72
-037
149.61
63-038H
149.51
-039C
149.40
-040A
149.30
E-041
149.20
67B-042
149.09
-043
148.99
-044
148.88
70-045
148.76
PARK
BURTON