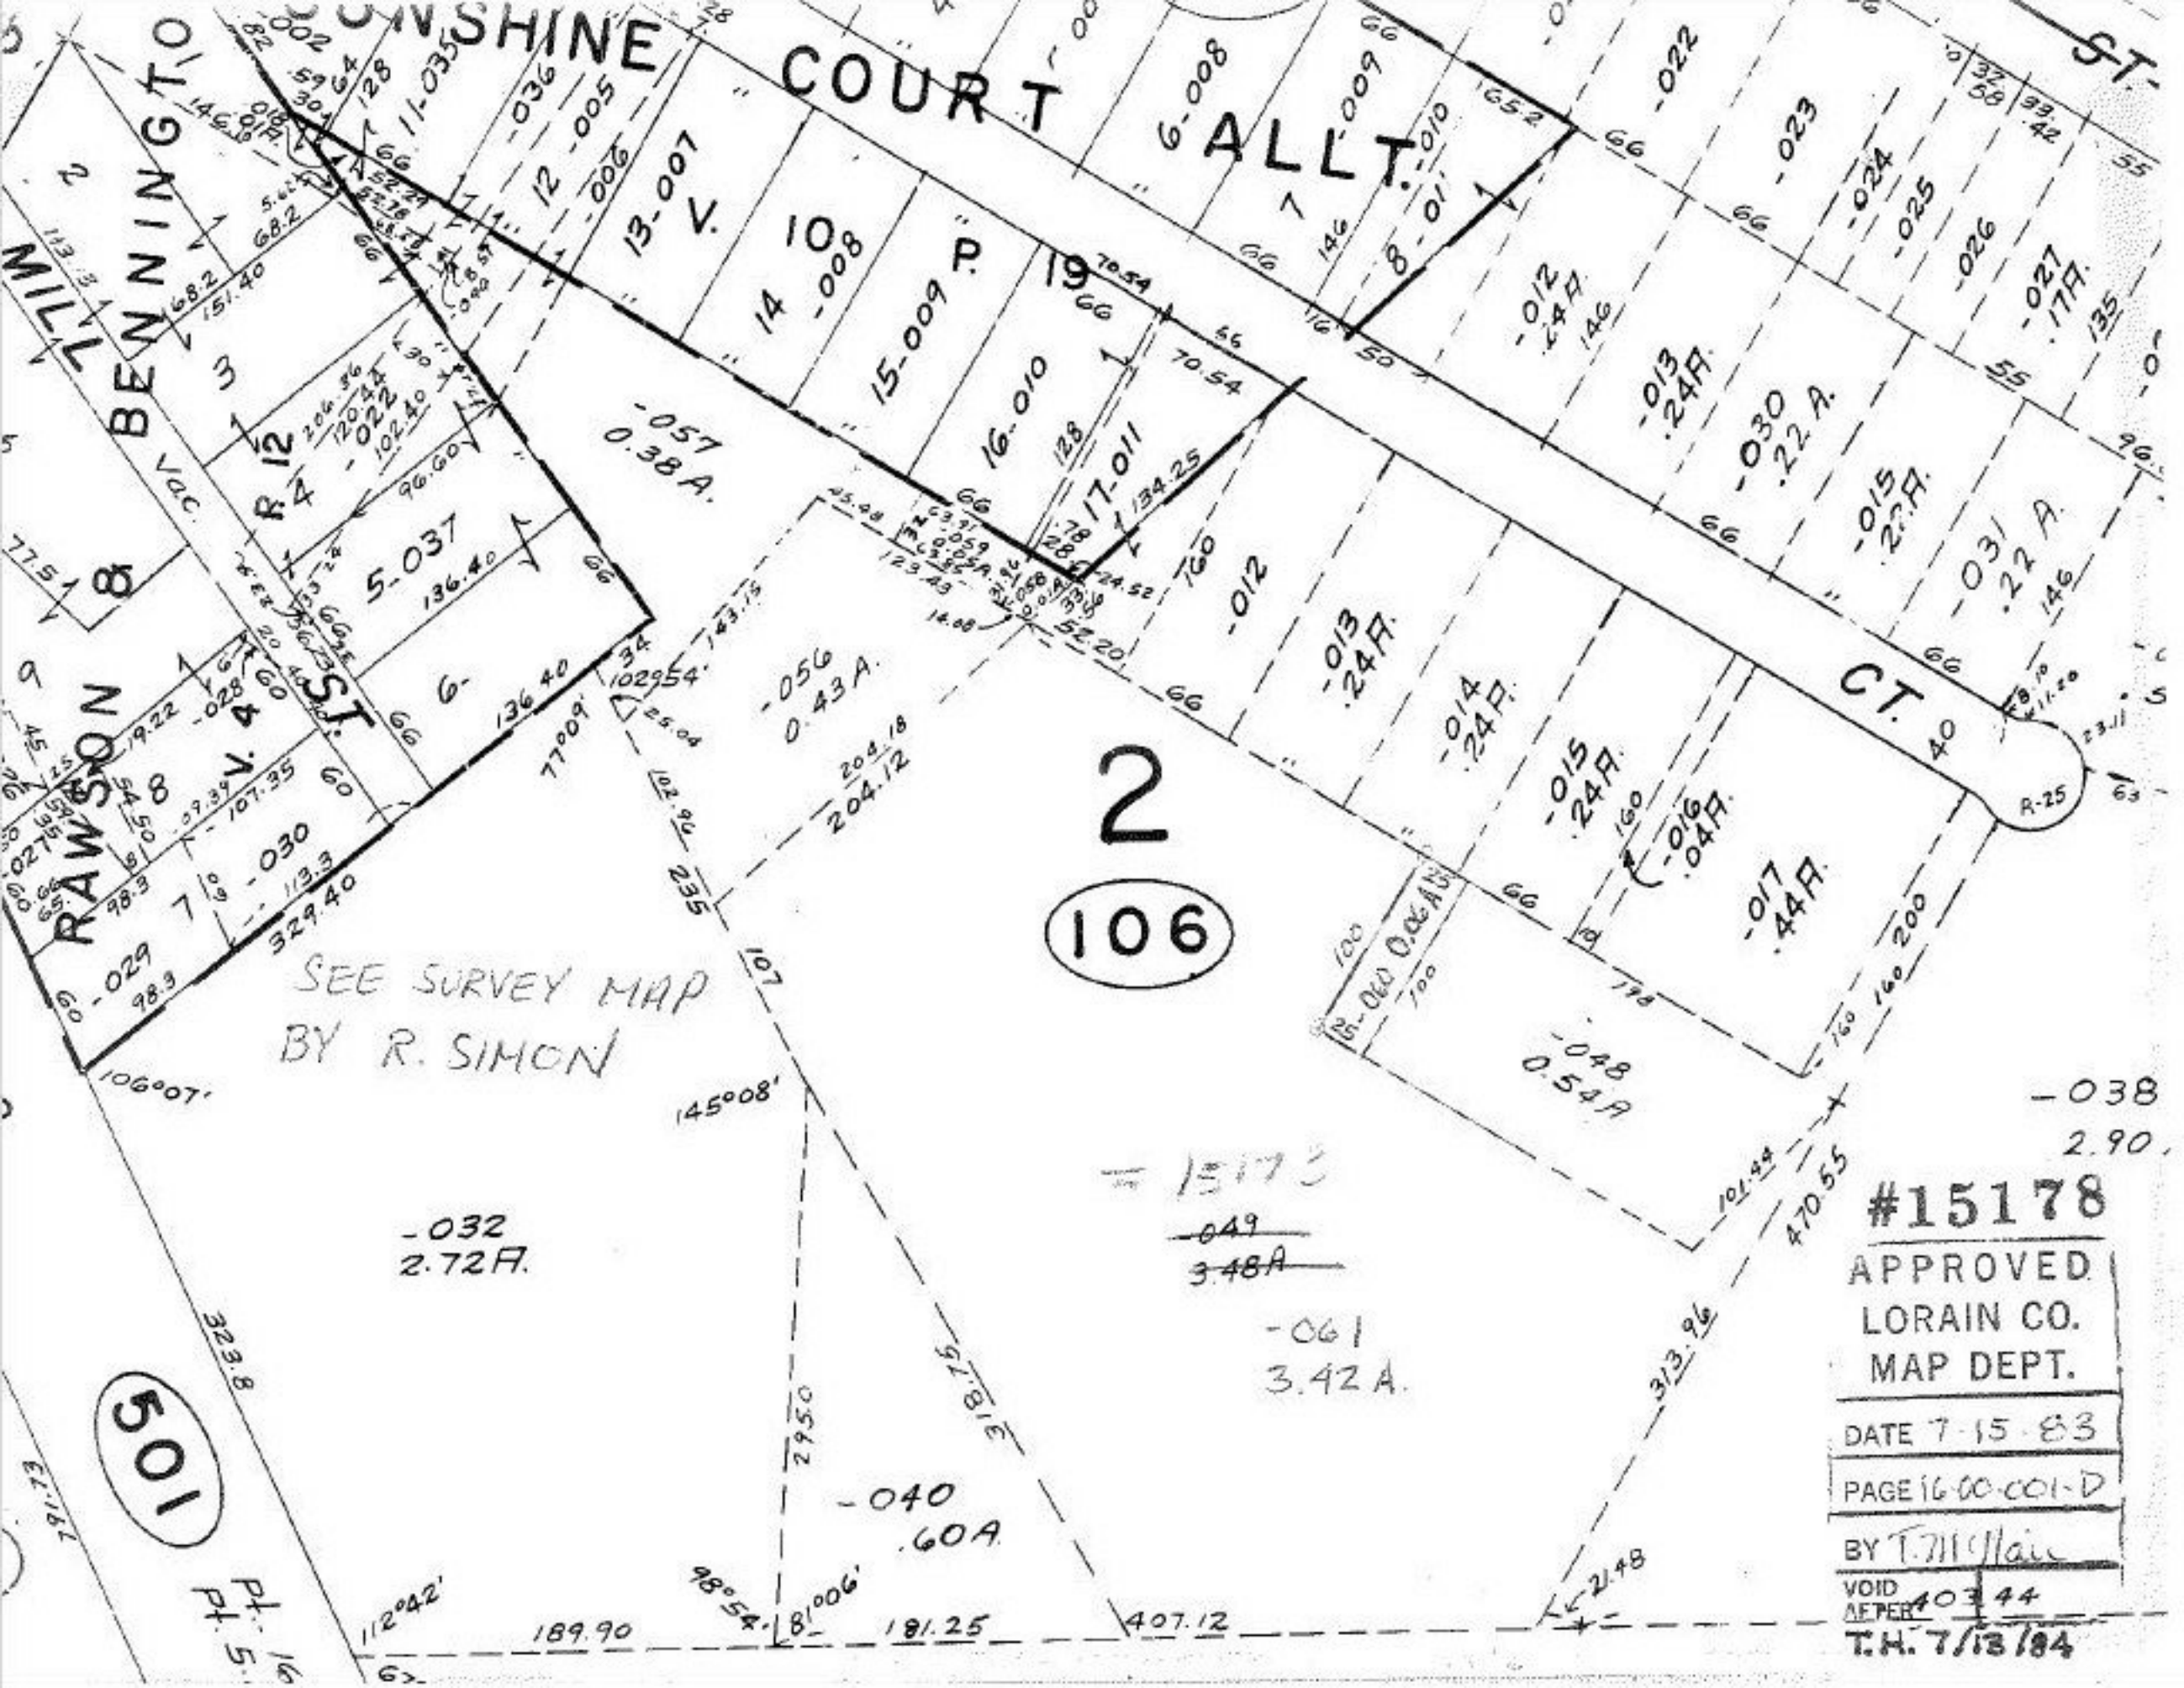

SUNSHINE COURT ALLT.
BENNINGTON
MILL
RAWSON
ST.
CT.
2
106
501
SEE SURVEY MAP
BY R. SIMON
-057
0.38 A.
-056
0.43 A.
-032
2.72 A.
-040
.60 A.
-061
3.42 A.
-048
0.54 A
-038
2.90
#15178
APPROVED
LORAIN CO.
MAP DEPT.
DATE 7-15-83
PAGE 16-00-001-D
BY T. McNair
VOID AFTER 403 44
T.H. 7/13/84