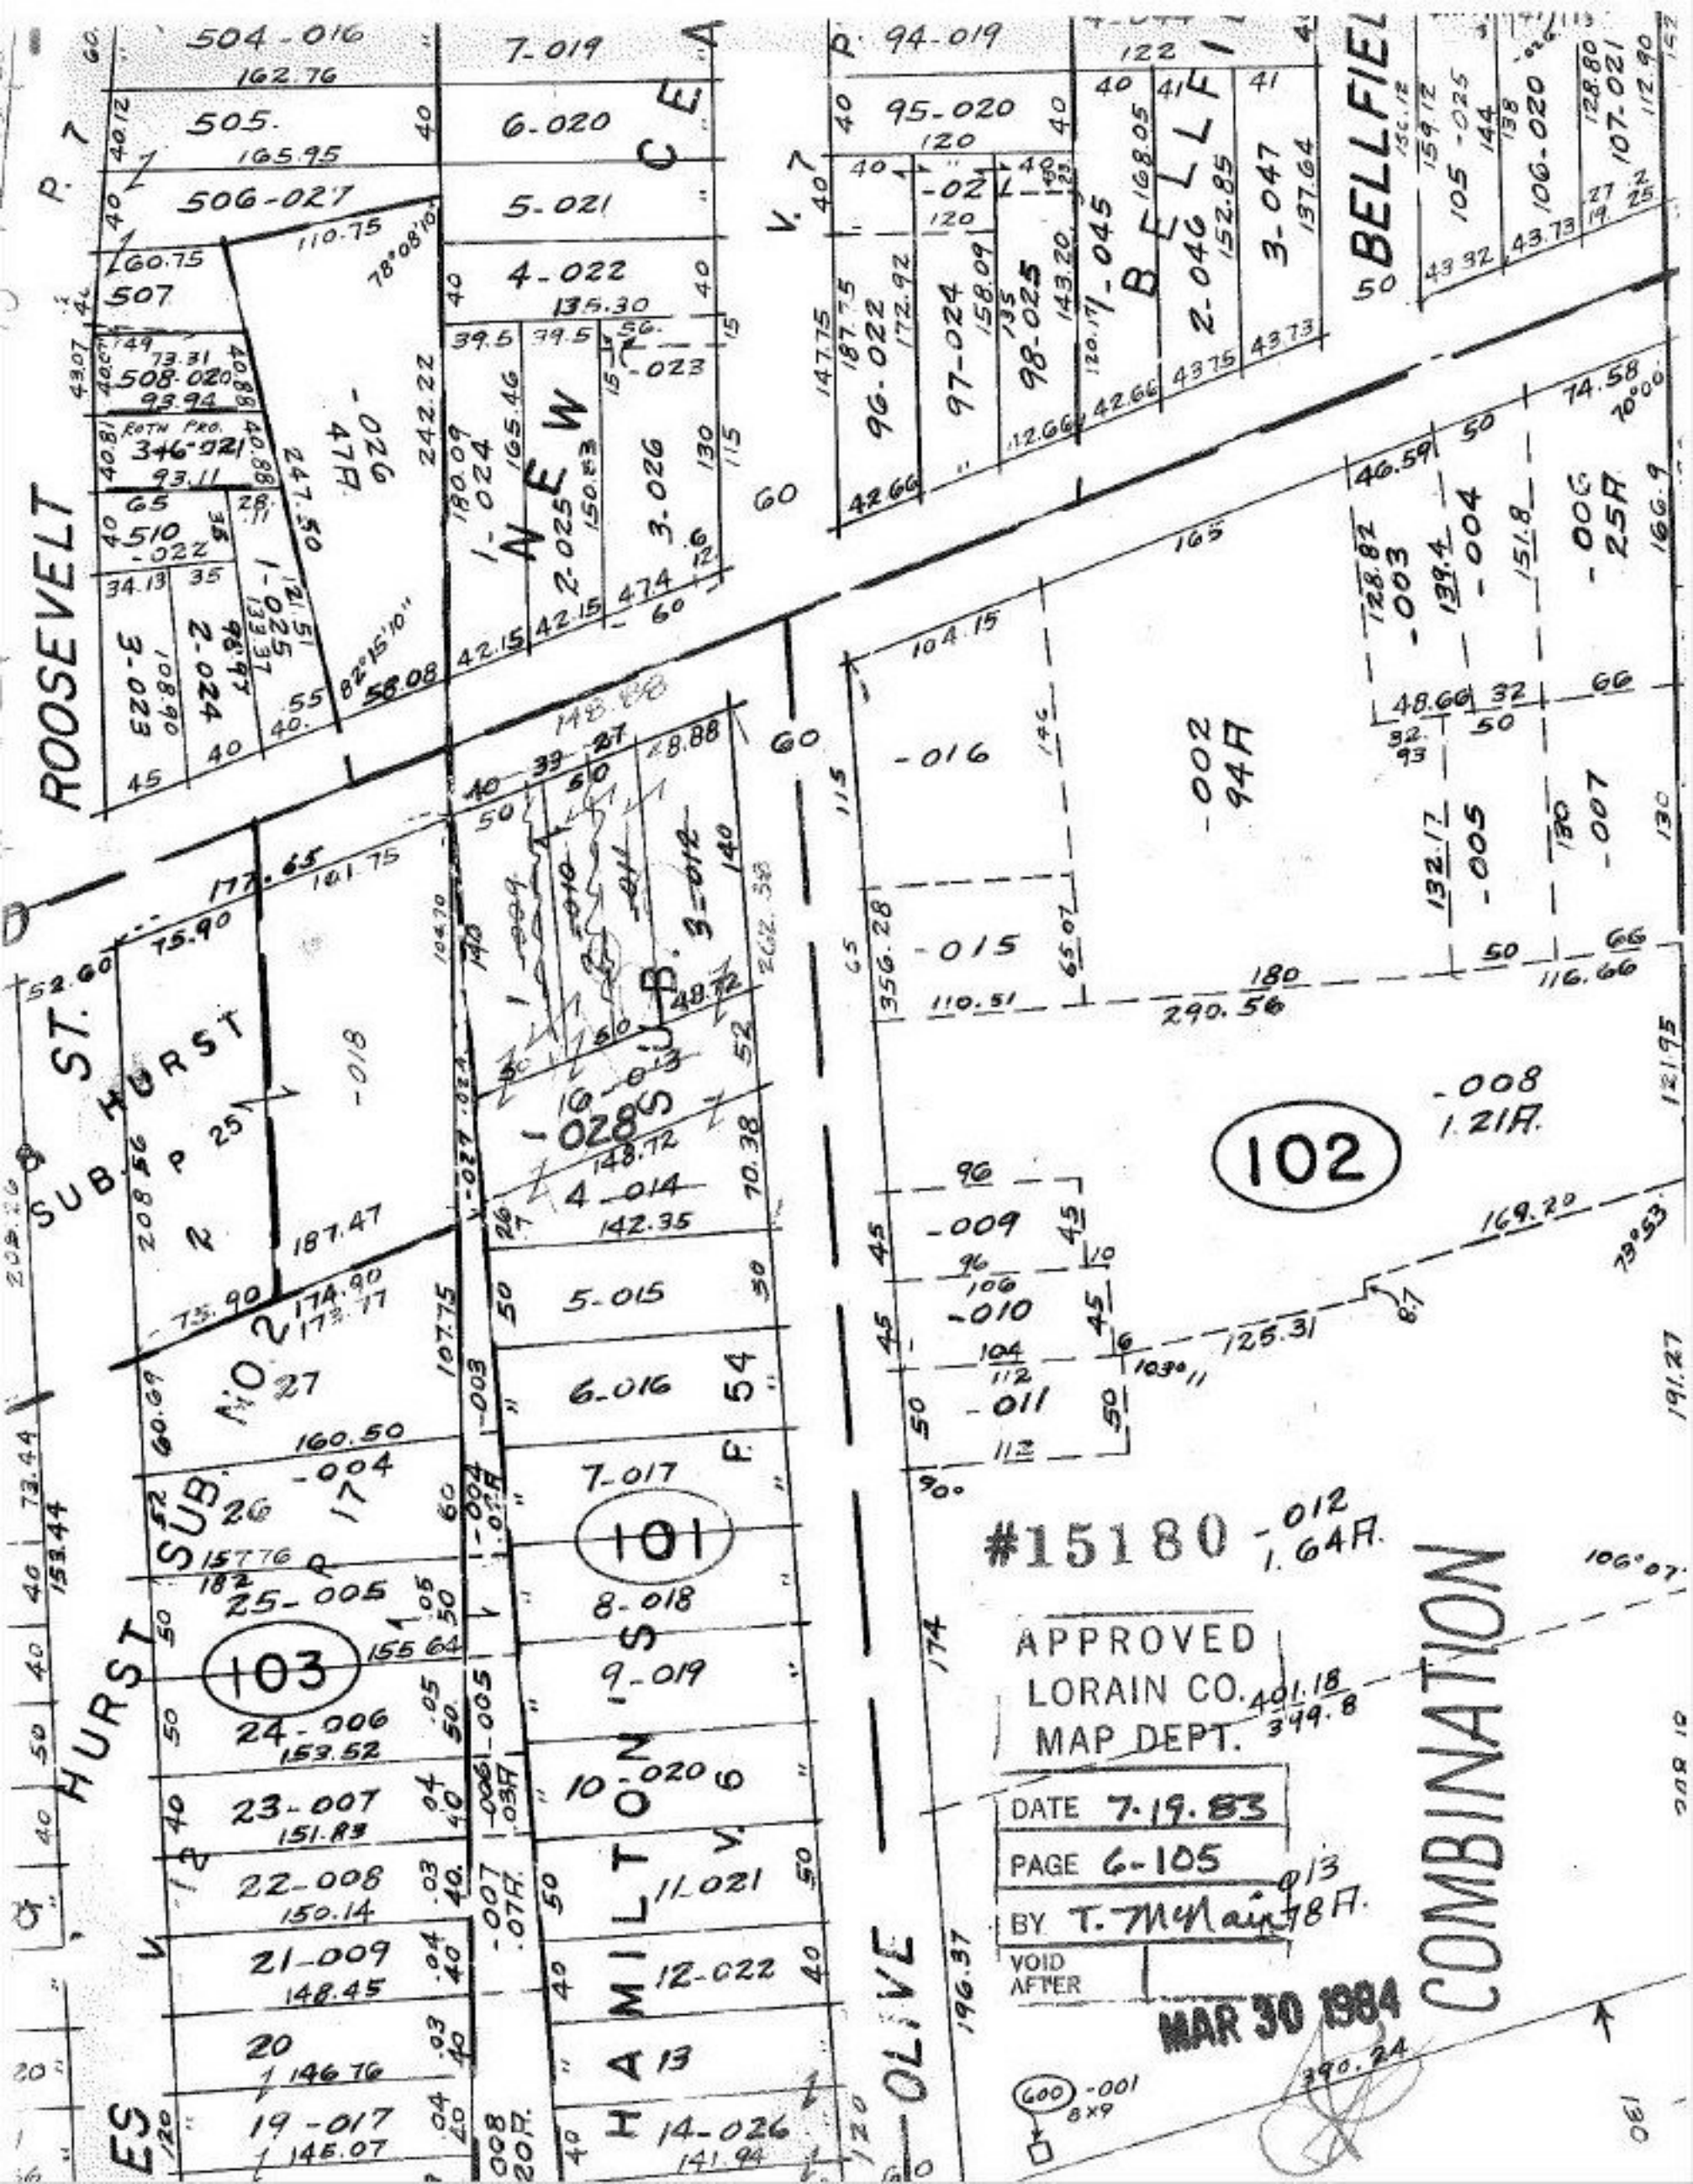
ROOSEVELT
HURST SUB. NO 2
HURST SUB. NO 2
HAMILTON'S
OLIVE
BELLFIELD
NEW CEA
102
101
103
#15180
APPROVED
LORAIN CO.
MAP DEPT.
DATE 7.19.83
PAGE 6-105
BY T. McNair
VOID AFTER
MAR 30 1984
COMBINATION